
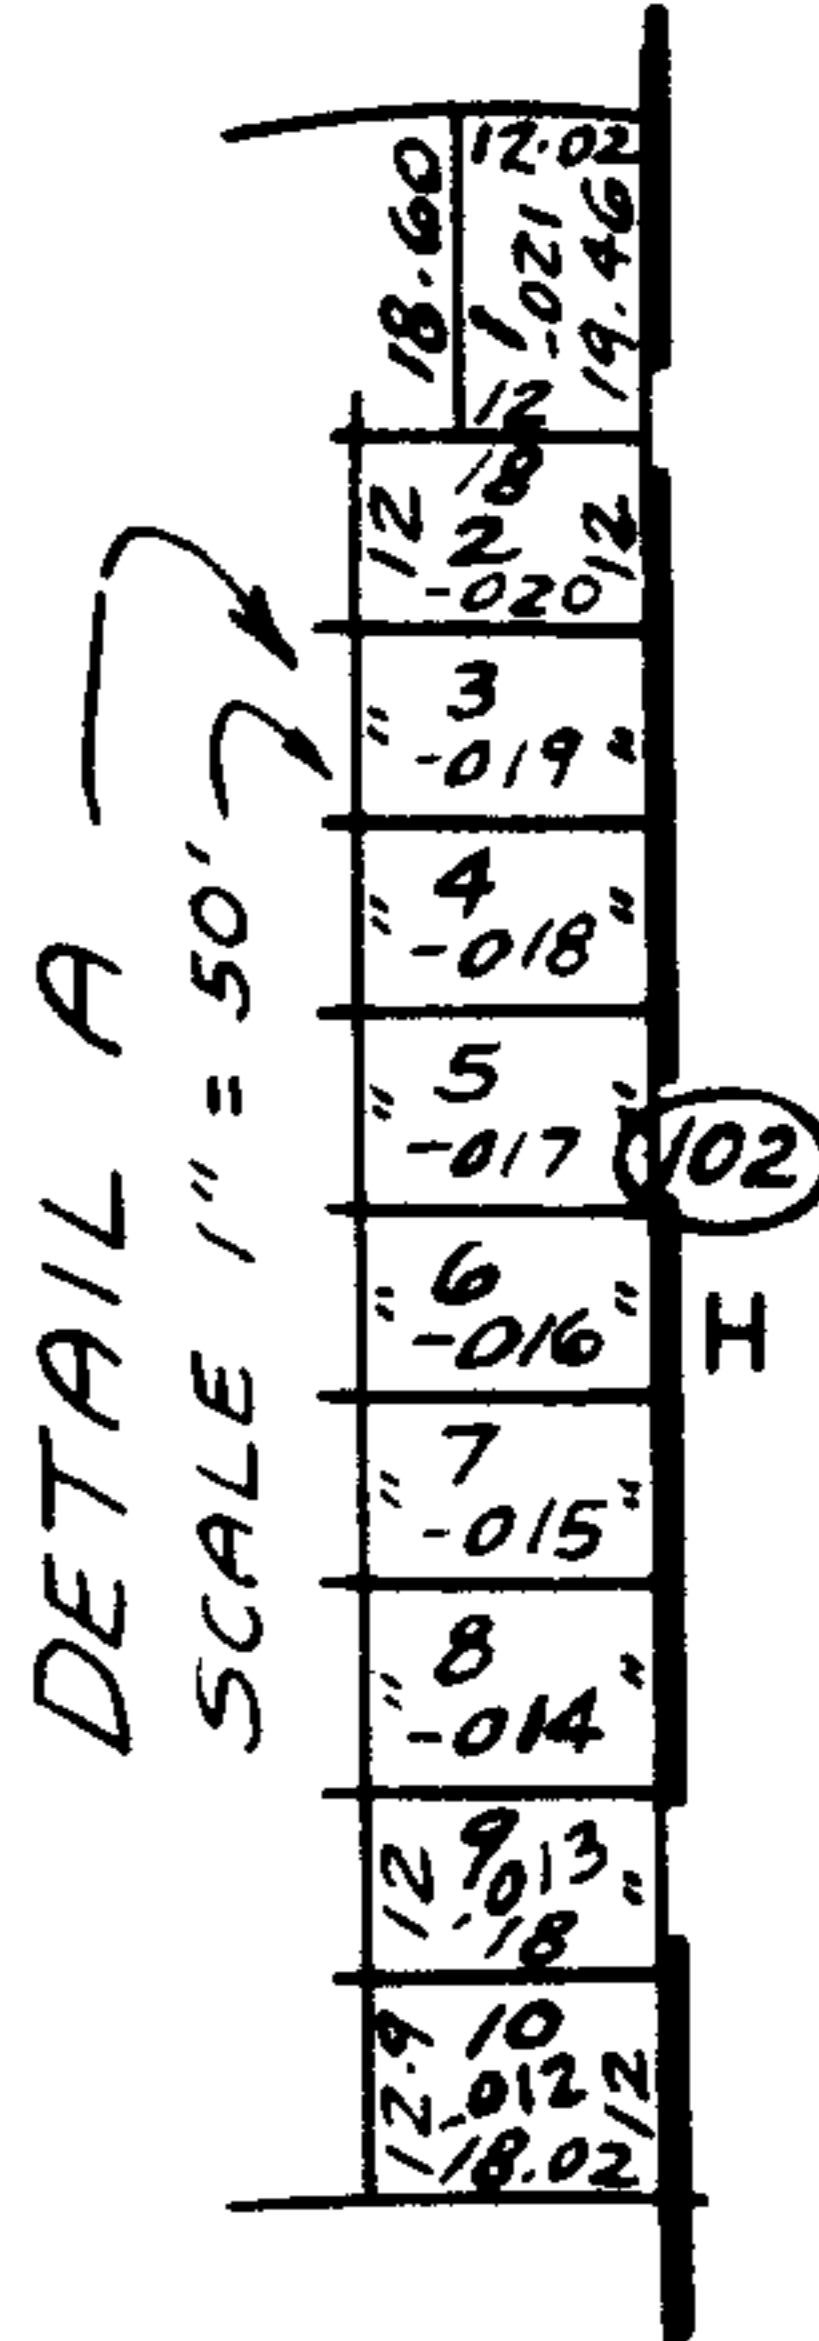


#2748

Parcel No. 03-00-035-101-019

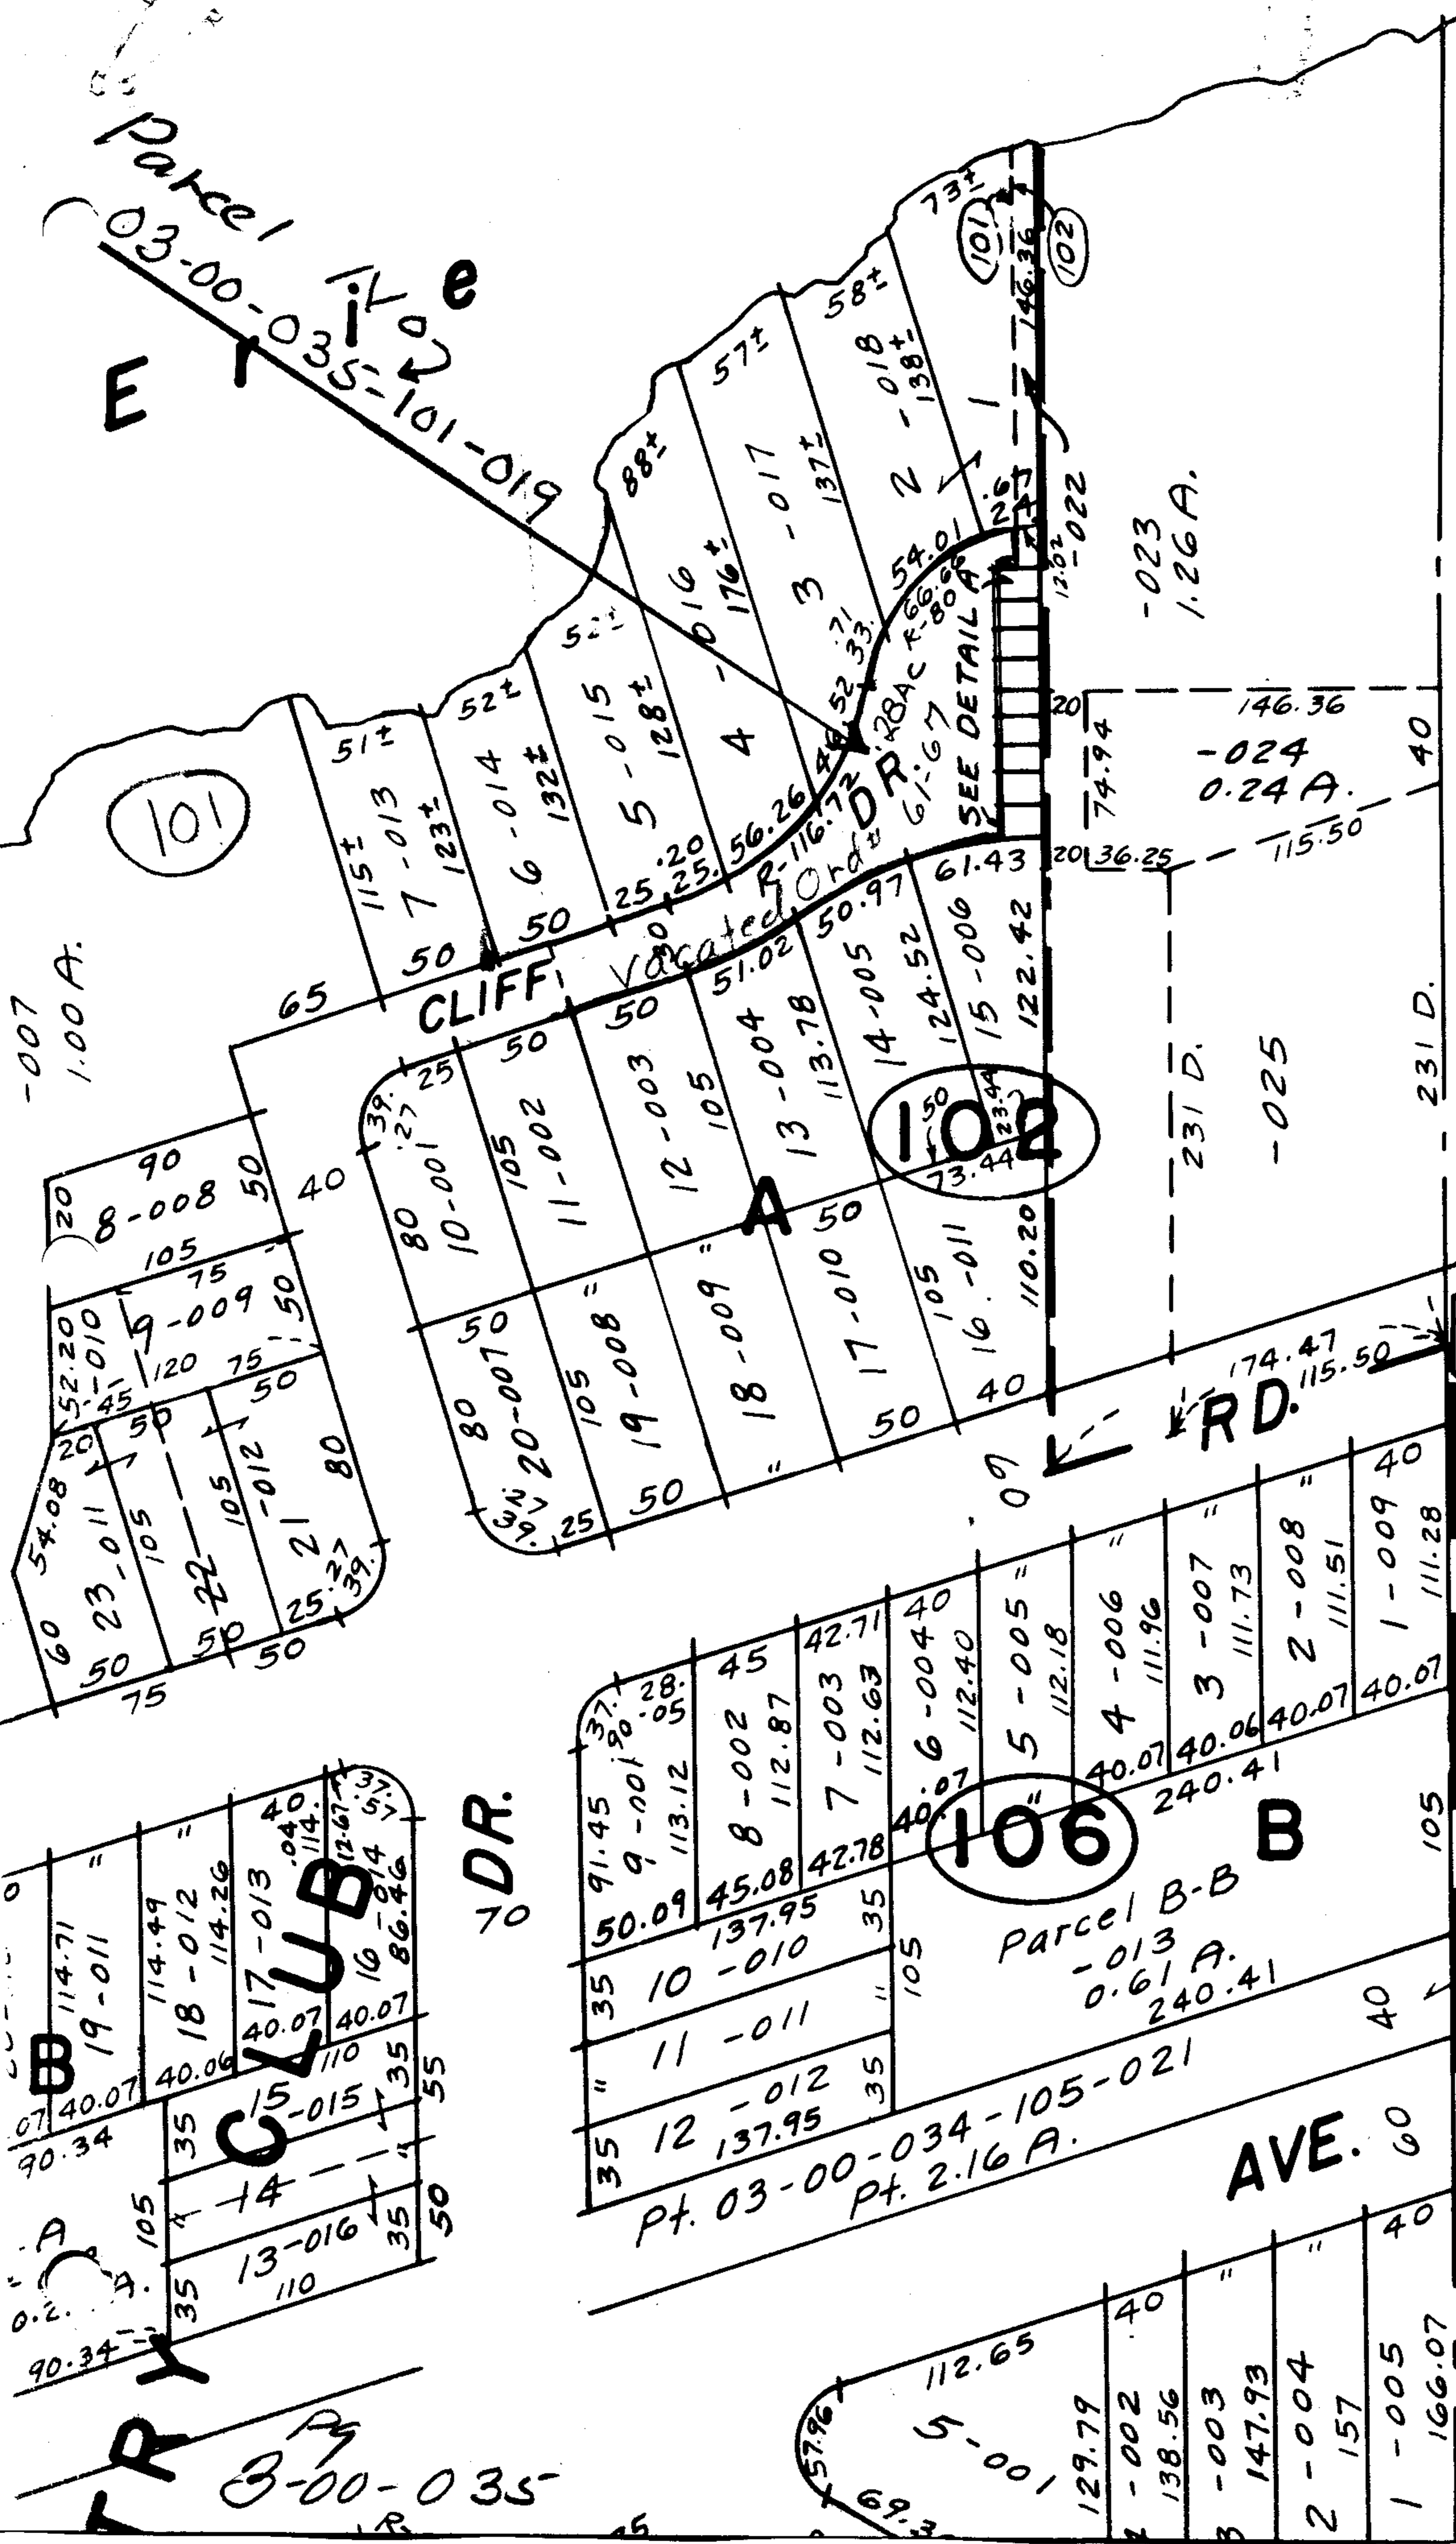

JUN 16 1969

#2748
 APPROVED
 LORAIN CO.
 MAP DEPT.
 DATE 6-3-69
 3-00-035
 BY Lwltail

SEE 3-00-034-A

(No 1)

3-00-035