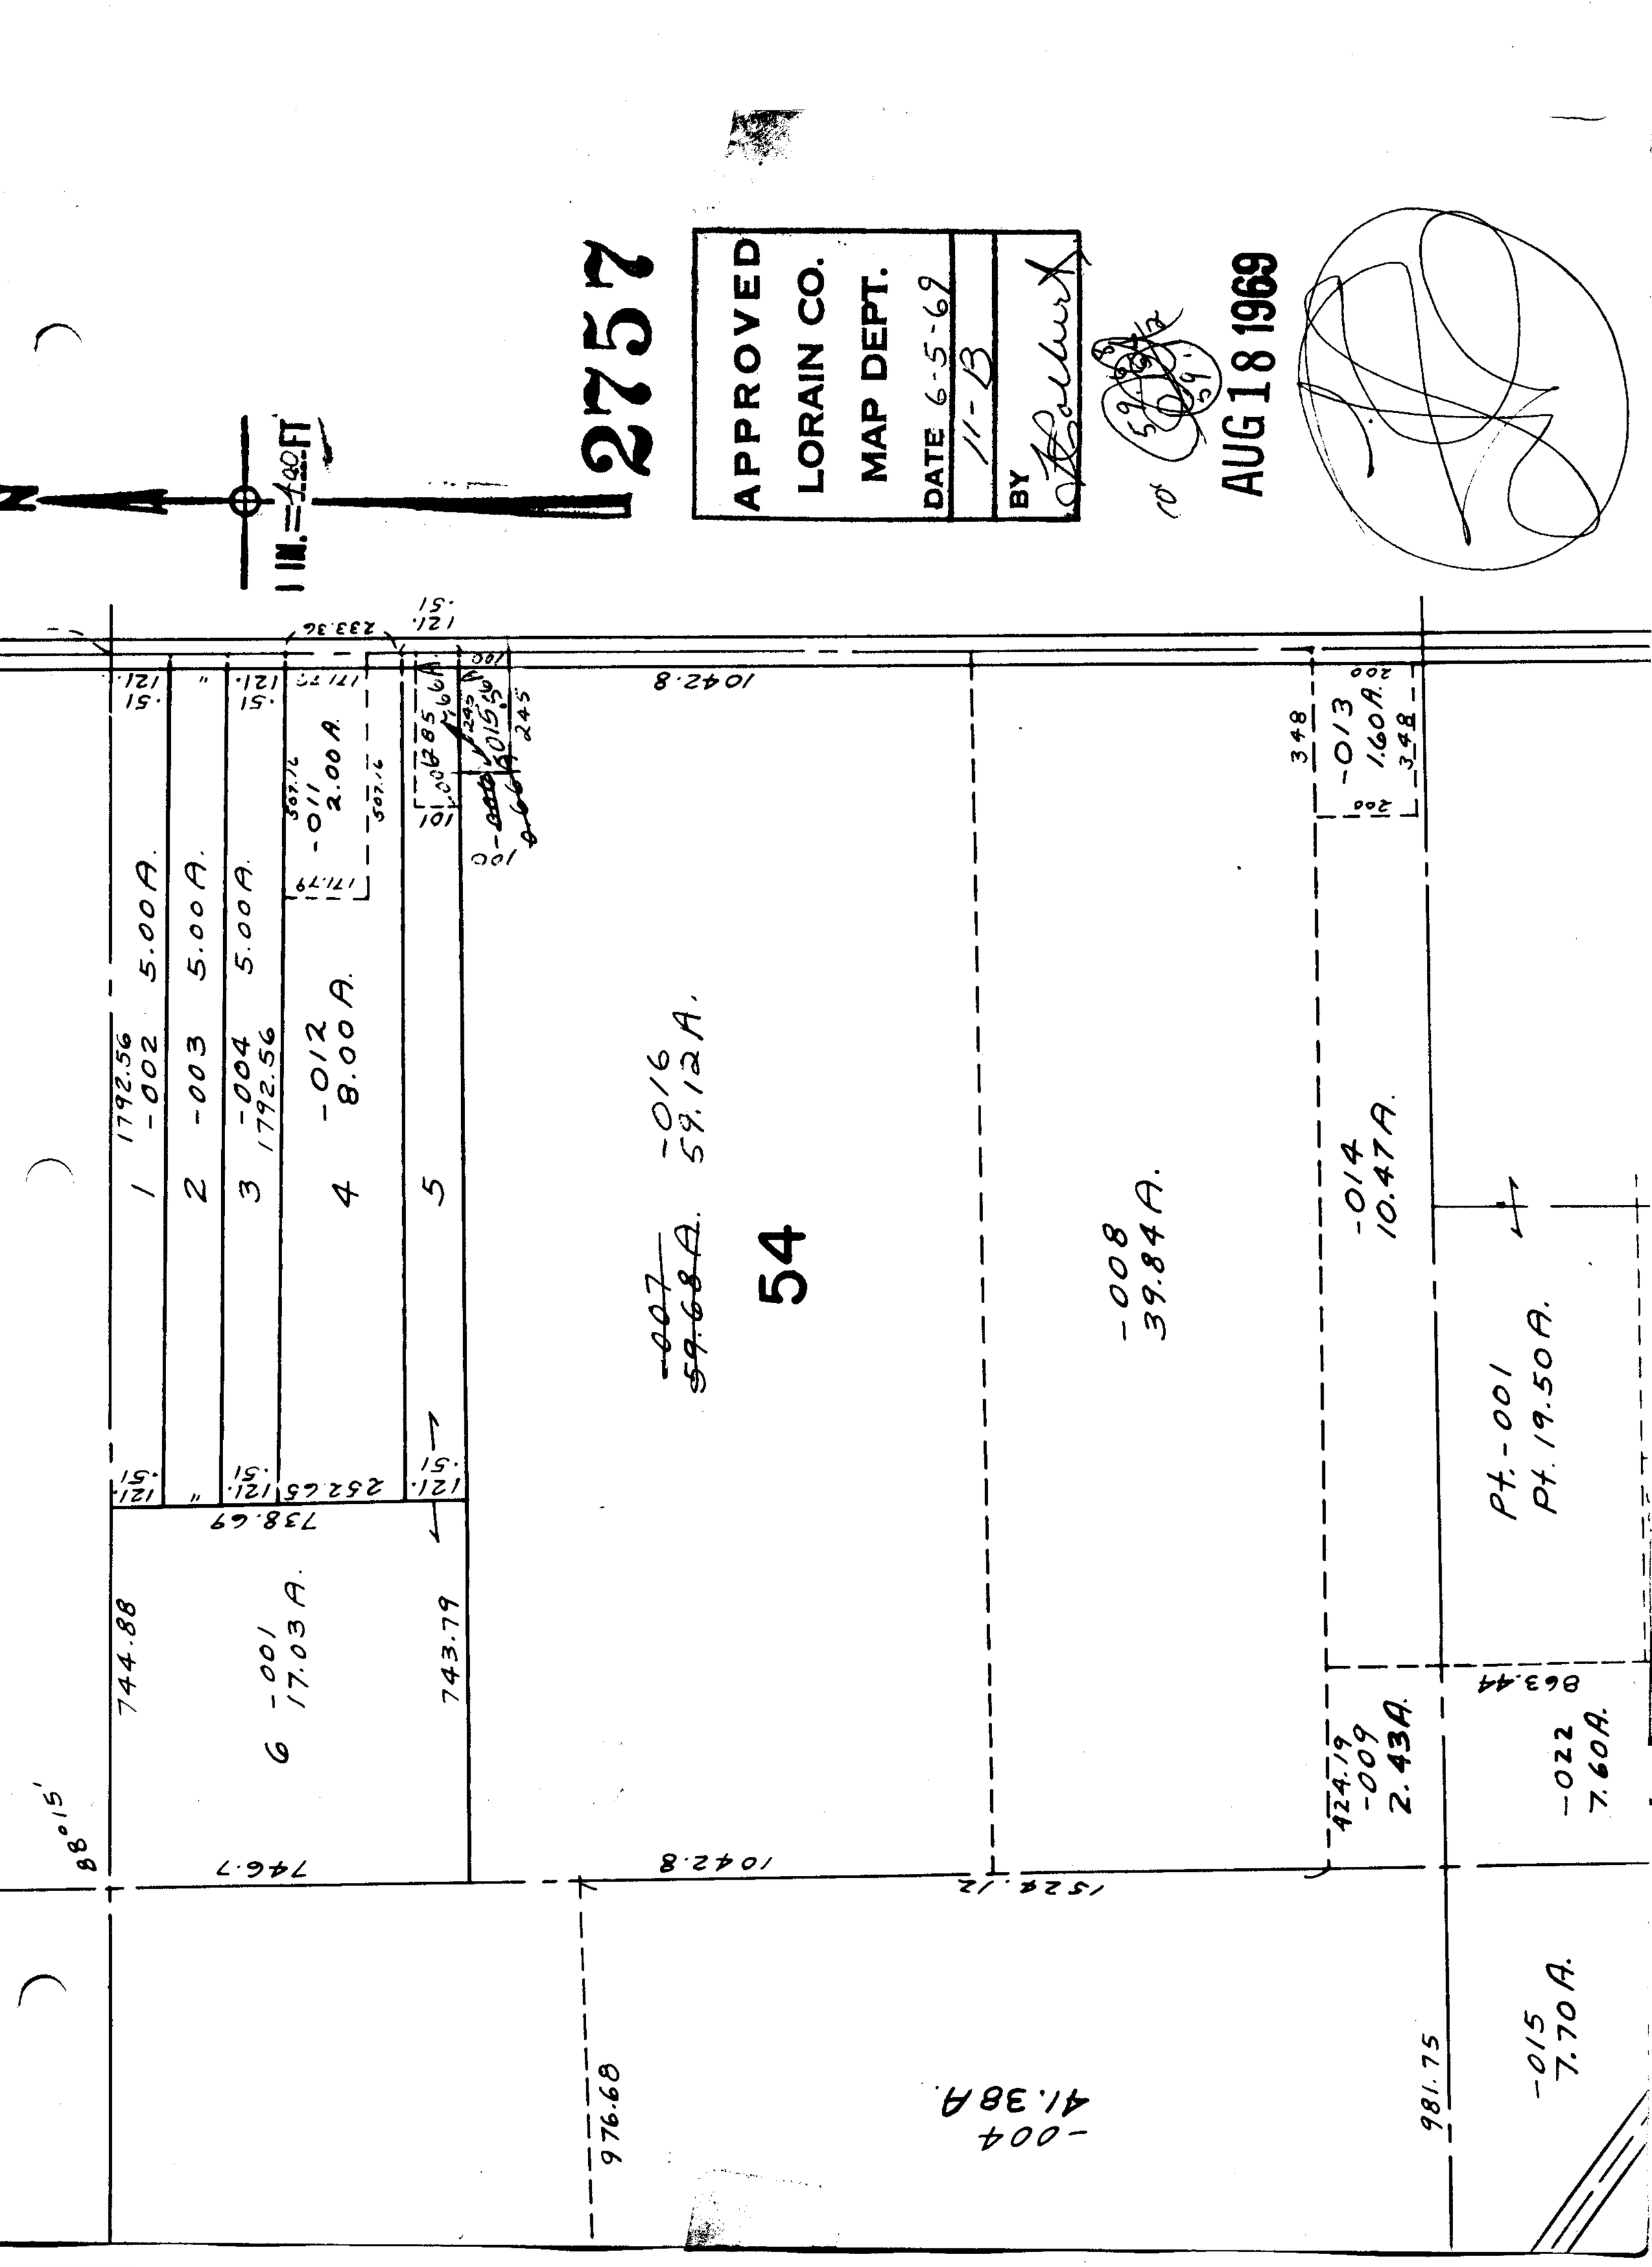

2757
APPROVED
LORAIN CO.
MAP DEPT.
DATE 6-5-69
11-B
BY
AUG 18 1969
N
1 IN. = 400 FT
54
1 -002 5.00 A.
2 -003 5.00 A.
3 -004 5.00 A.
4 -012 8.00 A.
5
6 -001 17.03 A.
-011 2.00 A.
-016 59.12 A.
-007 59.68 A.
-008 39.84 A.
-013 1.60 A.
-014 10.47 A.
-009 2.43 A.
-022 7.60 A.
-015 7.70 A.
-004 41.38 A.
Pt. -001
Pt. 19.50 A.
1792.56
1792.56
1042.8
1042.8
1524.12
744.88
743.79
746.7
738.69
252.65
233.36
976.68
981.75
863.44
424.19
348
200