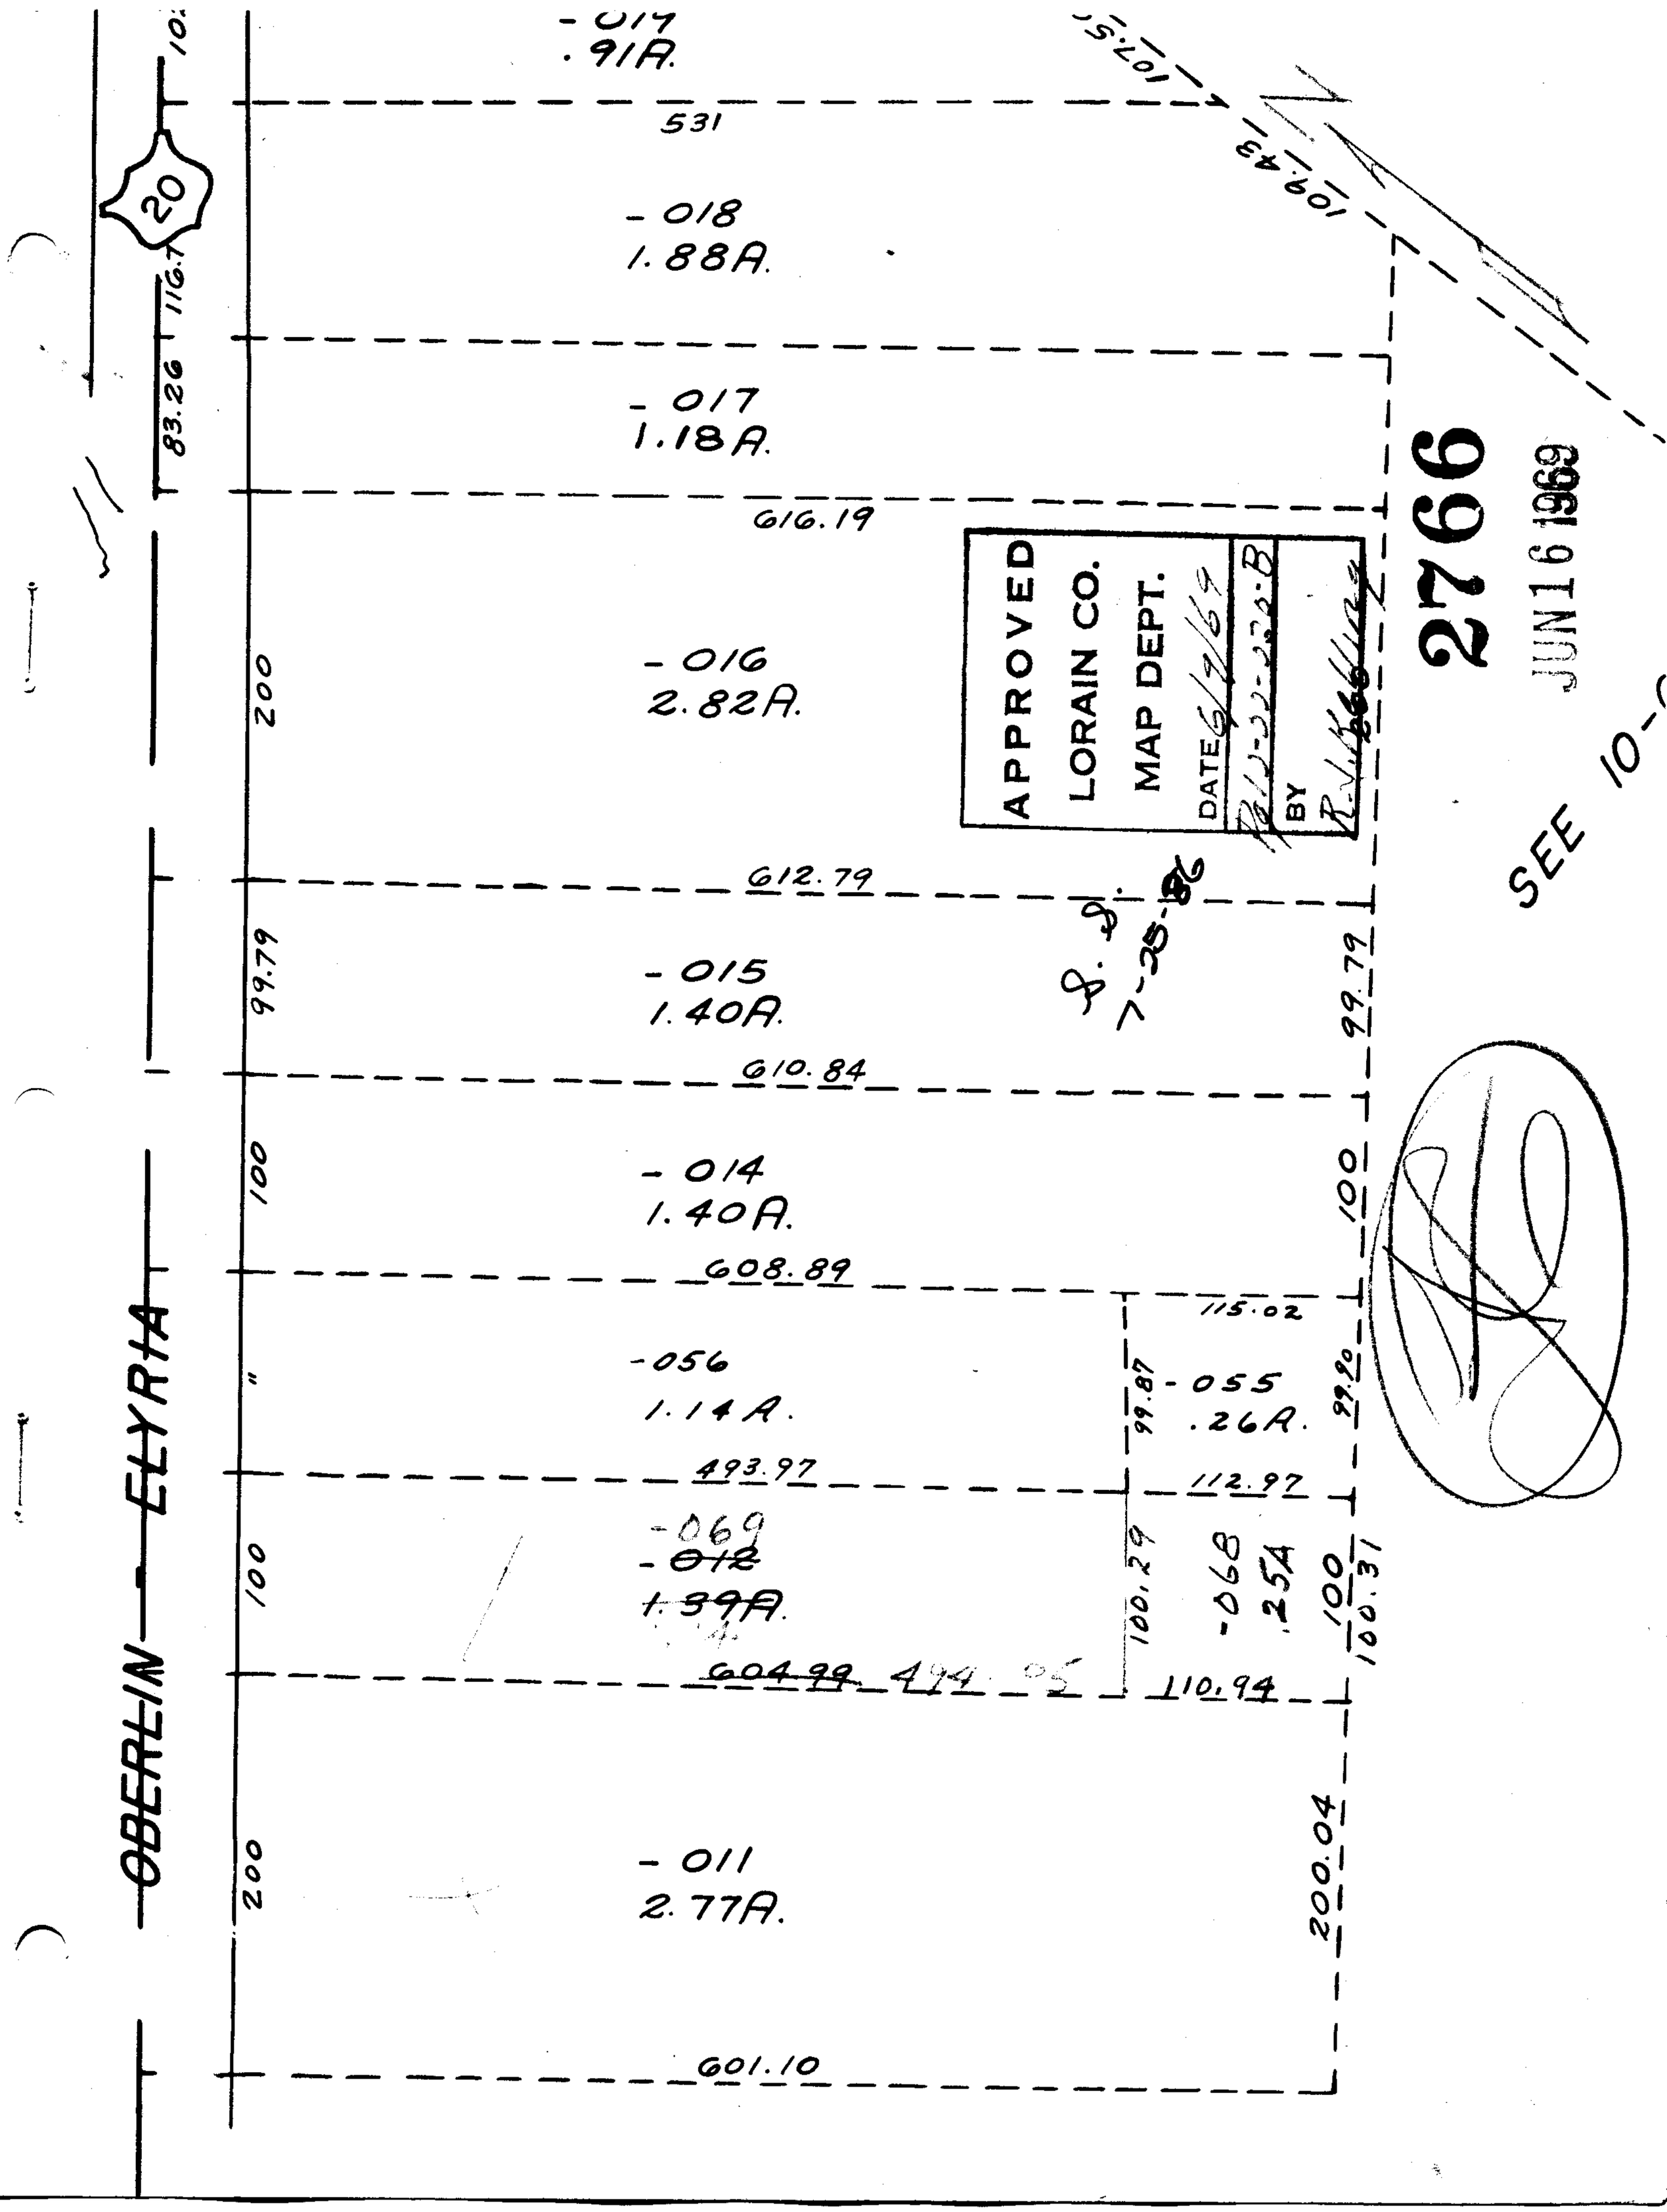

-019
.91A.
531
107.5
109.43
20
-018
1.88A.
116.7
83.26
-017
1.18A.
616.19
APPROVED
LORAIN CO.
MAP DEPT.
DATE 6/9/69
BY
2766
JUN 16 1969
SEE 10-
200
-016
2.82A.
612.79
99.79
-015
1.40A.
7-25-86
99.79
610.84
100
-014
1.40A.
100
608.89
115.02
-056
1.14A.
99.87
-055
.26A.
99.90
493.97
112.97
-069
-012
1.39A.
100
100.29
-068
.25A
100
100.31
604.99
494.05
110.94
OBERLIN - ELYRIA
200
-011
2.77A.
200.04
601.10