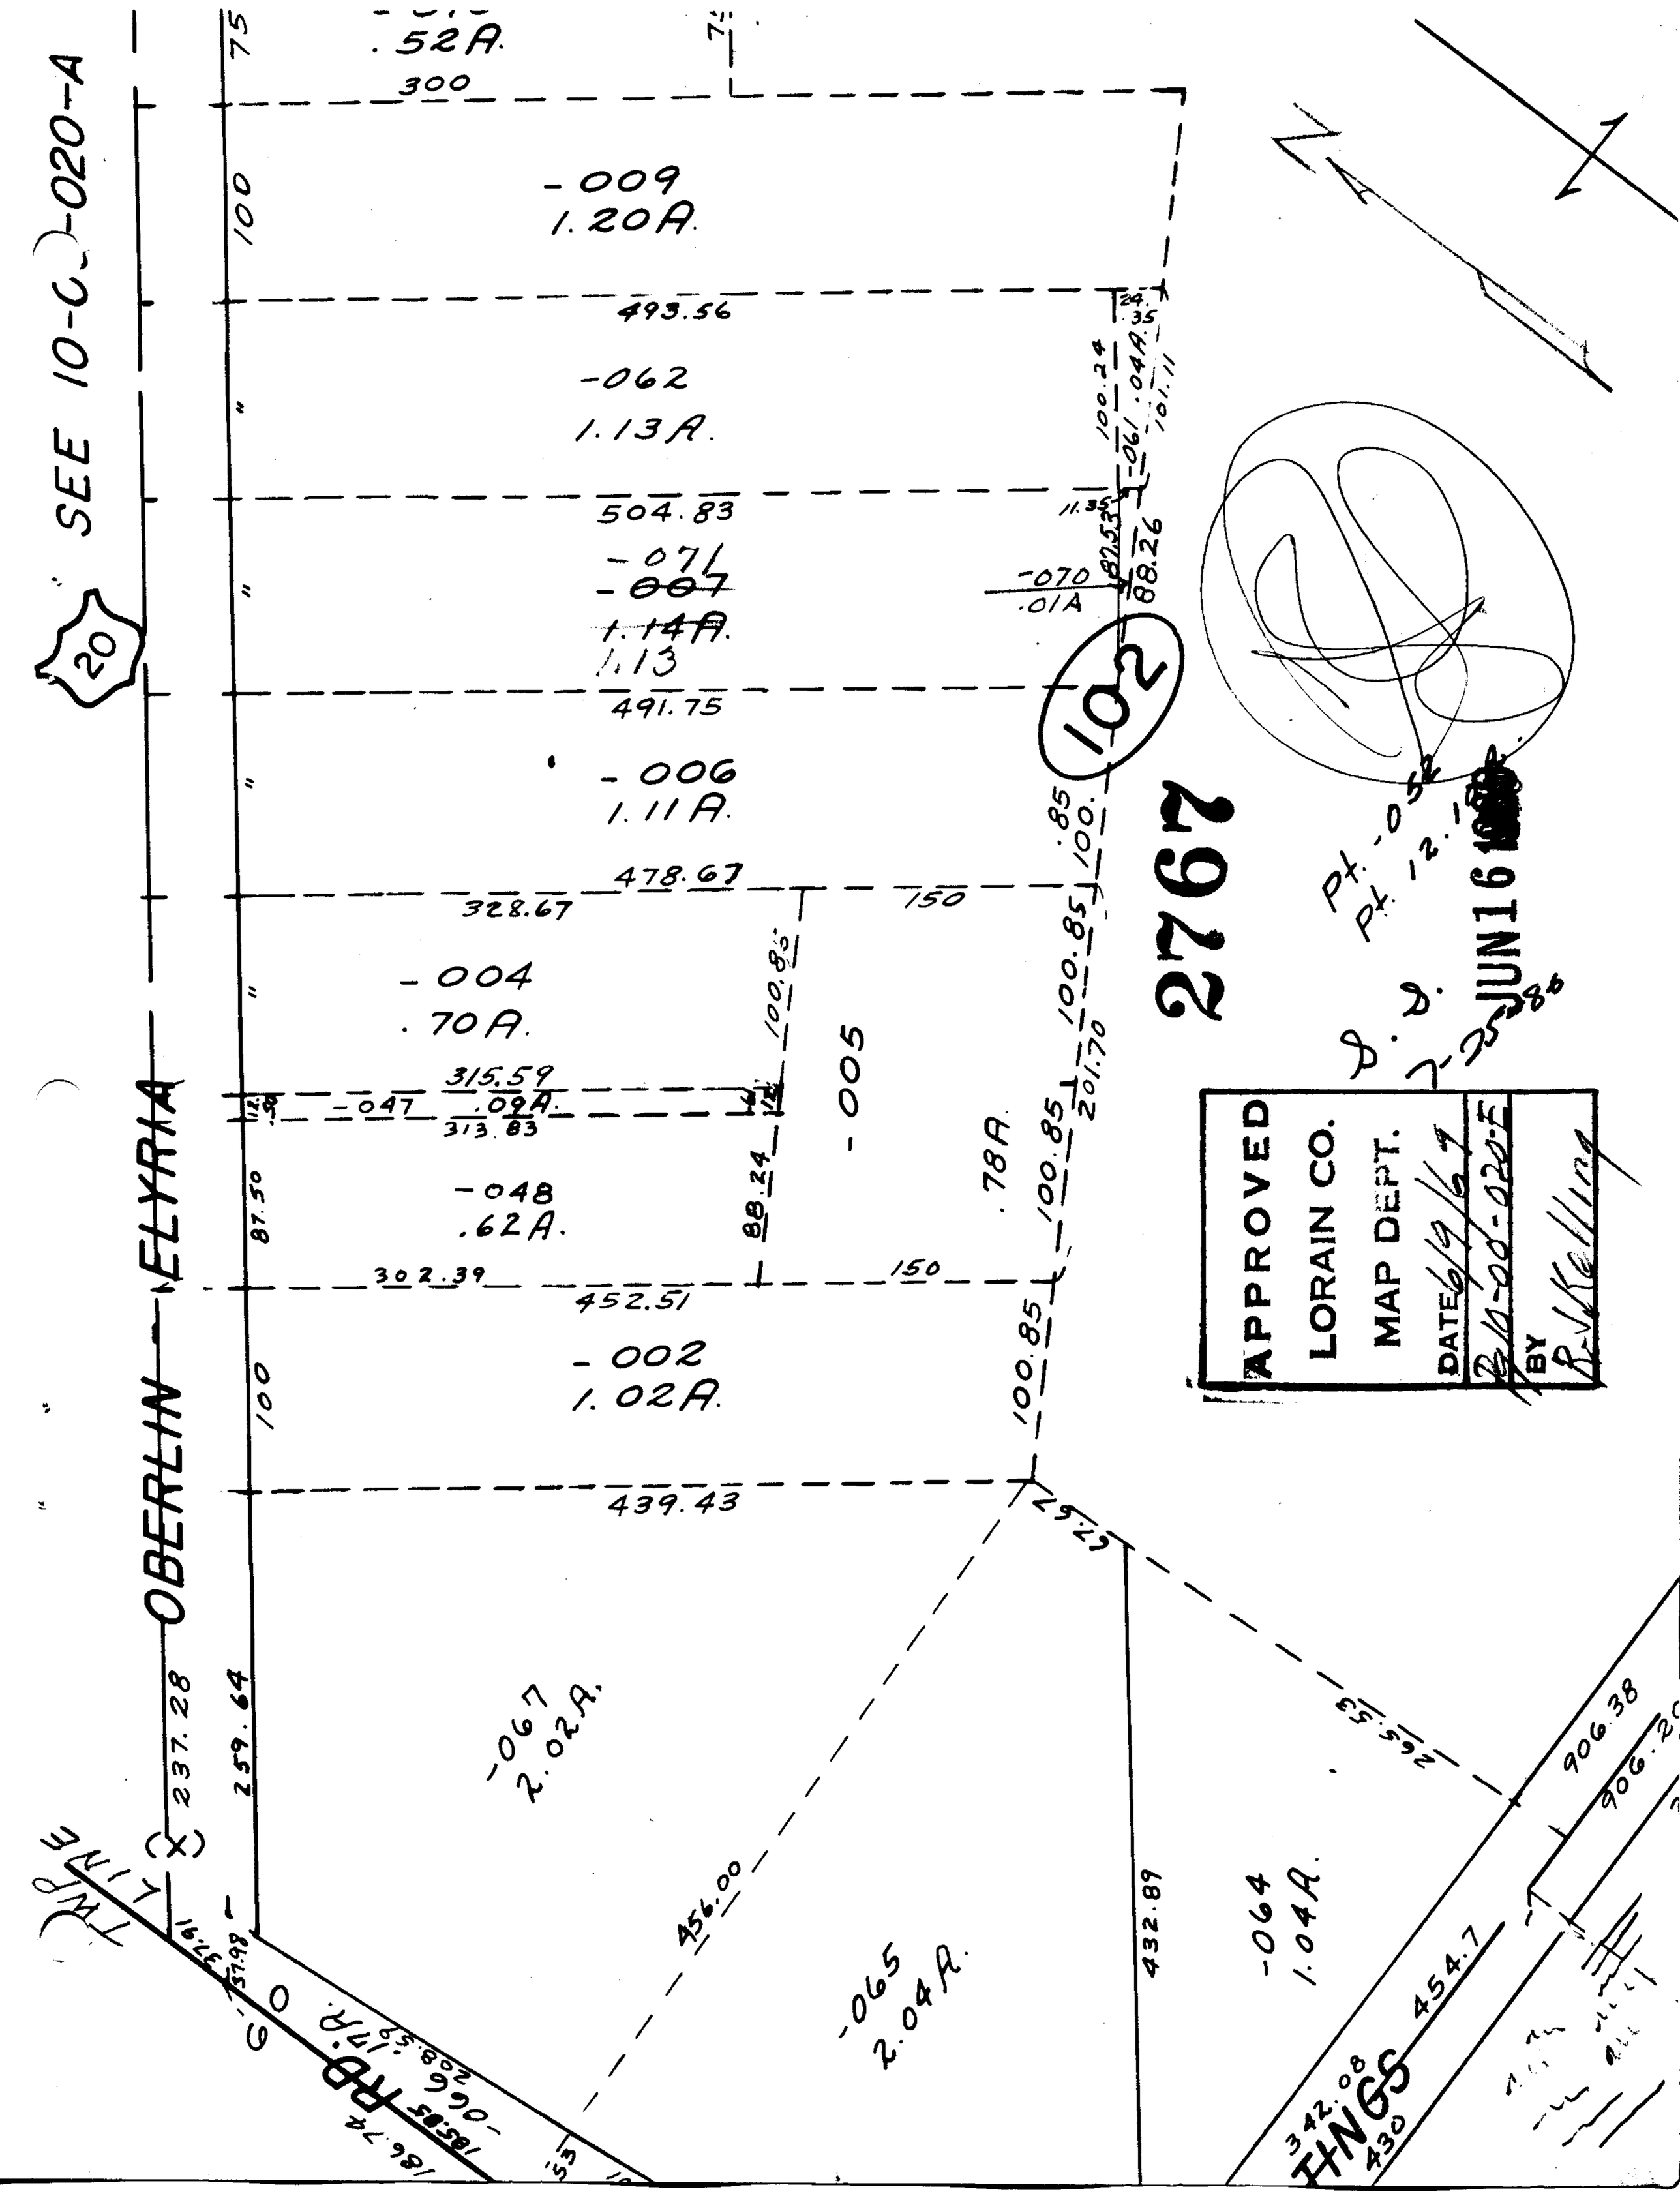

SEE 10-C-020-A
20
OBERLIN - ELYRIA
TWP LINE
RD
-009
1.20A.
493.56
-062
1.13A.
504.83
-071
-007
1.14A.
1.13
491.75
-006
1.11A.
478.67
328.67
-004
.70A.
315.59
-047
.09A.
313.83
-048
.62A.
302.39
452.51
-002
1.02A.
439.43
-067
2.02A.
-065
2.04A.
456.00
-064
1.04A.
432.89
454.7
342.08
430
-070
.01A
102
2767
APPROVED
LORAIN CO.
MAP DEPT.
DATE 6/9/69
BY
JUN 16