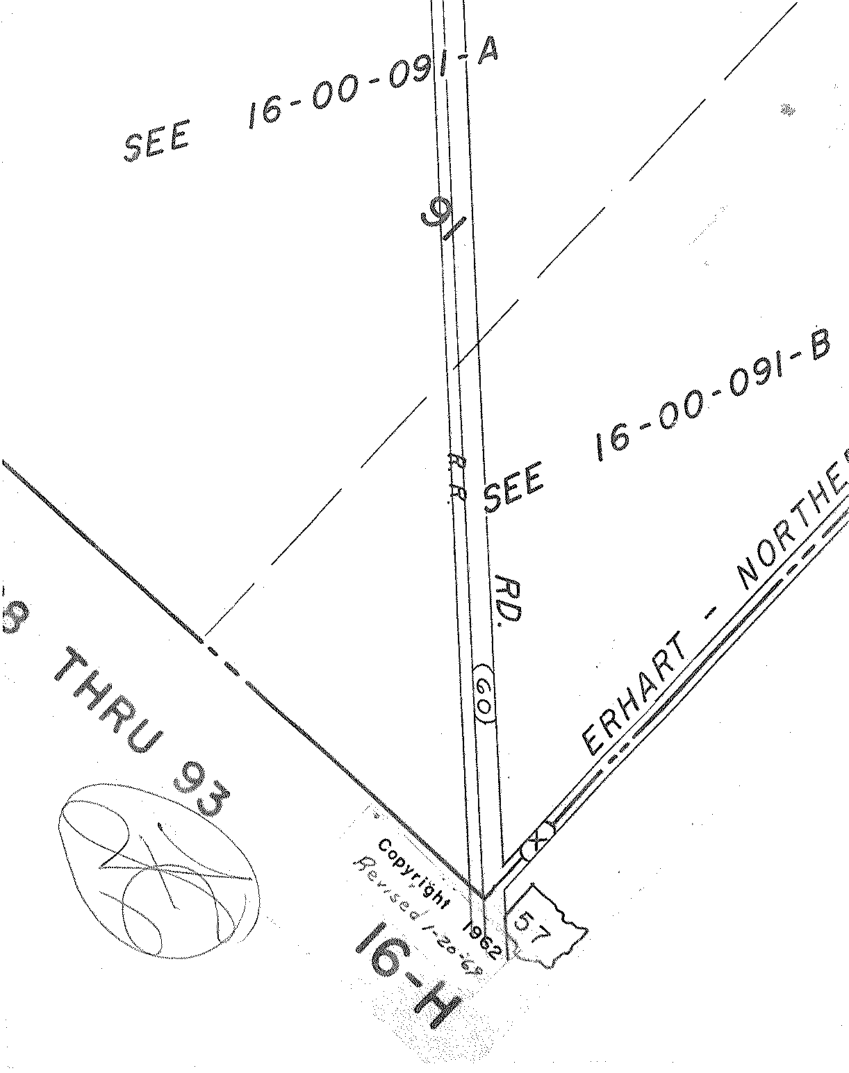
SEE 16-00-091-A
91
SEE 16-00-091-B
R.R.
SEE
RD.
60
ERHART - NORTHE
8 THRU 93
X
57
Copyright 1962
Revised 1-20-69
16-H

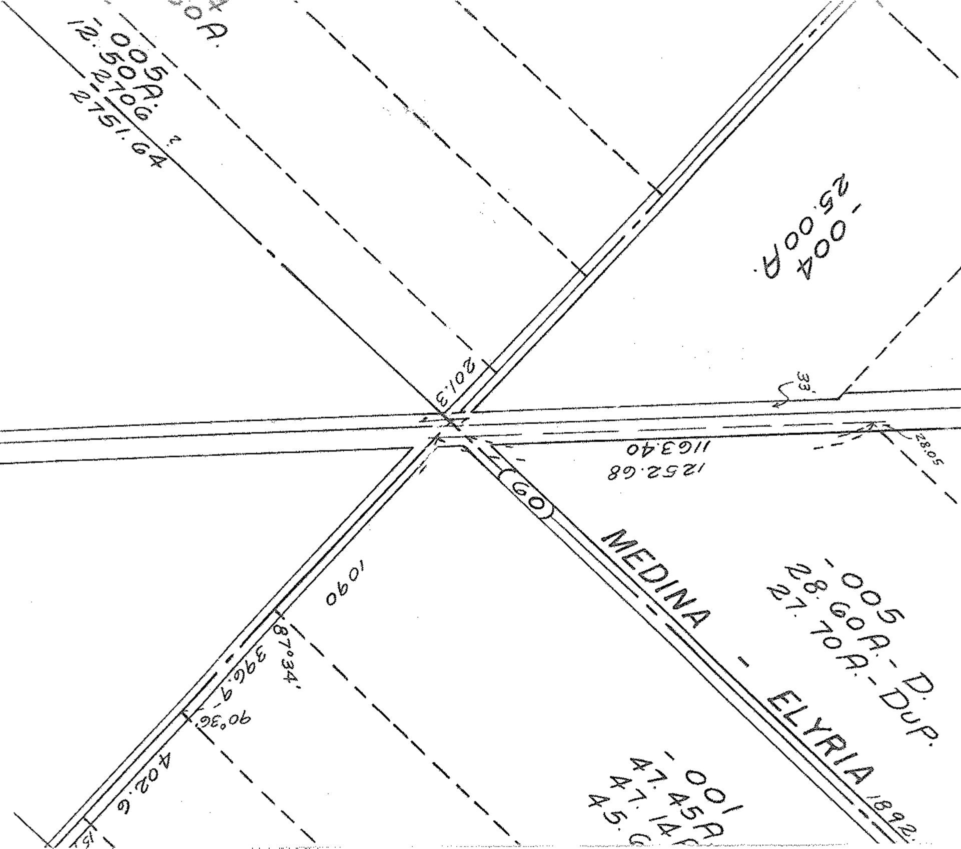
0A.
-005
12.50A.
2.706
2751.64
2
-004
25.00A
201.3
33'
1163.40
1252.68
28.05
60
MEDINA - ELYRIA
1892
-005
28.60A.-D.
27.70A.-DUP.
1090
87°34'
396.9
90°36'
402.6
15
-001
47.45A
47.14A
45.6

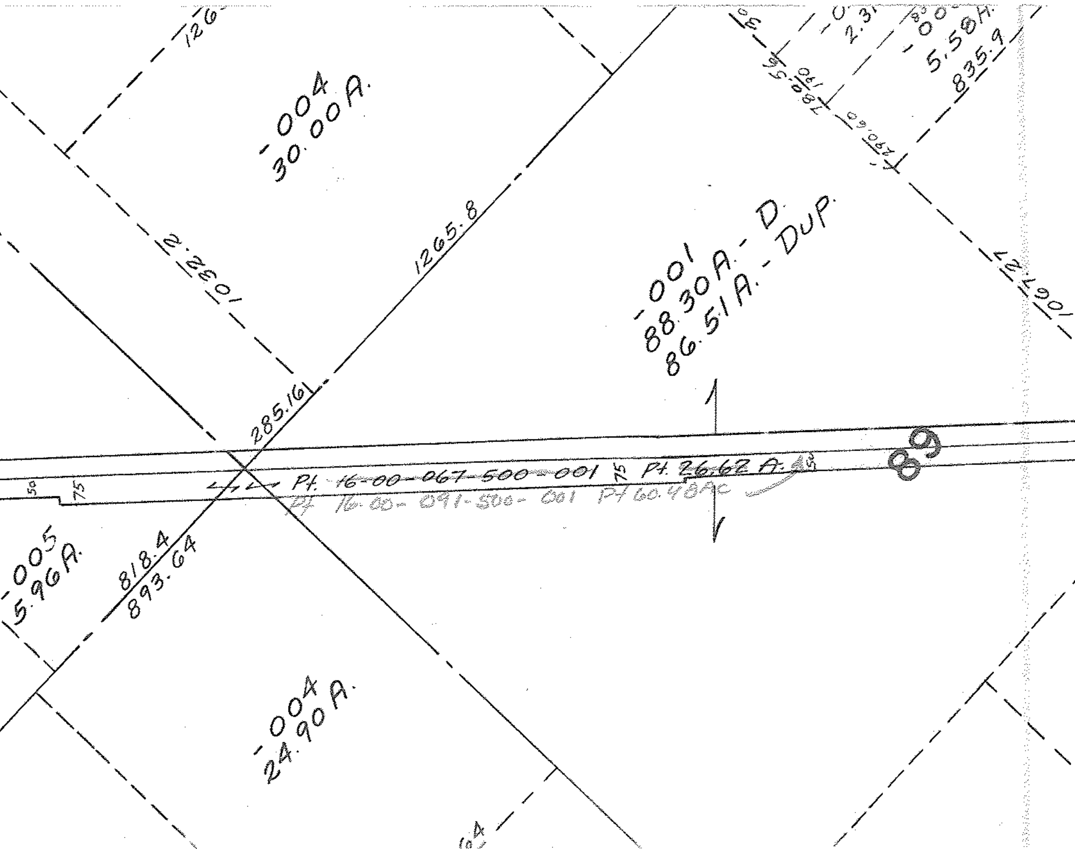
-004
30.00A.
-001
88.30A. - D.
86.51A. - DUP.
1265.8
2.2301
285.16
1067.27
290.60
780.56
190
-005
5.58A.
835.9
2.31
Pt. 16-00-067-500-001
75
Pt. 26.62 A.
.45
50
75
Pt 16-00-091-500-001 Pt 60.48Ac
89
-005
5.96A.
818.4
893.64
-004
24.90A.
126
64

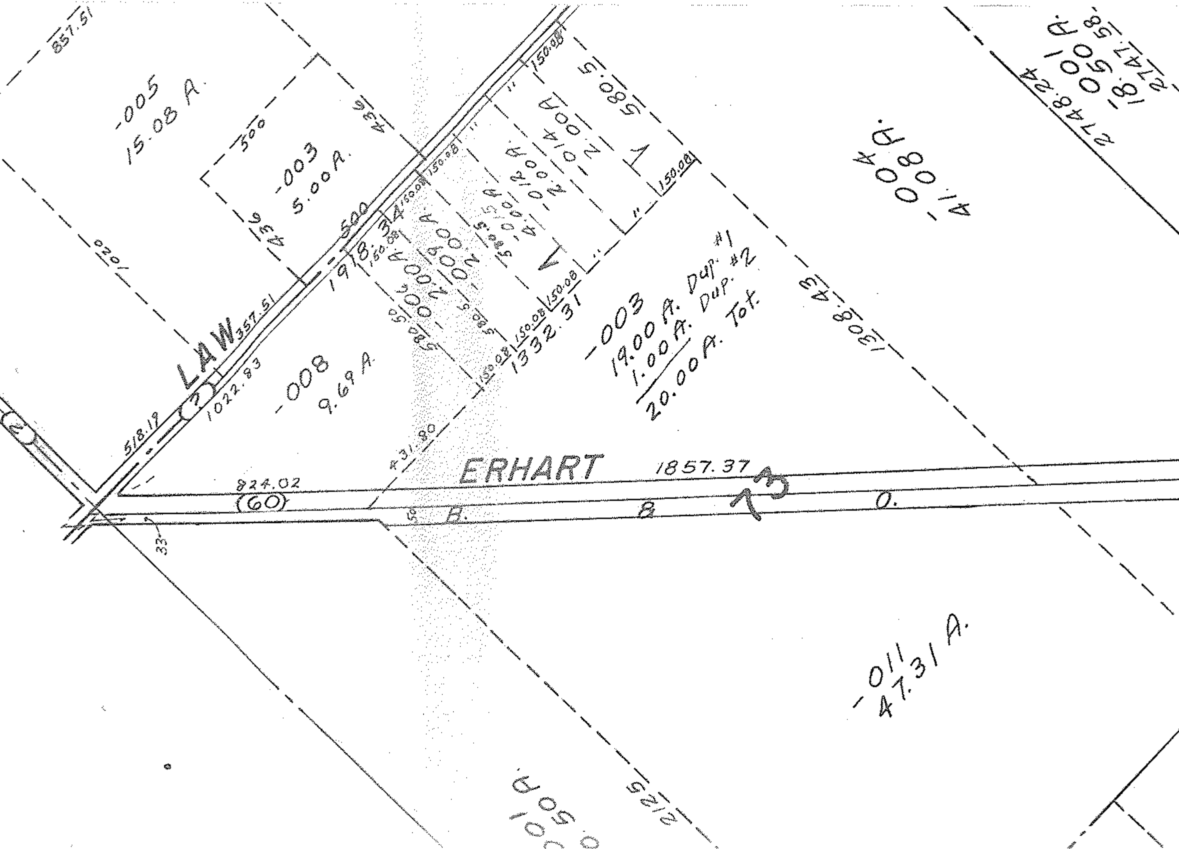
357.51
-005
15.08 A.
500
-003
5.00 A.
436
436
1020
LAW
357.51
500
1918.34
518.19
1022.83
-008
9.69 A
-006
2.00 A
-007
2.00 A
-010
4.00 A.
-012
2.00 A
-014
2.00 A
580.5
580.5
580.5
150.08
150.08
150.08
150.08
150.08
150.08
150.08
1332.31
-003
19.00 A. Dup. #1
1.00 A. Dup. #2
20.00 A. Tot.
1308.43
-004
41.08 A.
2748.24
-001
18.50 A.
2747.58
431.80
ERHART
1857.37
824.02
60
R.
R
73
D.
33
50
-011
47.31 A.
2125
-001
50 A.

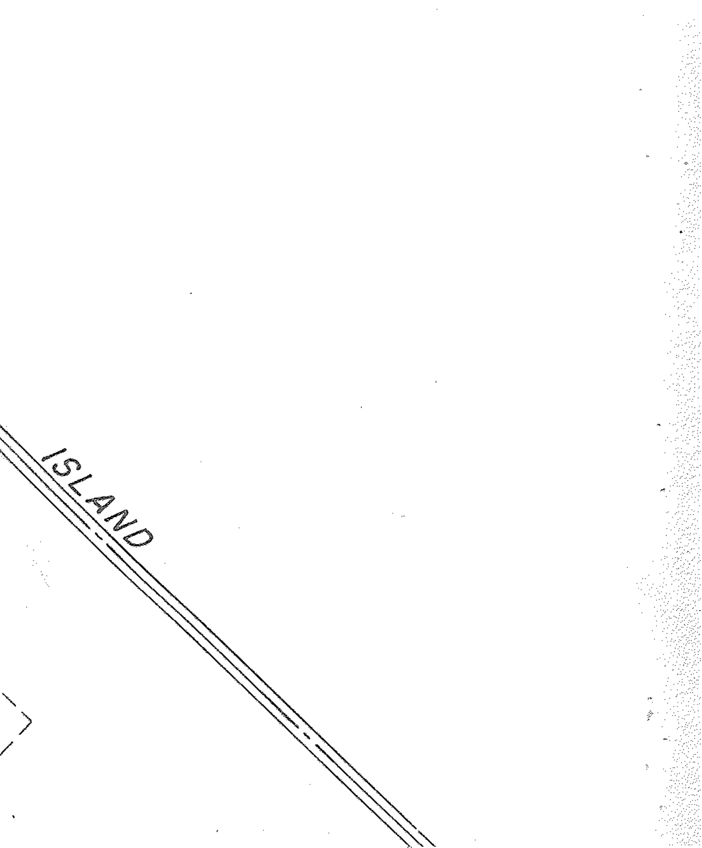
ISLAND