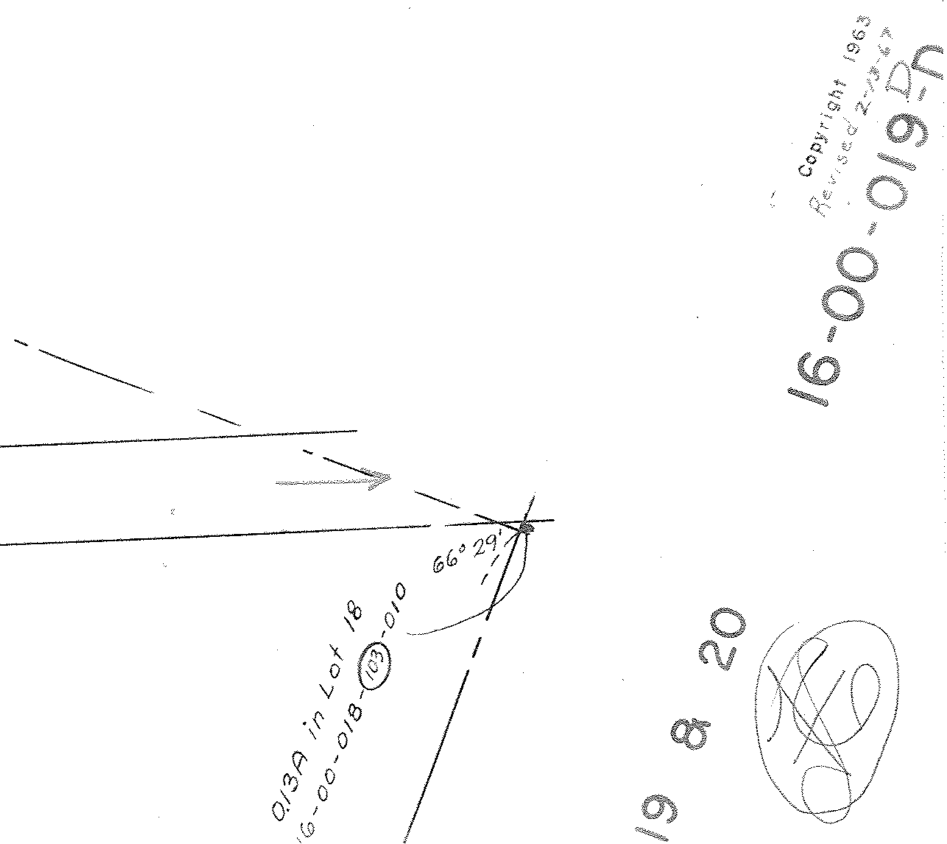
Copyright 1963
Revised 2-13-67
16-00-019-D
0.13A in Lot 18
16-00-018-103-010
66° 29'
19
8
20

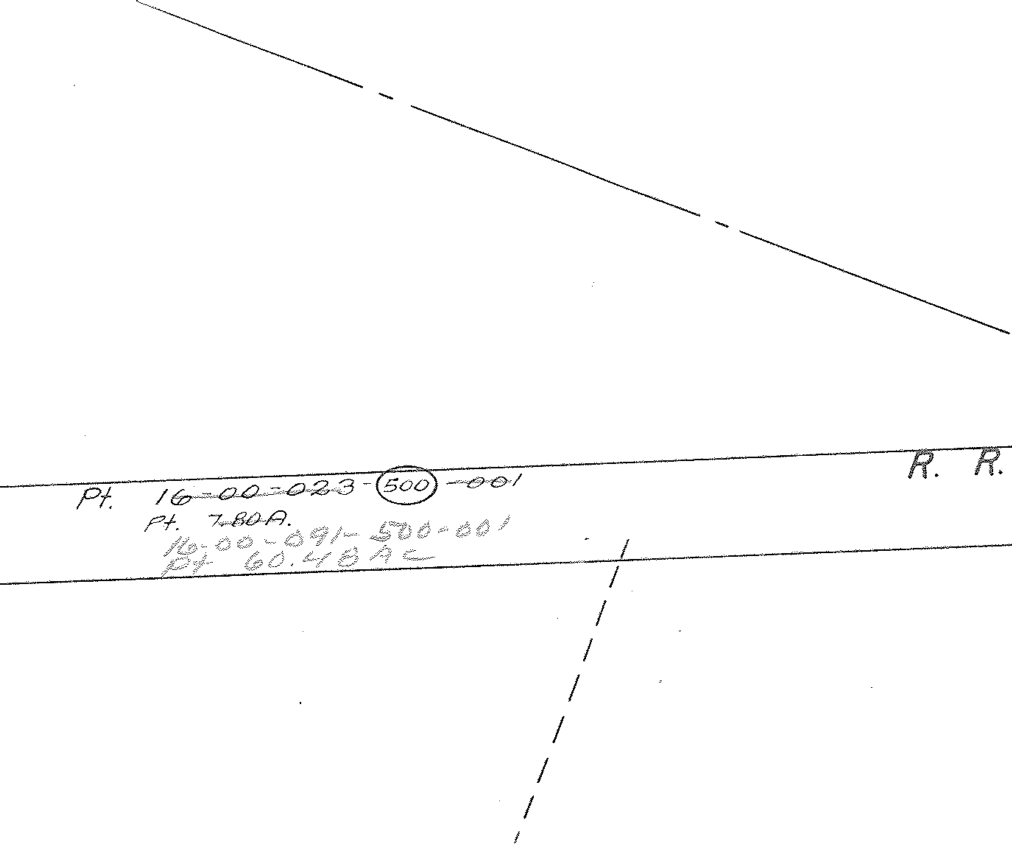
Pt. 16-00-023-500-001
Pt. 7.80A.
16-00-091-500-001
Pt 60.478 AC
R. R.

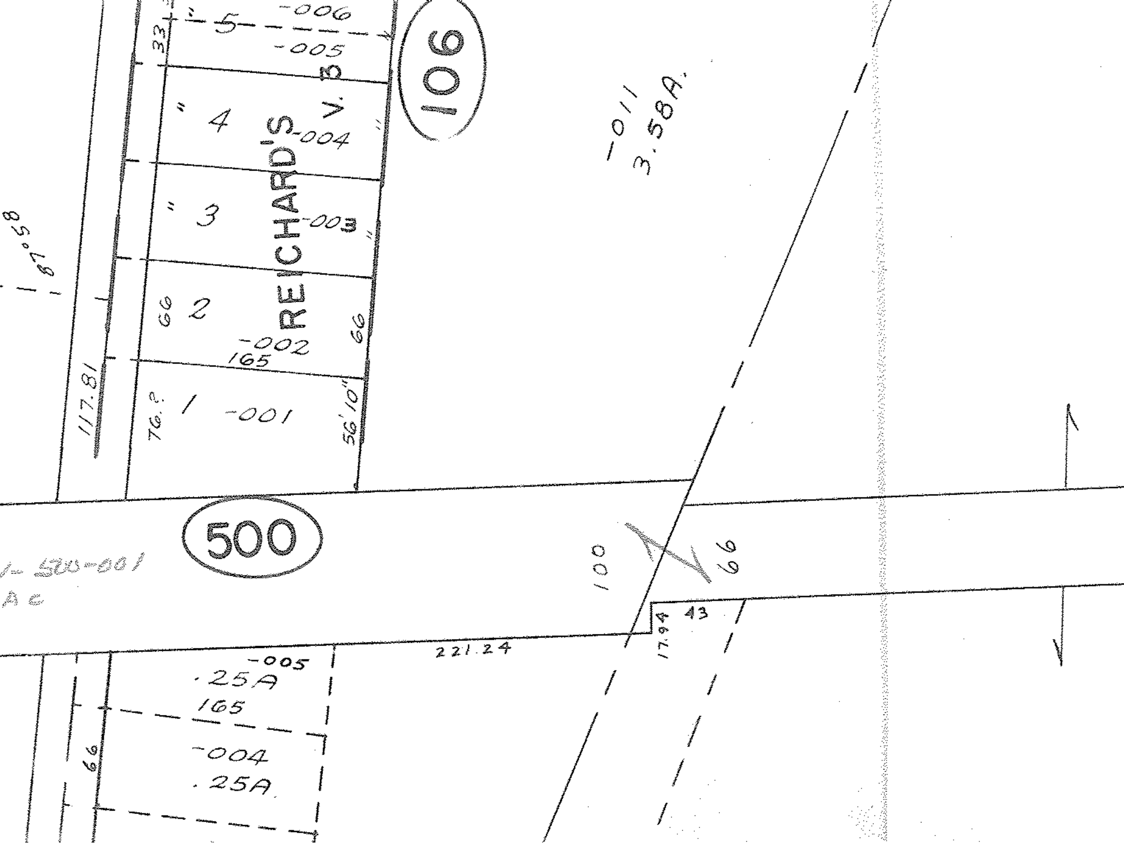
-006
5
33
-005
106
4
REICHARD'S
V. 3
-004
-011
3.58A.
3
-003
87°58
66
2
-002
165
66
117.81
76.?
1
-001
56'10"
500
-500-001
Ac
100
66
43
17.94
221.24
-005
.25A
165
-004
.25A
66

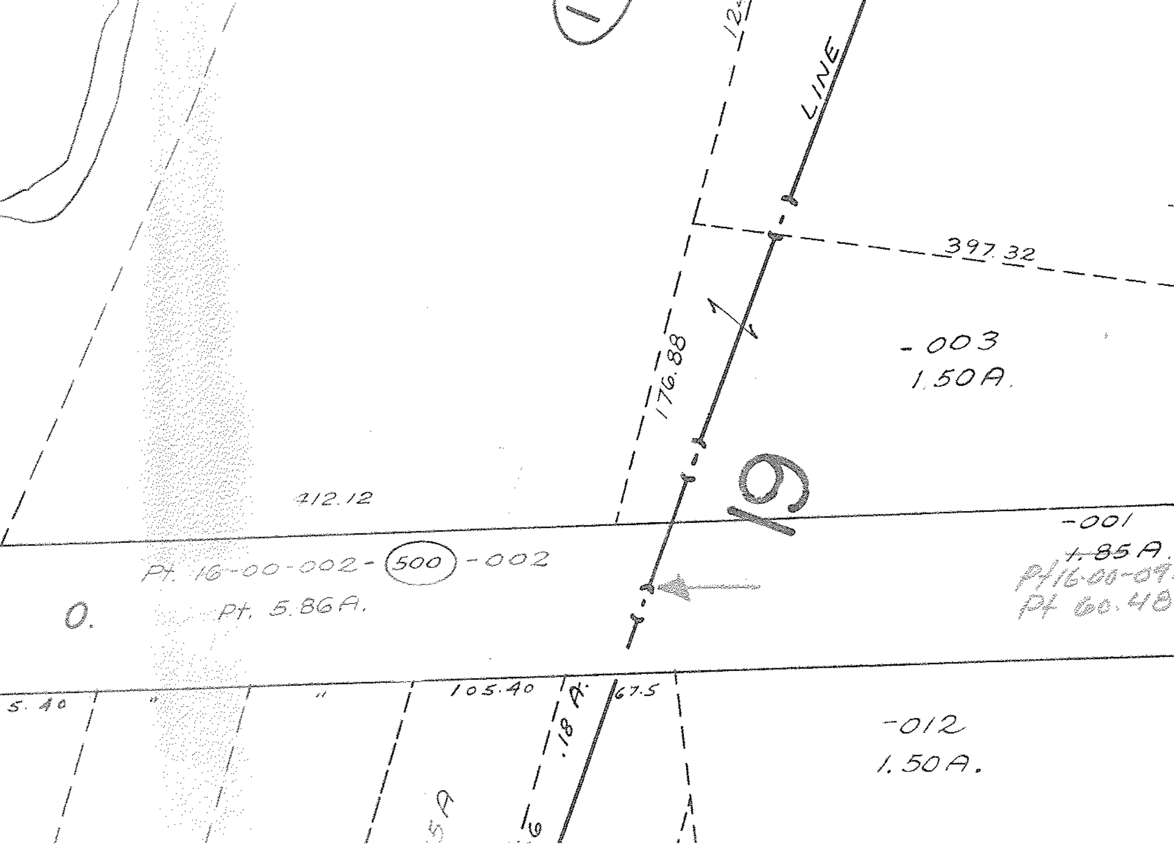
LINE
124
397.32
-003
1.50A.
176.88
19
412.12
-001
~~1.85A.~~
Pt 16-00-09
Pt 60.48
Pt. 16-00-002-500-002
0.
Pt. 5.86A.
5.40
"
"
105.40
.18A.
67.5
-012
1.50A.
6
5P

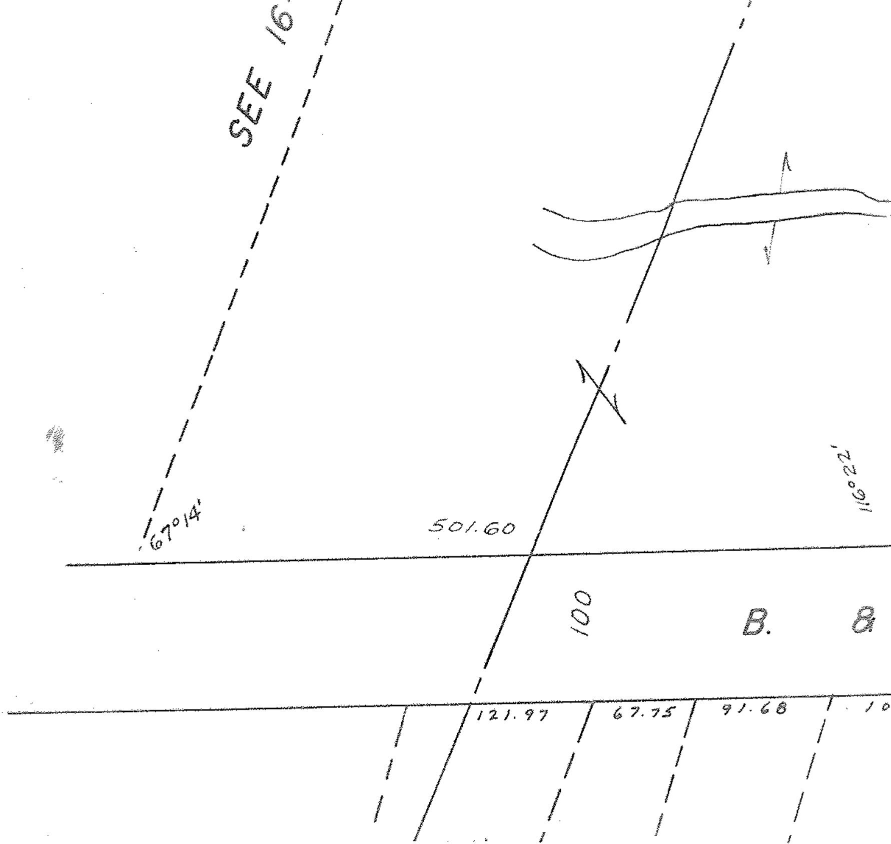
SEE 16
67°14'
501.60
116°22'
100
B.
B.
121.97
67.75
91.68
10