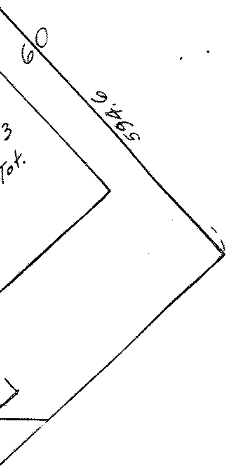
60
594.6
3
Tot.

16-00-045-B

Copyright 1962

45

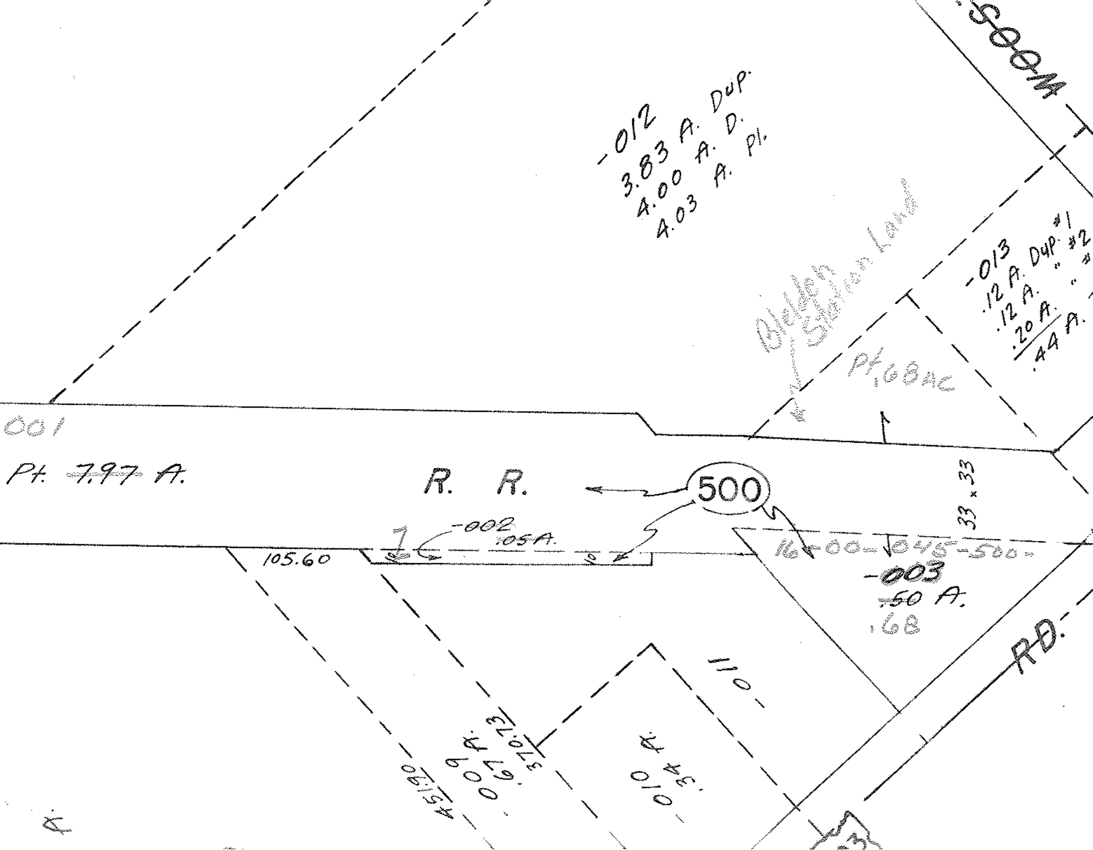

-012
3.83 A. Dup.
4.00 A. D.
4.03 A. Pl.
-013
.12 A. Dup. #1
.12 A. " #2
.20 A. " #
.44 A.
Belden Station Land
Pt. .68 AC
001
Pt. ~~7.97~~ A.
R. R.
500
33 x 33
-002
.05 A.
10
10
105.60
16-00-045-500-
-~~003~~
~~.50~~ A.
.68
RD.
SOOM
-011
.009
.67 A.
370.73
451.90
.010
.34 A.
A.

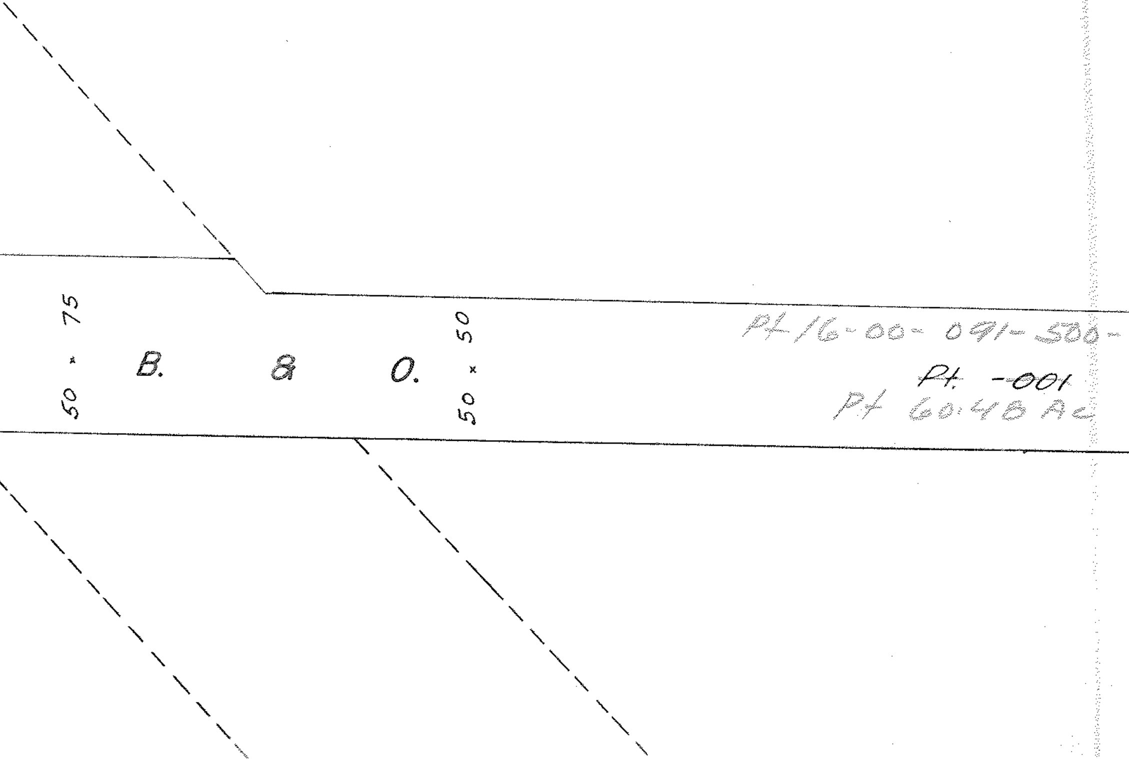
50 × 75
B. & O.
50 × 50
Pt 16-00-091-500-
Pt -001
Pt 60.48 Ac

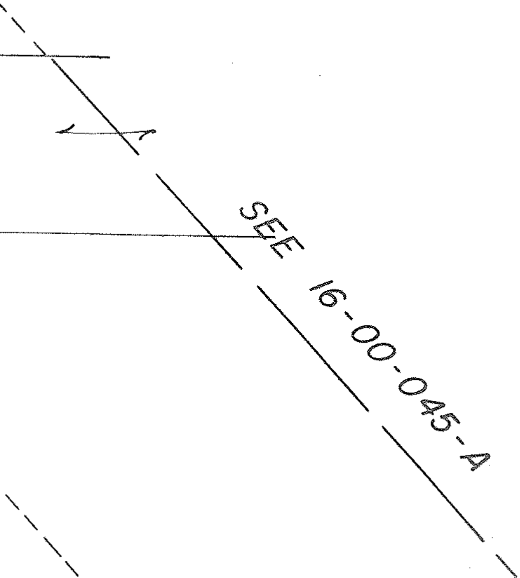
SEE 16-00-045-A