


18-00-028-D  
MAIN ST.)

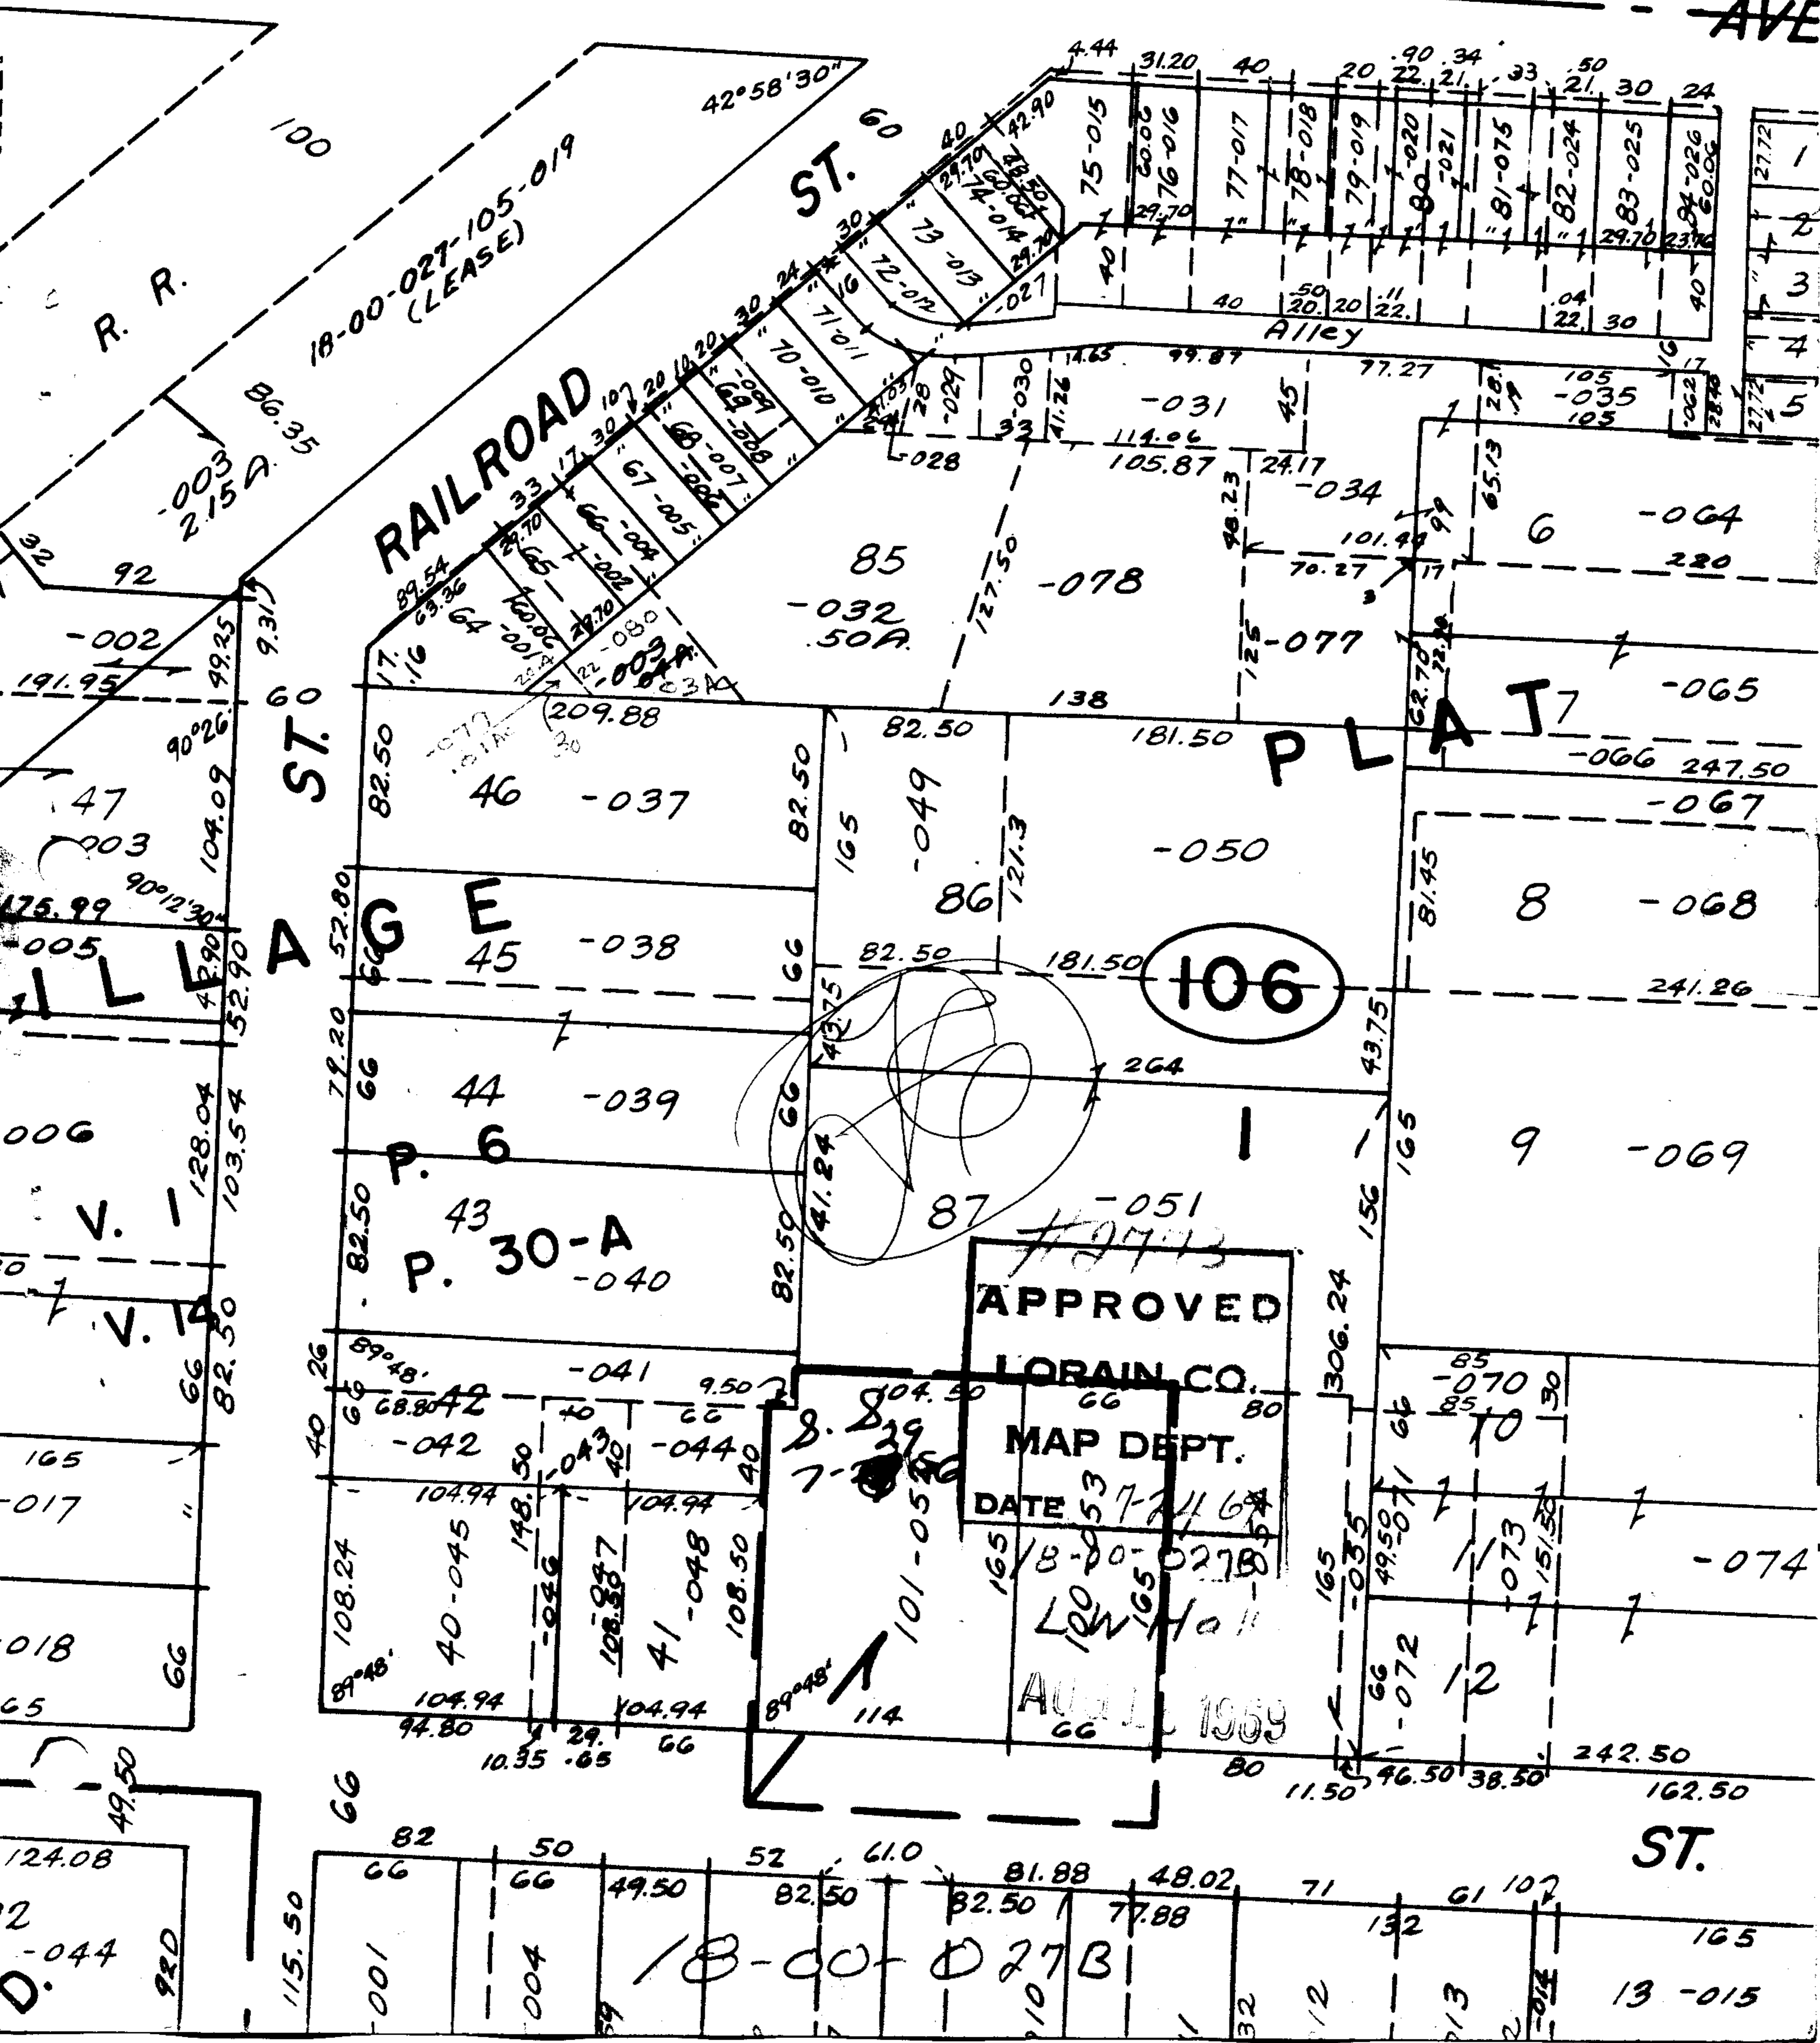

18-00-027-105-019  
(LEASE)

RAILROAD

ST. 60

ST. 6

PLAT 7

106

APPROVED  
LORAIN CO.

MAP DEPT.

DATE 7-24-68

Lorain Hall


ST.

18-00-027B