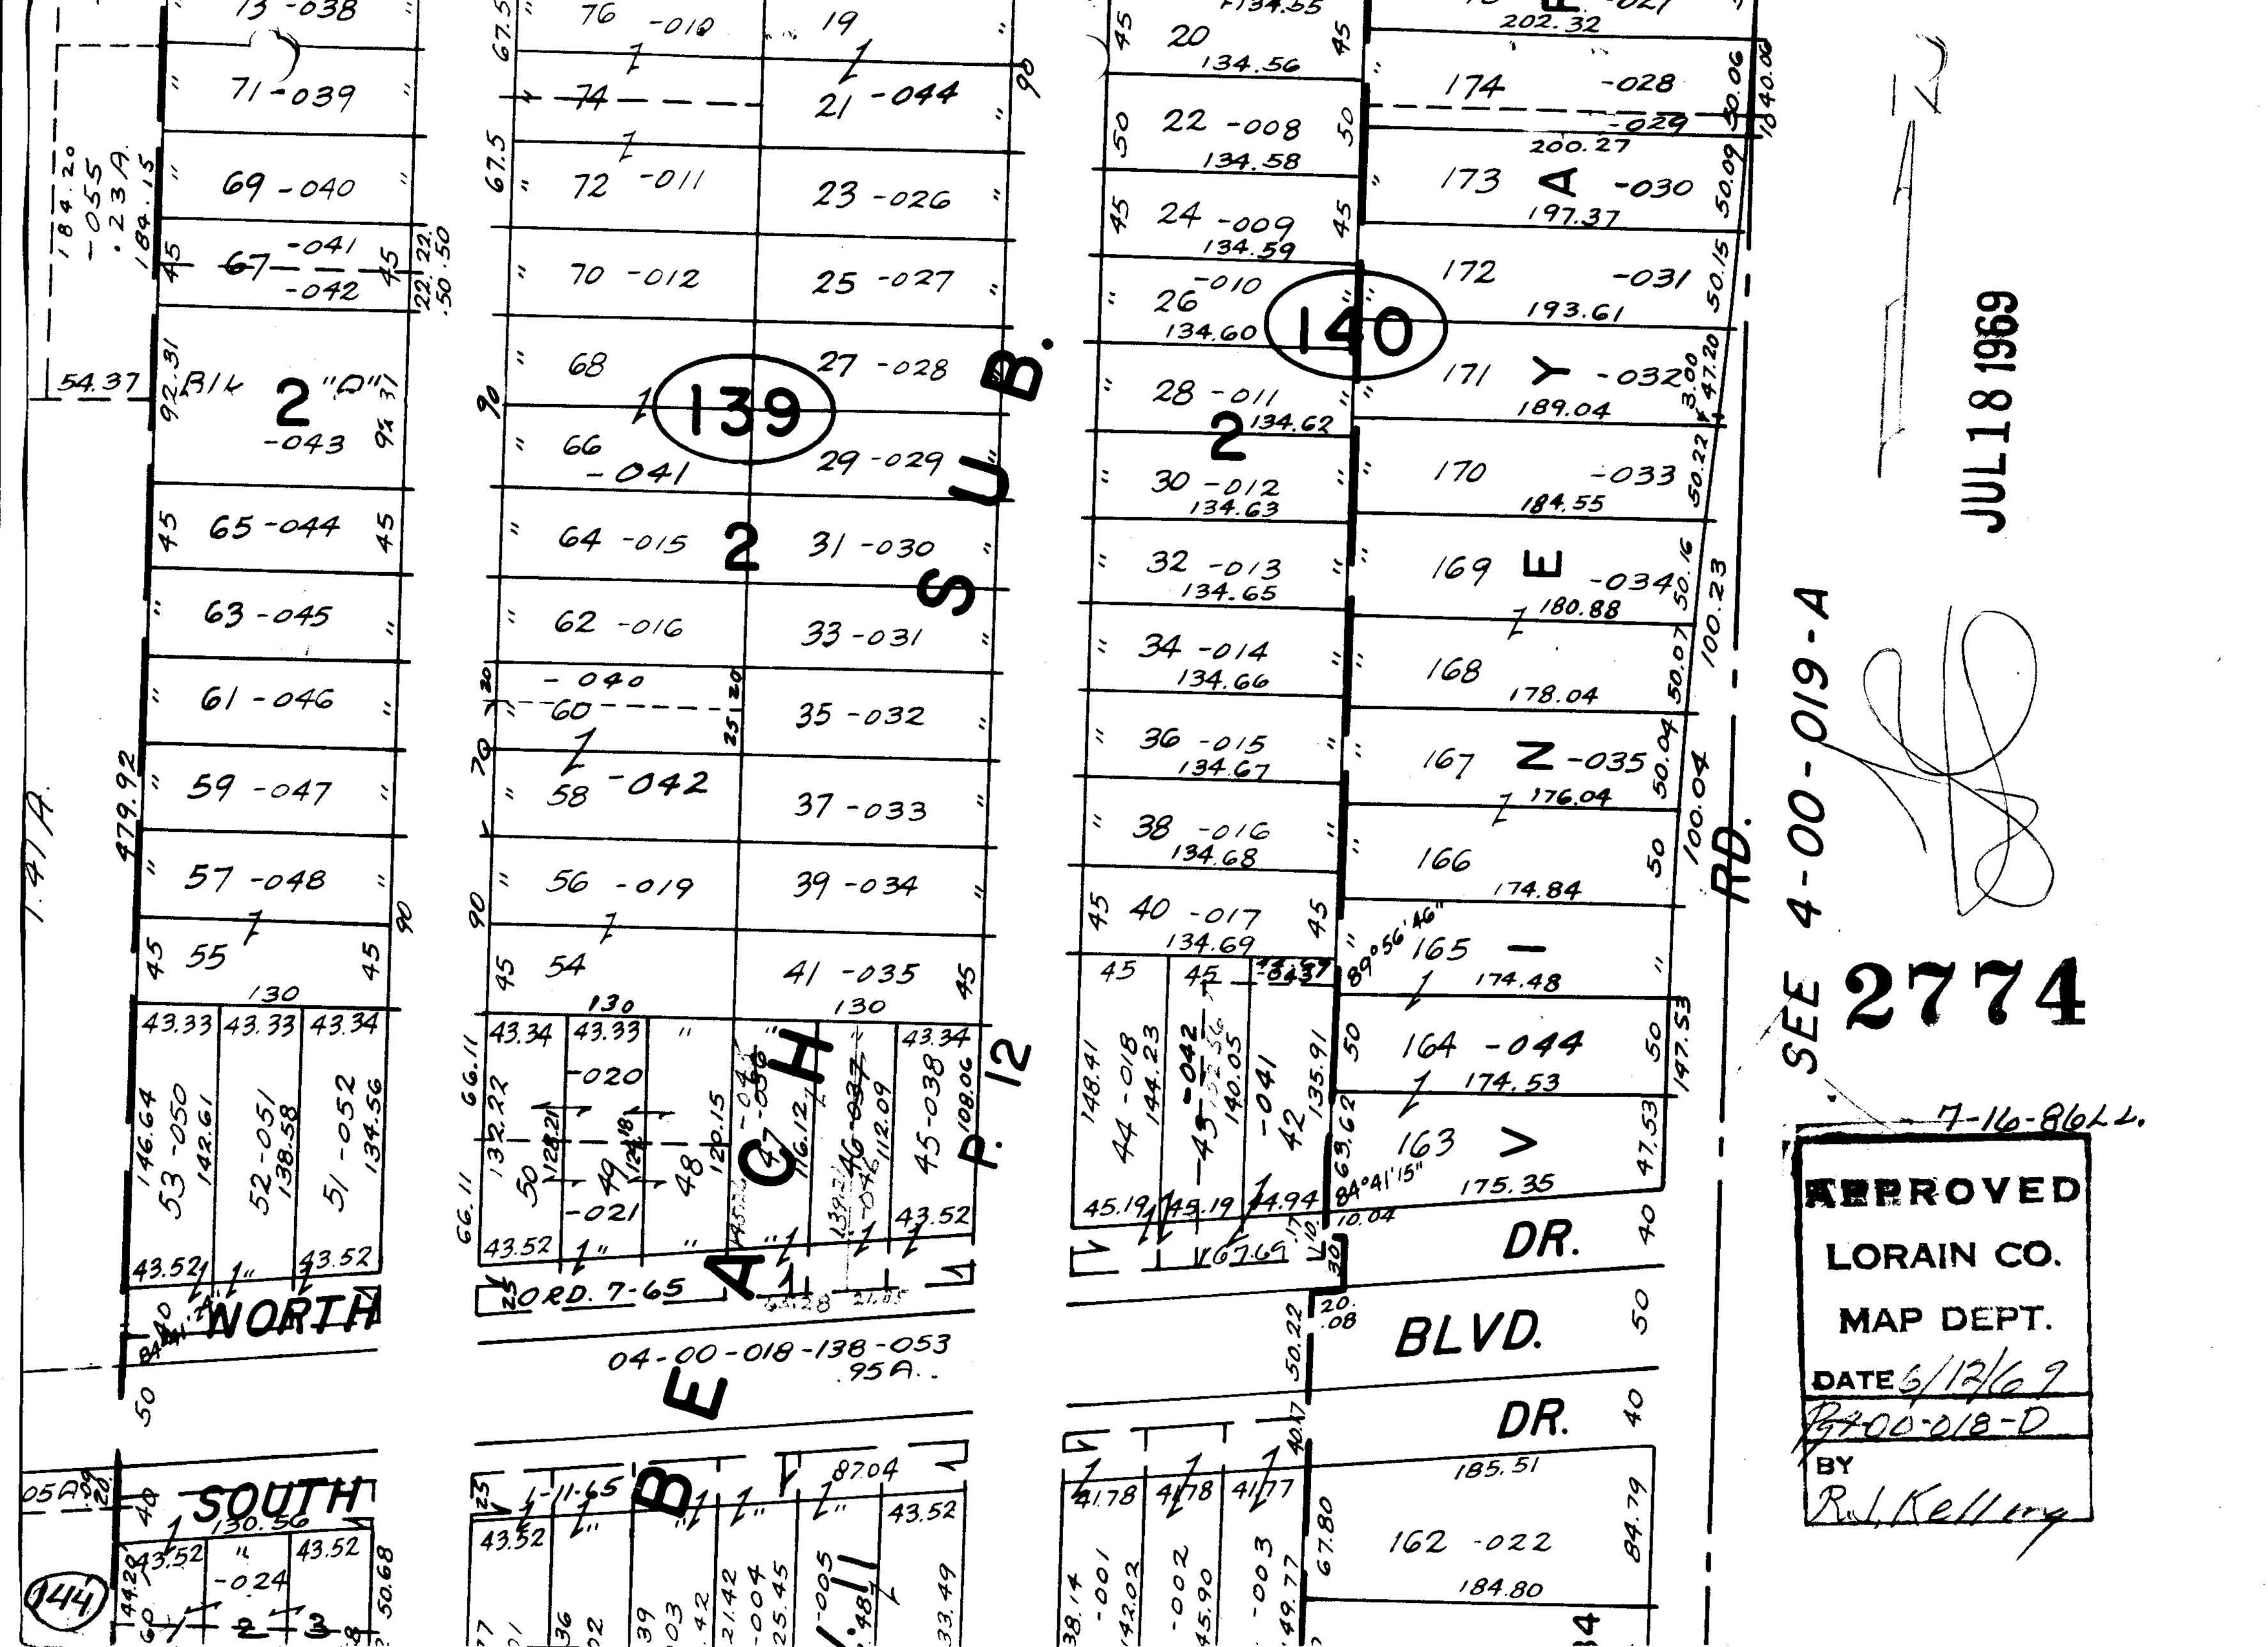

SEE 4-00-019-A
2774
JUL 18 1969
7-16-86 LL.
APPROVED
LORAIN CO.
MAP DEPT.
DATE 6/12/69
Pg 4-00-018-D
BY
R.J. Kelling
139
140
2
SUB.
BEACH
P. 12
NORTH
SOUTH
DR.
BLVD.
DR.
RD.
ORD. 7-65
04-00-018-138-053
.95A.
144