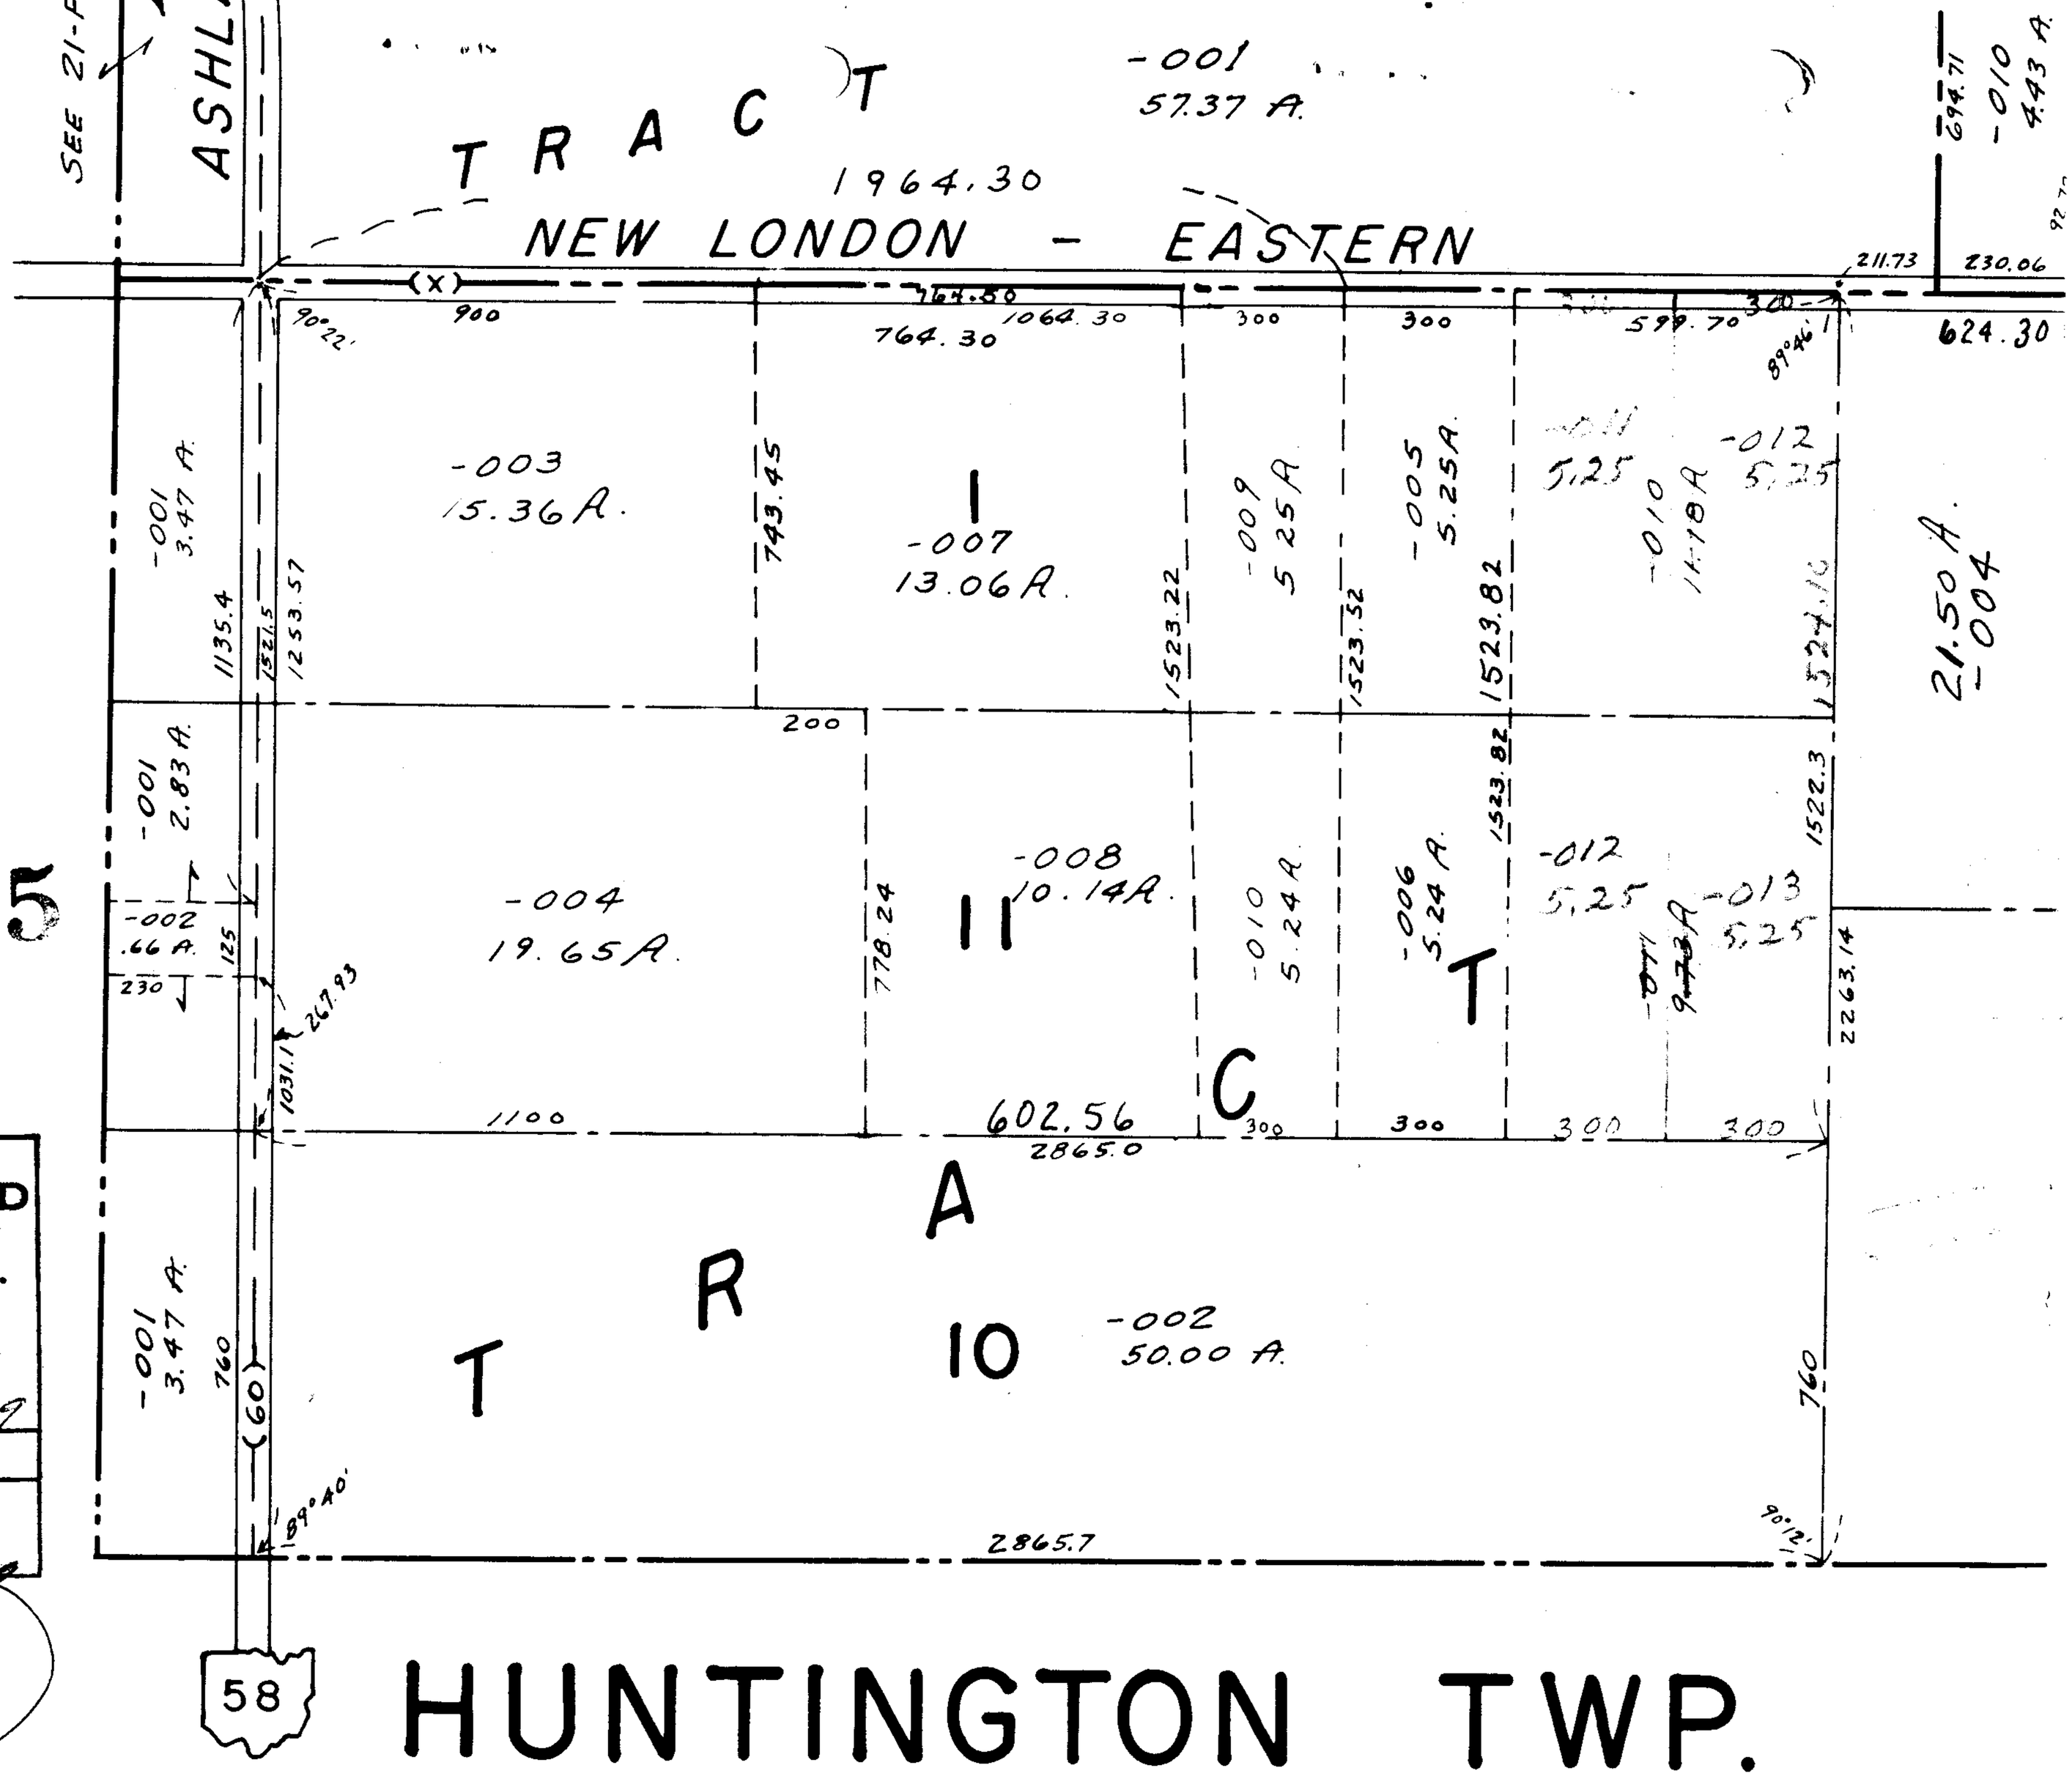

HUNTINGTON TWP.

SCALE: 1" = 400'

2775

AUG 4 1969

APPROVED
LORAIN CO.
MAP DEPT.
DATE 6/12/69
Pg 21-G
BY R. J. Kelling

1962
2-69
G