


# 2776  
 APPROVED  
 LORAIN CO.  
 MAP DEPT.  
 DATE 6/12/69  
 Dg. A-00-006-D  
 BY  
 R. Kelling

7-16-86 L.L.

E r i e  
 2776

JUL 18 1969

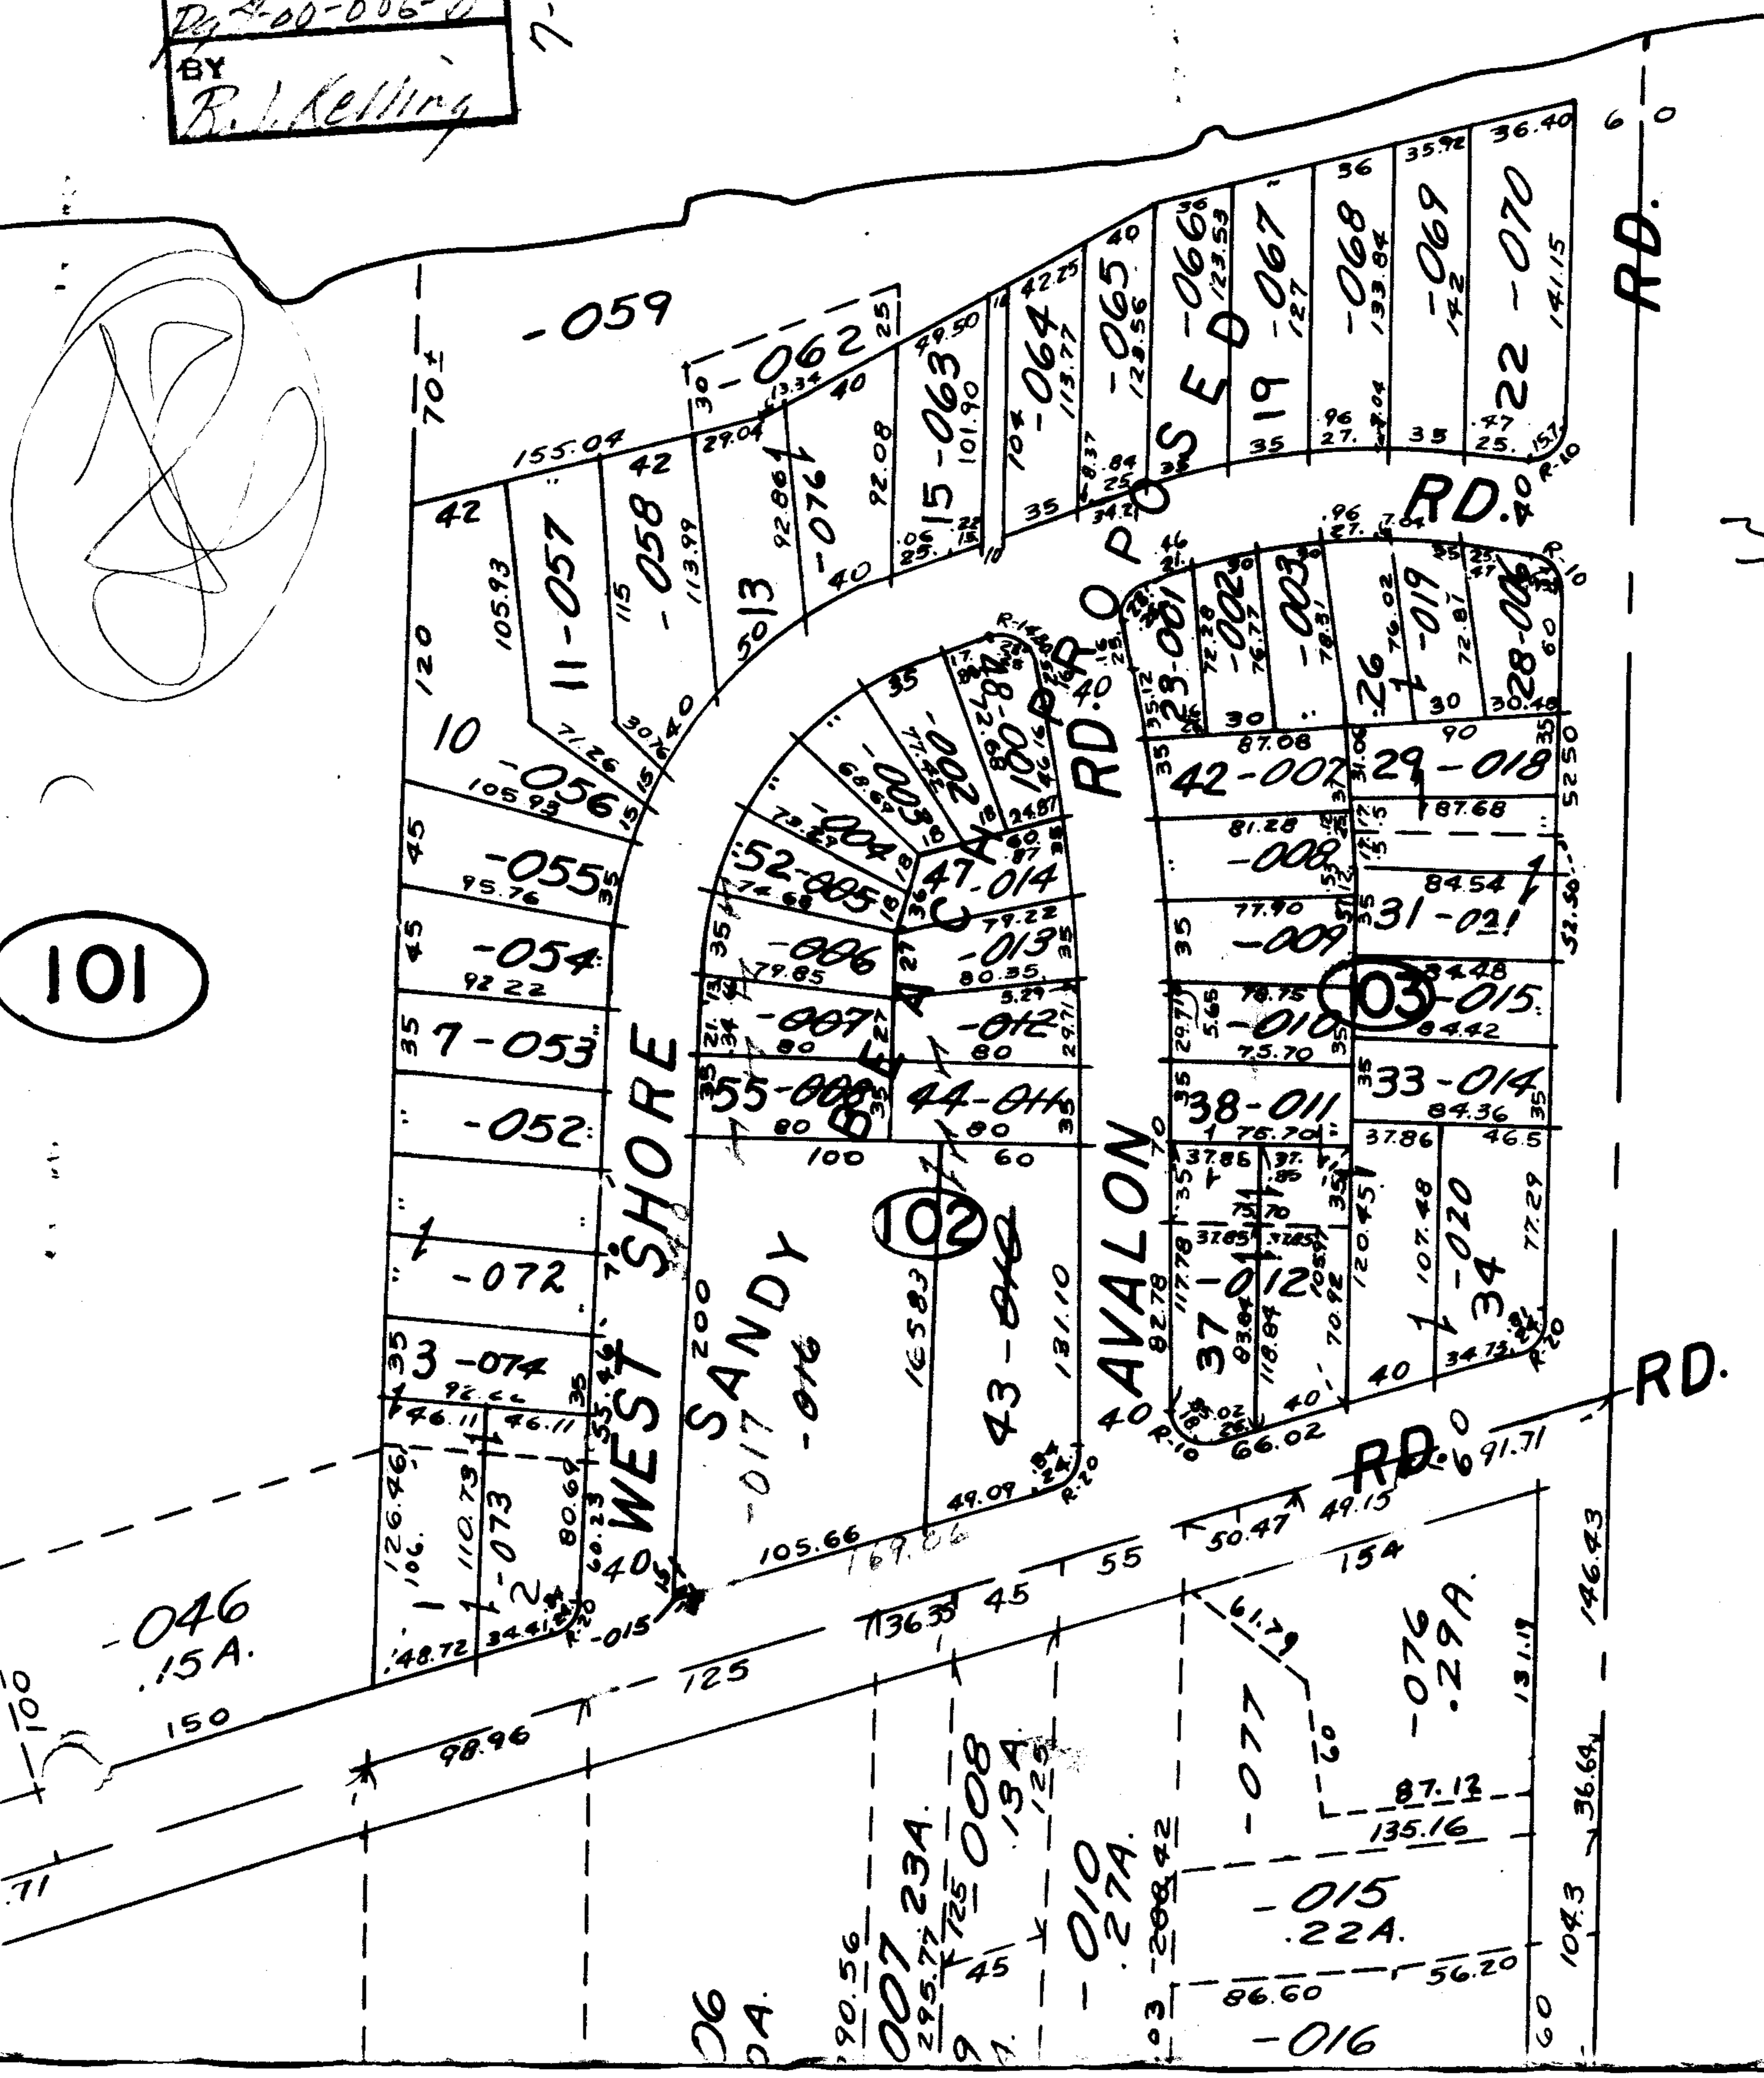

101

102

103

