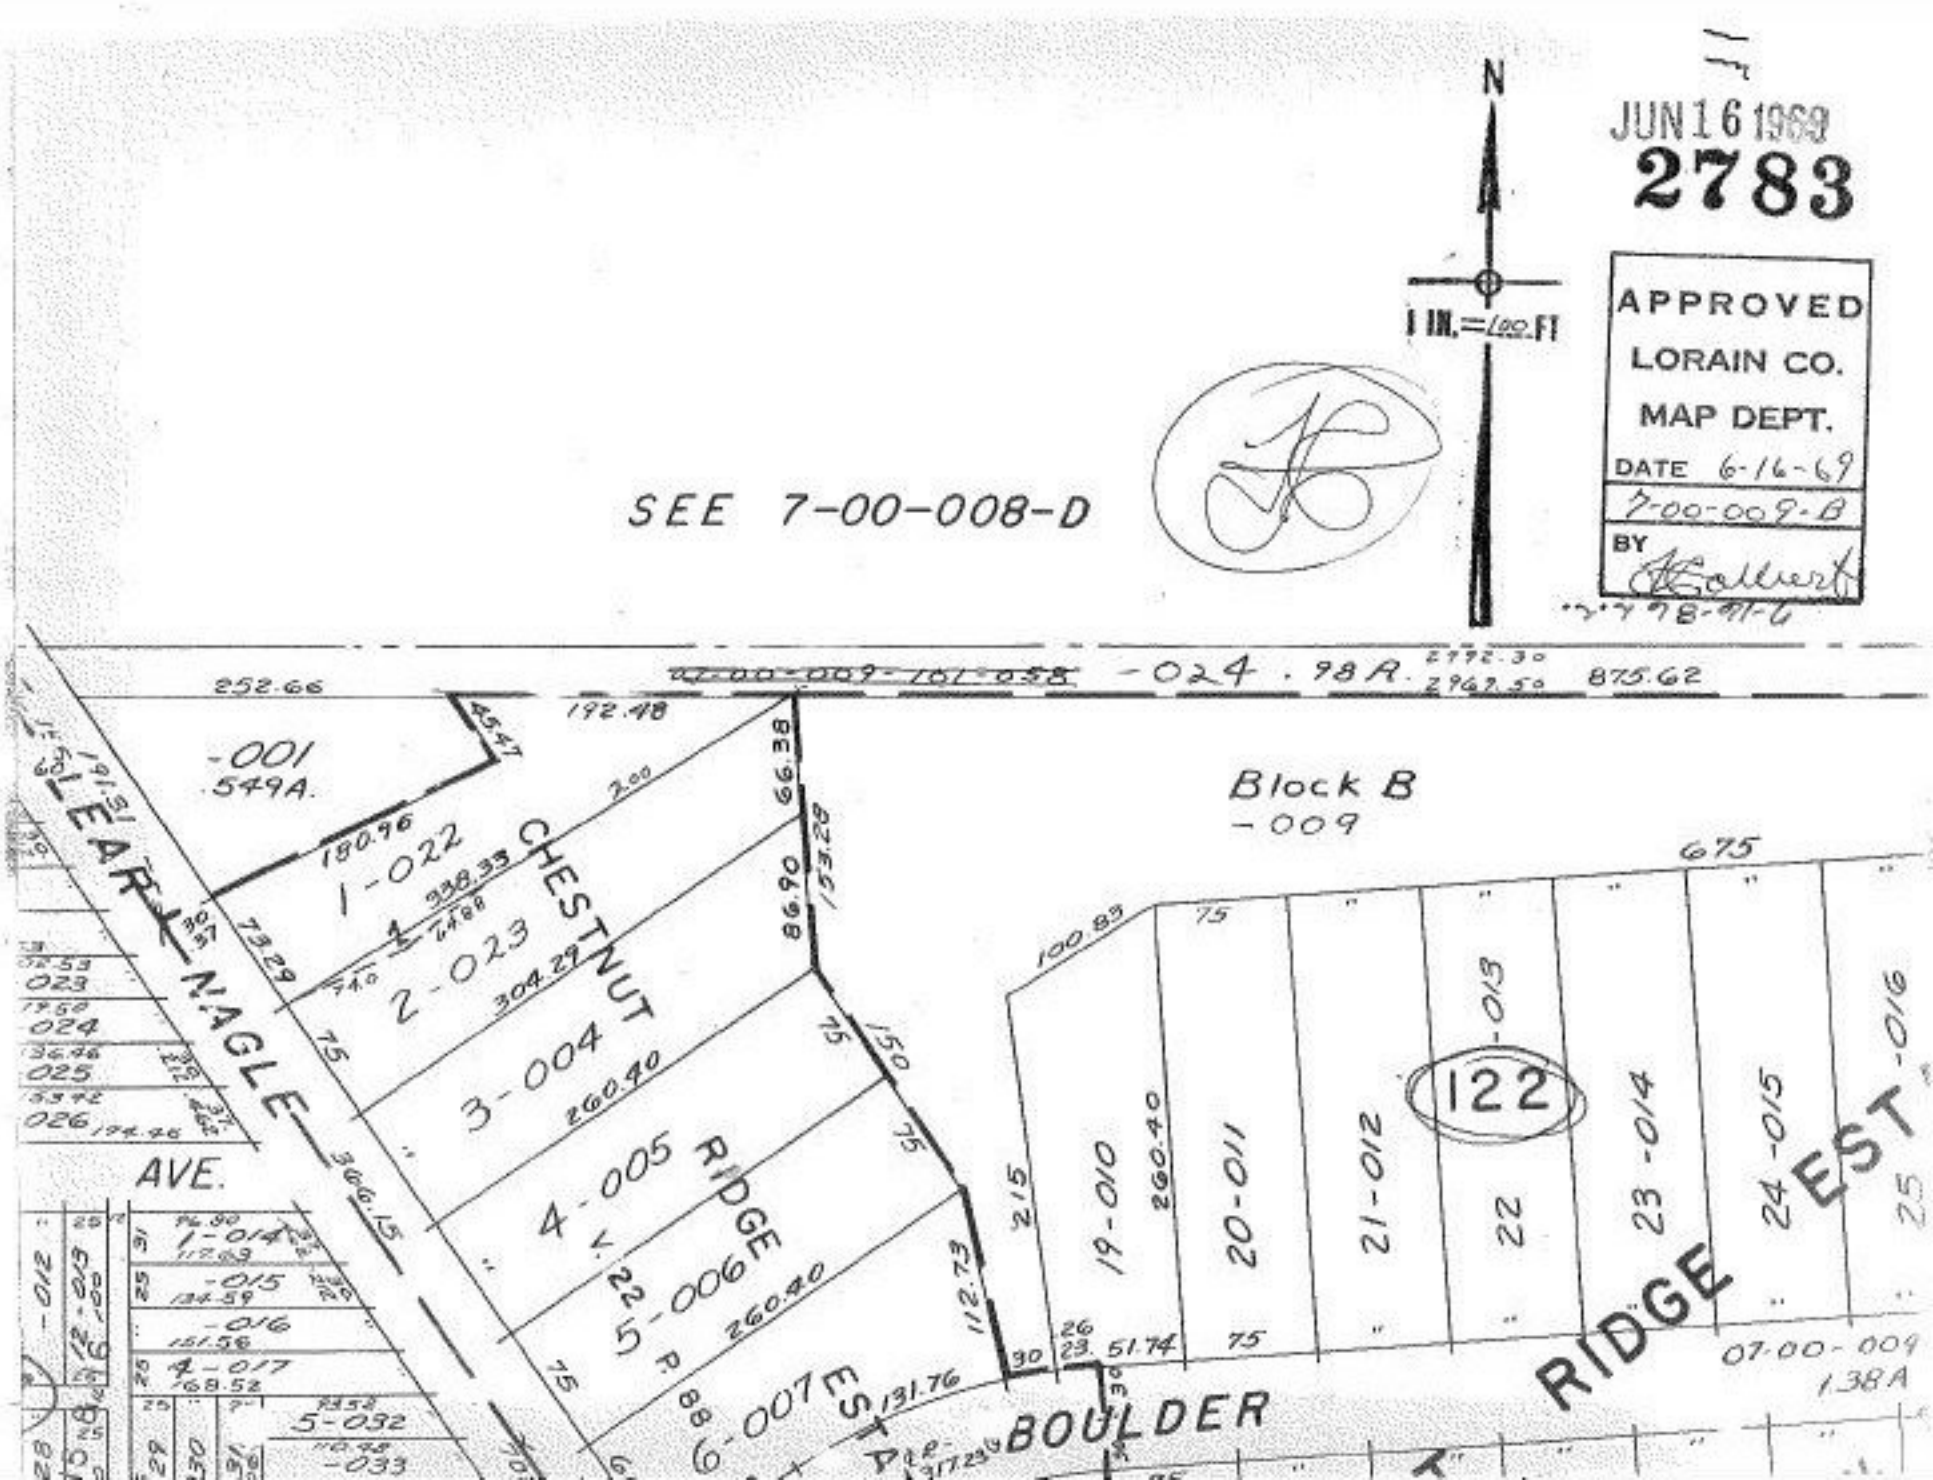
JUN 16 1969
2783
APPROVED
LORAIN CO.
MAP DEPT.
DATE 6-16-69
7-00-009-B
BY
N
1 IN. = 100 FT
SEE 7-00-008-D
7-00-009-101-038
-024 . 98 A.
252.66
192.48
45.47
-001
.549A.
180.96
1-022
2-023
3-004
4-005
5-006
6-007
CHESTNUT
RIDGE
LEAR NAGLE
AVE.
Block B
-009
675
100.89
75
215
19-010
20-011
21-012
122
22
23-014
24-015
-013
-016
260.40
112.73
131.76
BOULDER
RIDGE EST
07-00-009
1.38A
66.38
86.90
153.28
304.29
73.29
366.15
150
51.74
23.
26
30
2772.30
2962.50
875.62