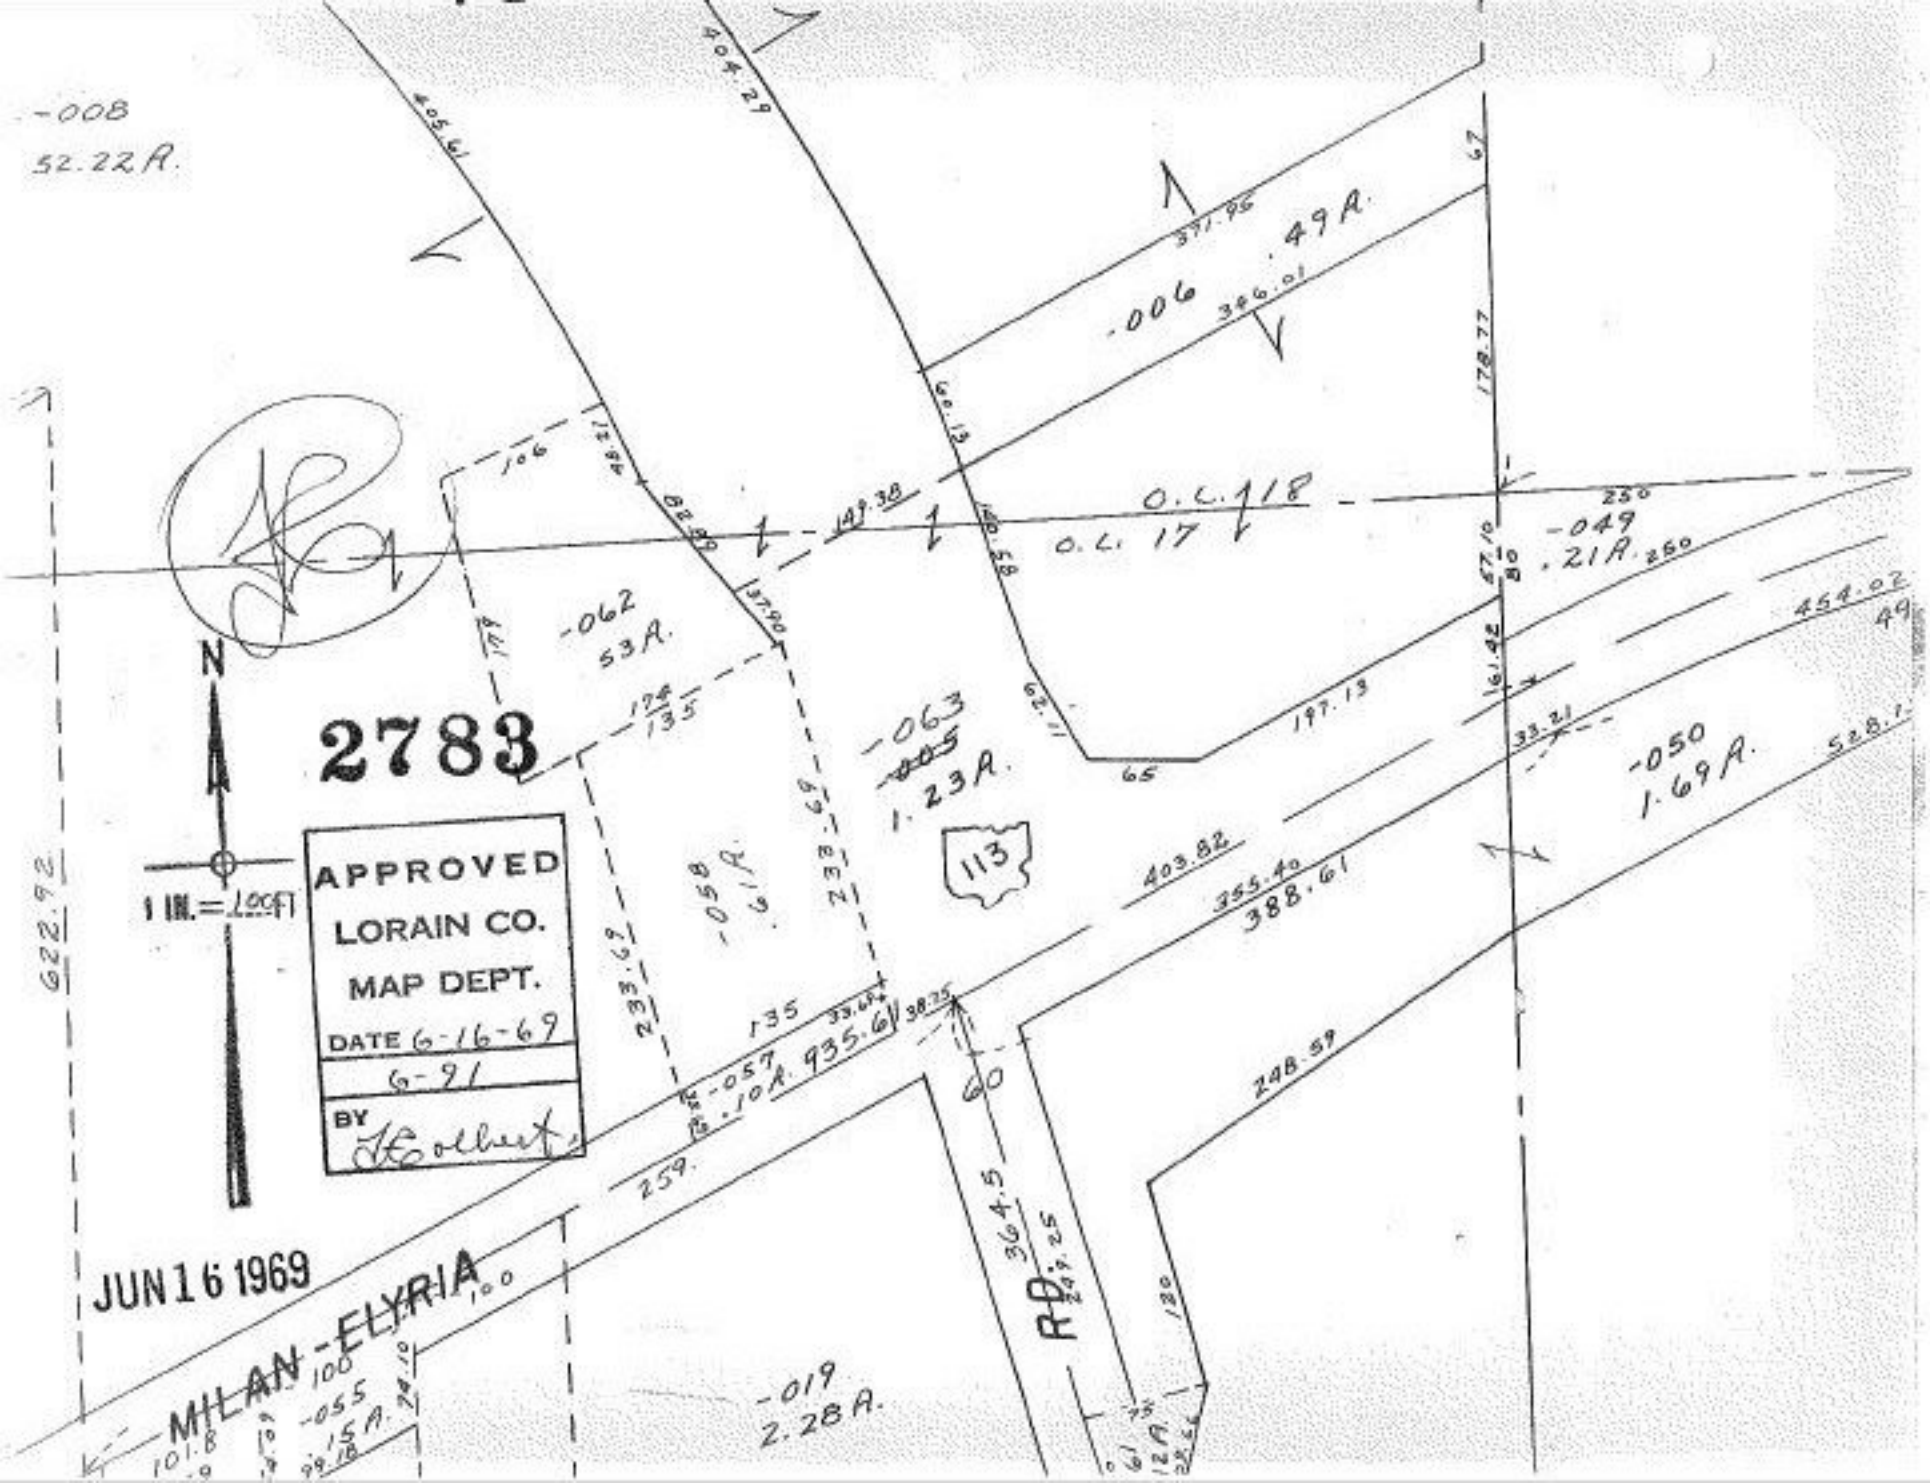
-008
52.22A.
404.29
405.61
-006
.49A.
366.01
371.95
178.77
67
O.L. 18
O.L. 17
-049
.21A.
-062
53A.
-063
1.23A.
-058
6.1A.
-057
.10A.
-050
1.69A.
-019
2.28A.
2783
APPROVED
LORAIN CO.
MAP DEPT.
DATE 6-16-69
6-91
BY
1 IN. = 100 FT
JUN 16 1969
MILAN-ELYRIA
RD.
113
N
622.92
403.82
355.40
388.61
454.02
528.7
248.59
364.5
259.
233.69
135
197.13
65
80
60
120
100