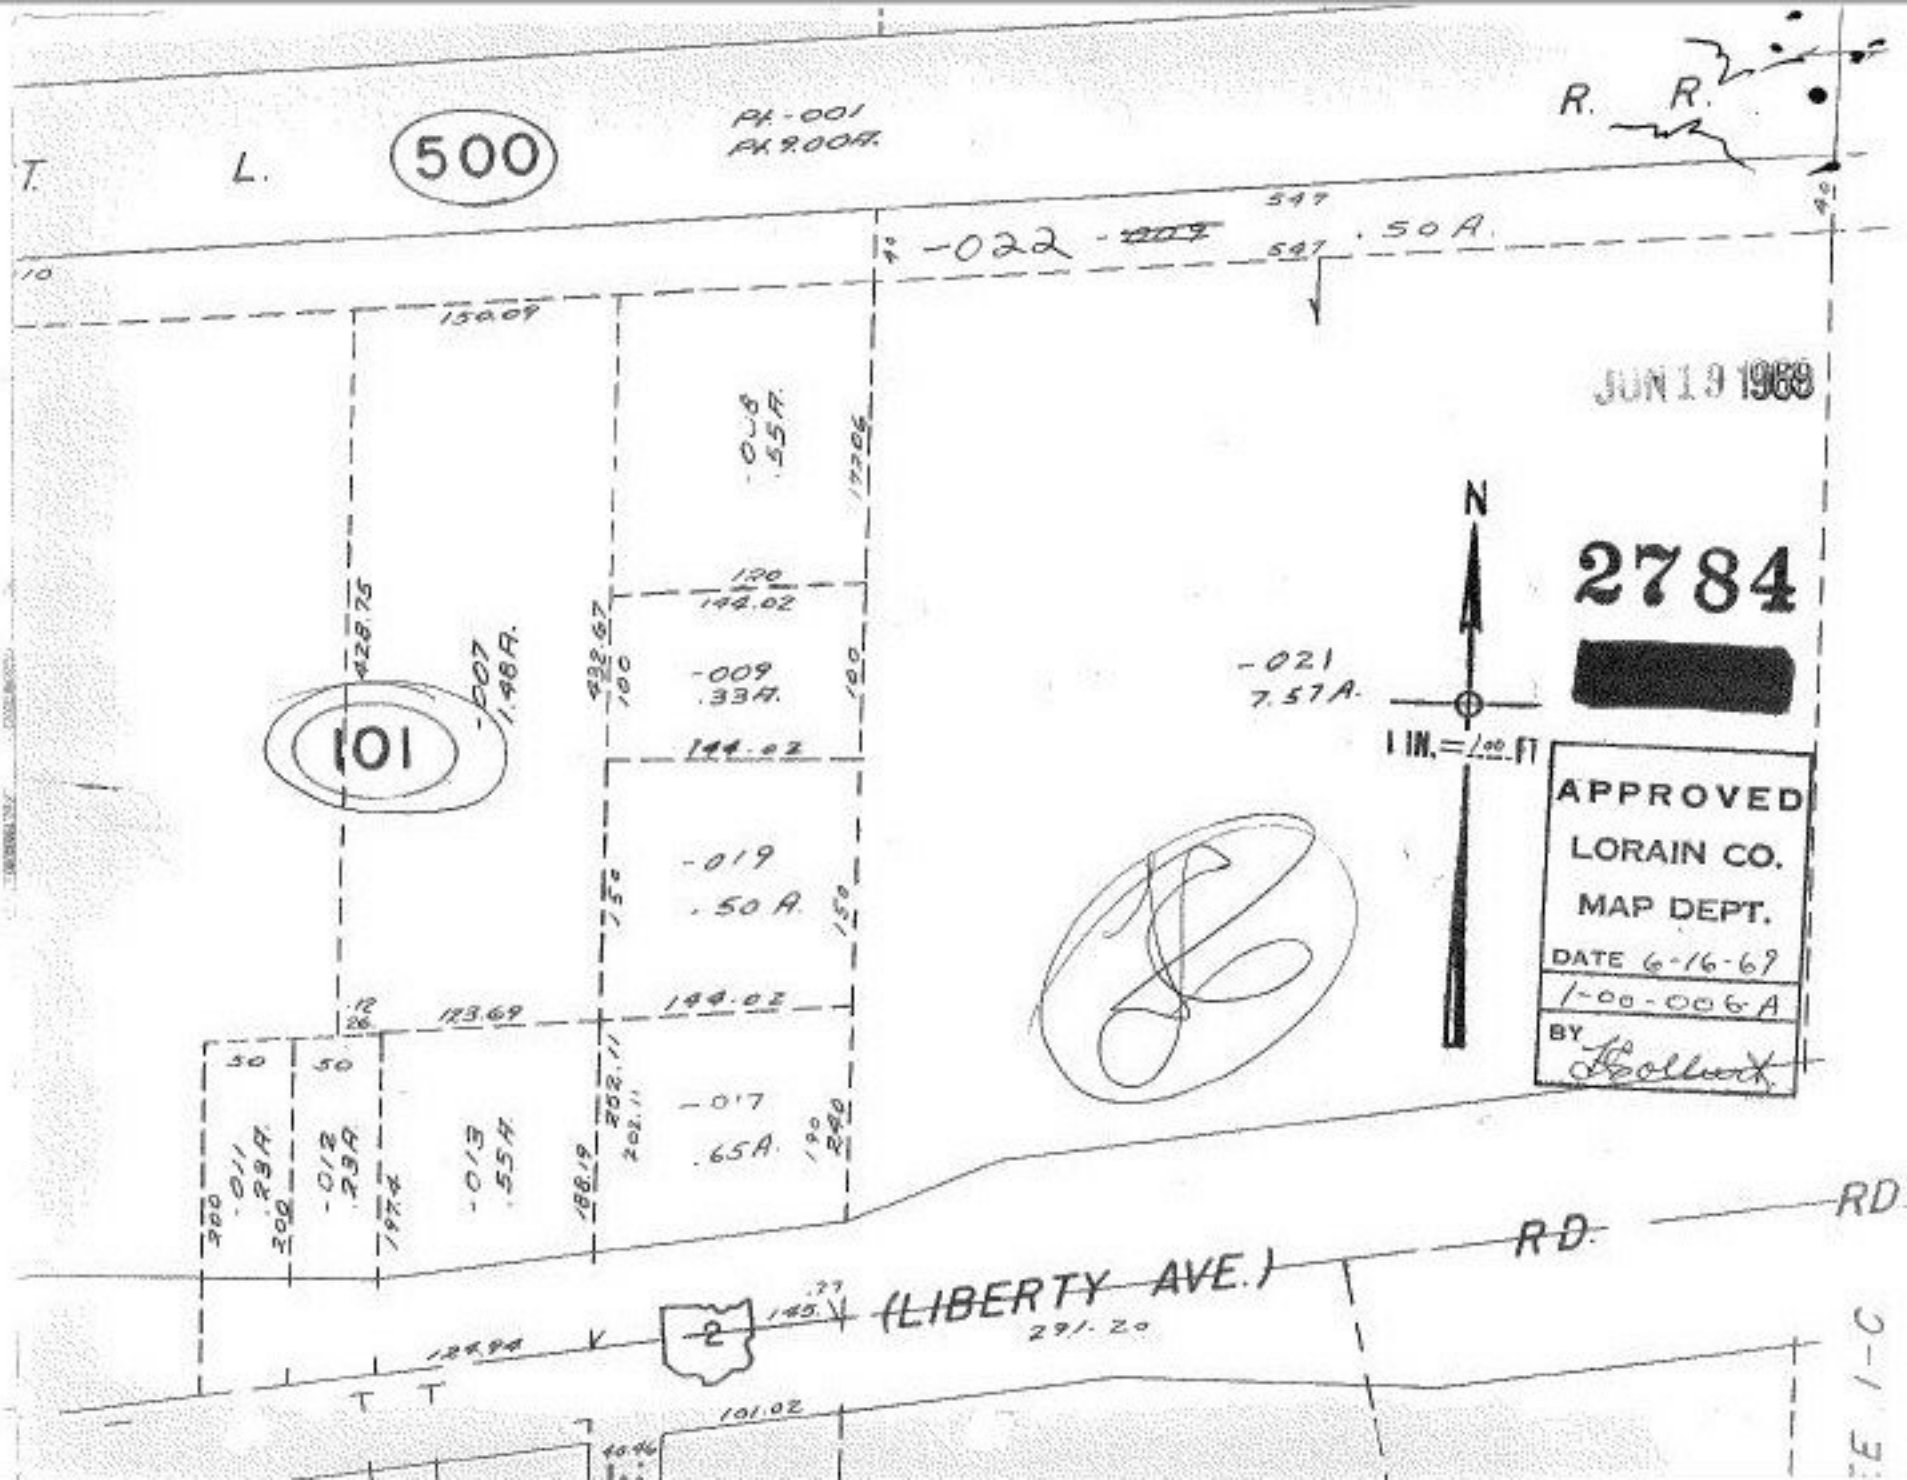

T. L.
500
Pt.-001
Pt. 9.00A.
R. R.
-022 -009 .50 A.
547
150.09
-008 .55A.
177.06
120
144.02
428.75
-007 1.48A.
432.67
100
-009 .33A.
101
144.02
-019 .50 A.
150
123.69
144.02
50
50
-011 .23A.
-012 .23A.
-013 .55A.
-017 .65A.
202.11
188.19
197.4
200
240
-021 7.57A.
N
1 IN. = 100 FT
JUN 19 1969
2784
[redacted]
APPROVED
LORAIN CO.
MAP DEPT.
DATE 6-16-69
1-00-006-A
BY
RD.
RD.
(LIBERTY AVE.)
291.20
2
145.
124.94
101.02
40.46