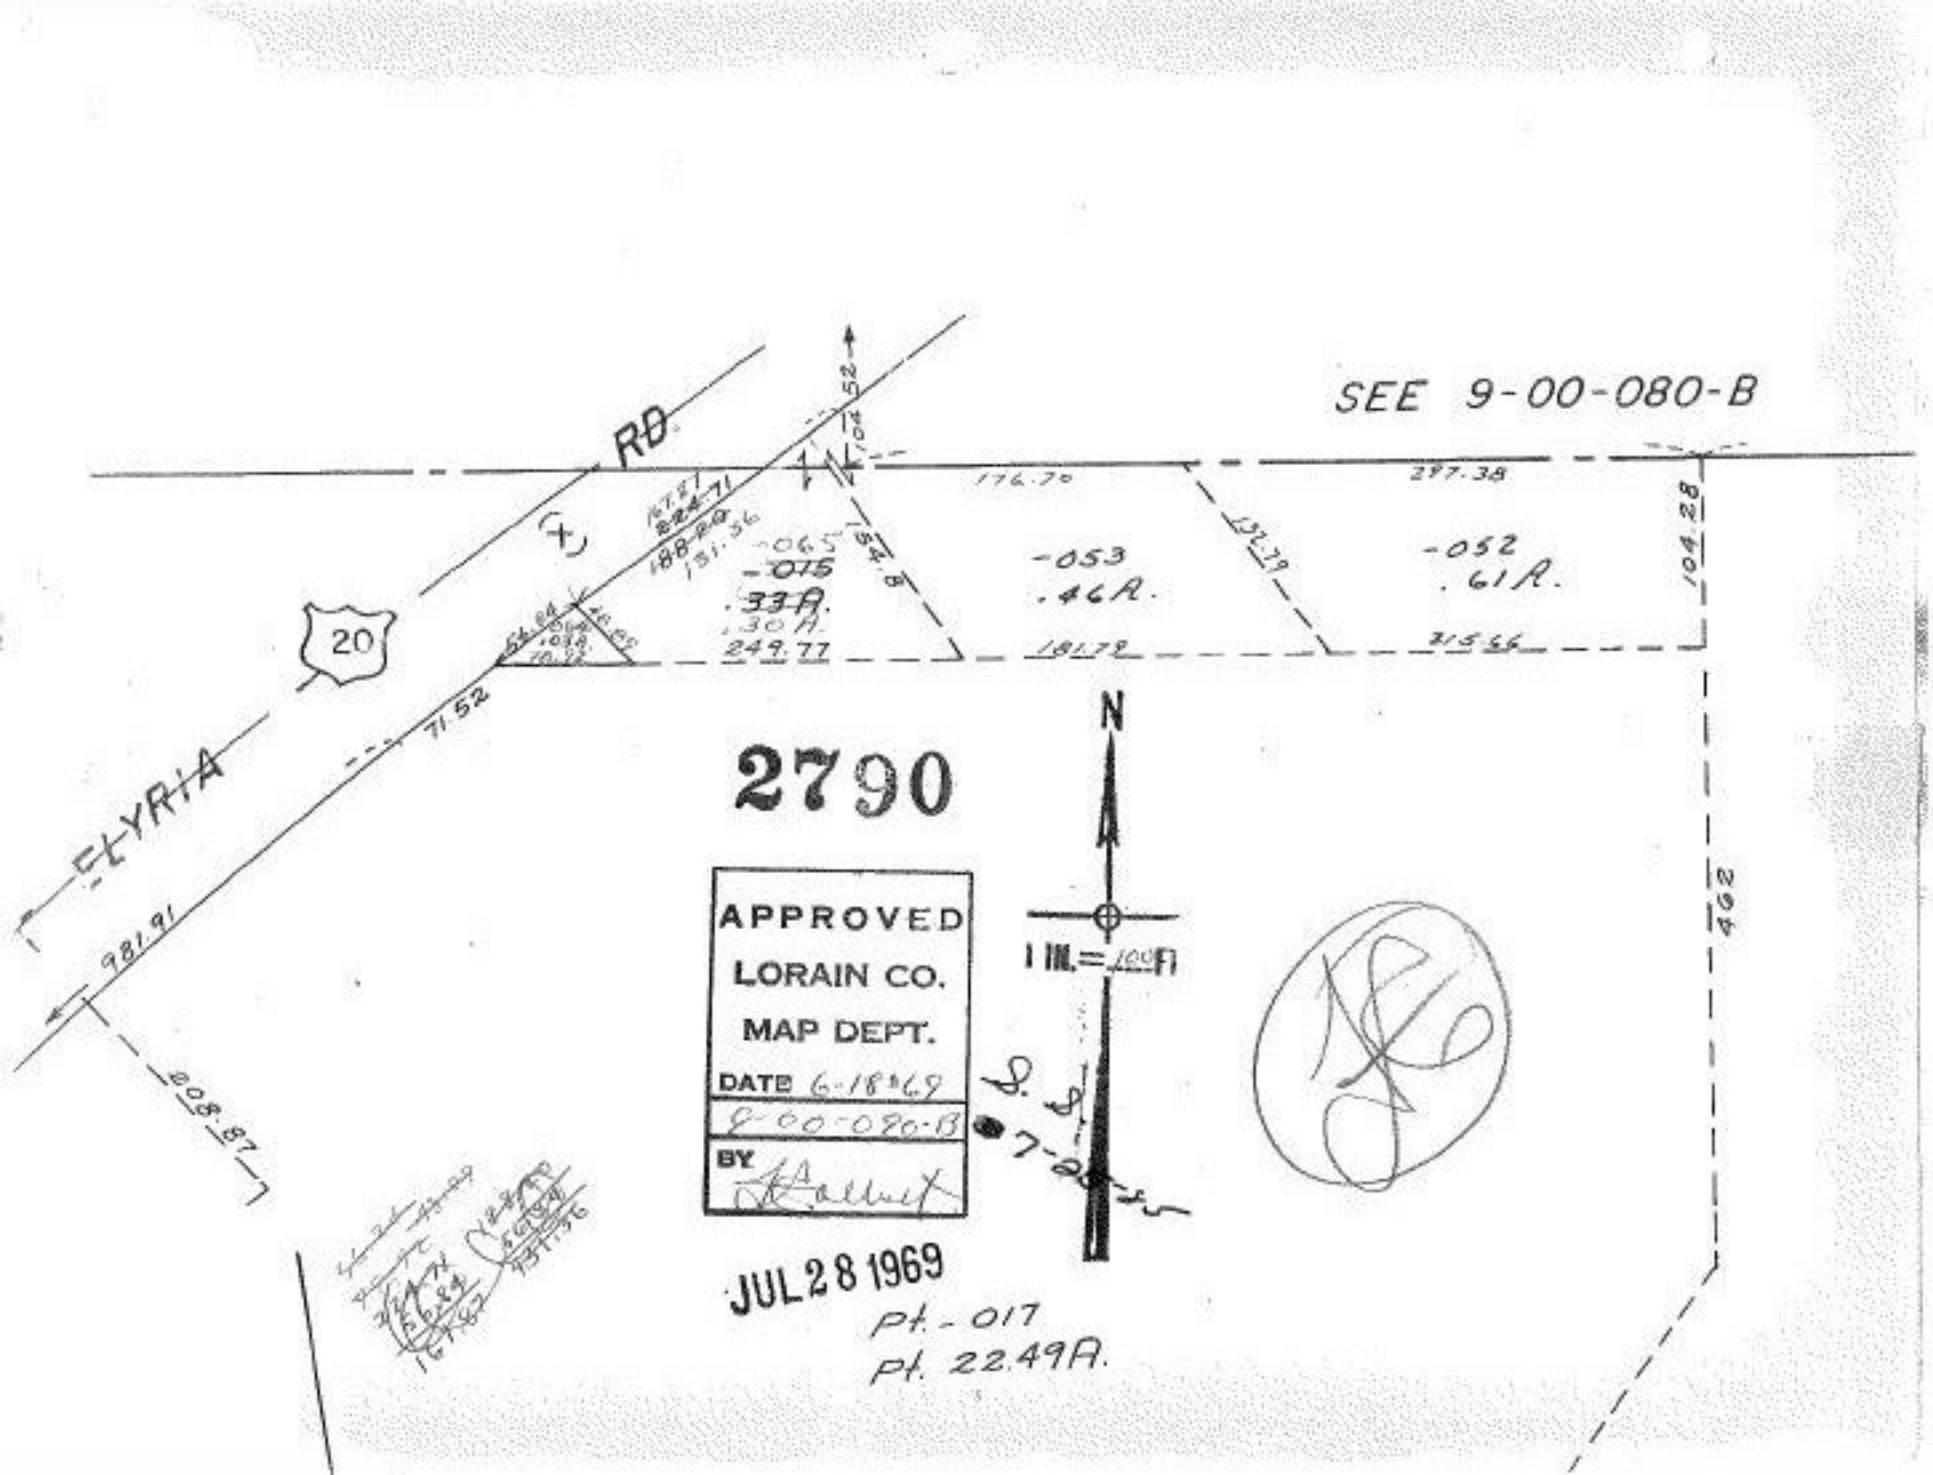
SEE 9-00-080-B
RD.
20
ELYRIA
71.52
981.91
208.87
176.70
297.38
104.28
462
-053
.46A.
-052
.61A.
-015
.33A.
.30 A.
249.77
315.56
N
1 IN. = 100 FT.
2790
APPROVED
LORAIN CO.
MAP DEPT.
DATE 6-18-69
9-00-080-B
BY
JUL 28 1969
pt. - 017
pt. 22.49A.