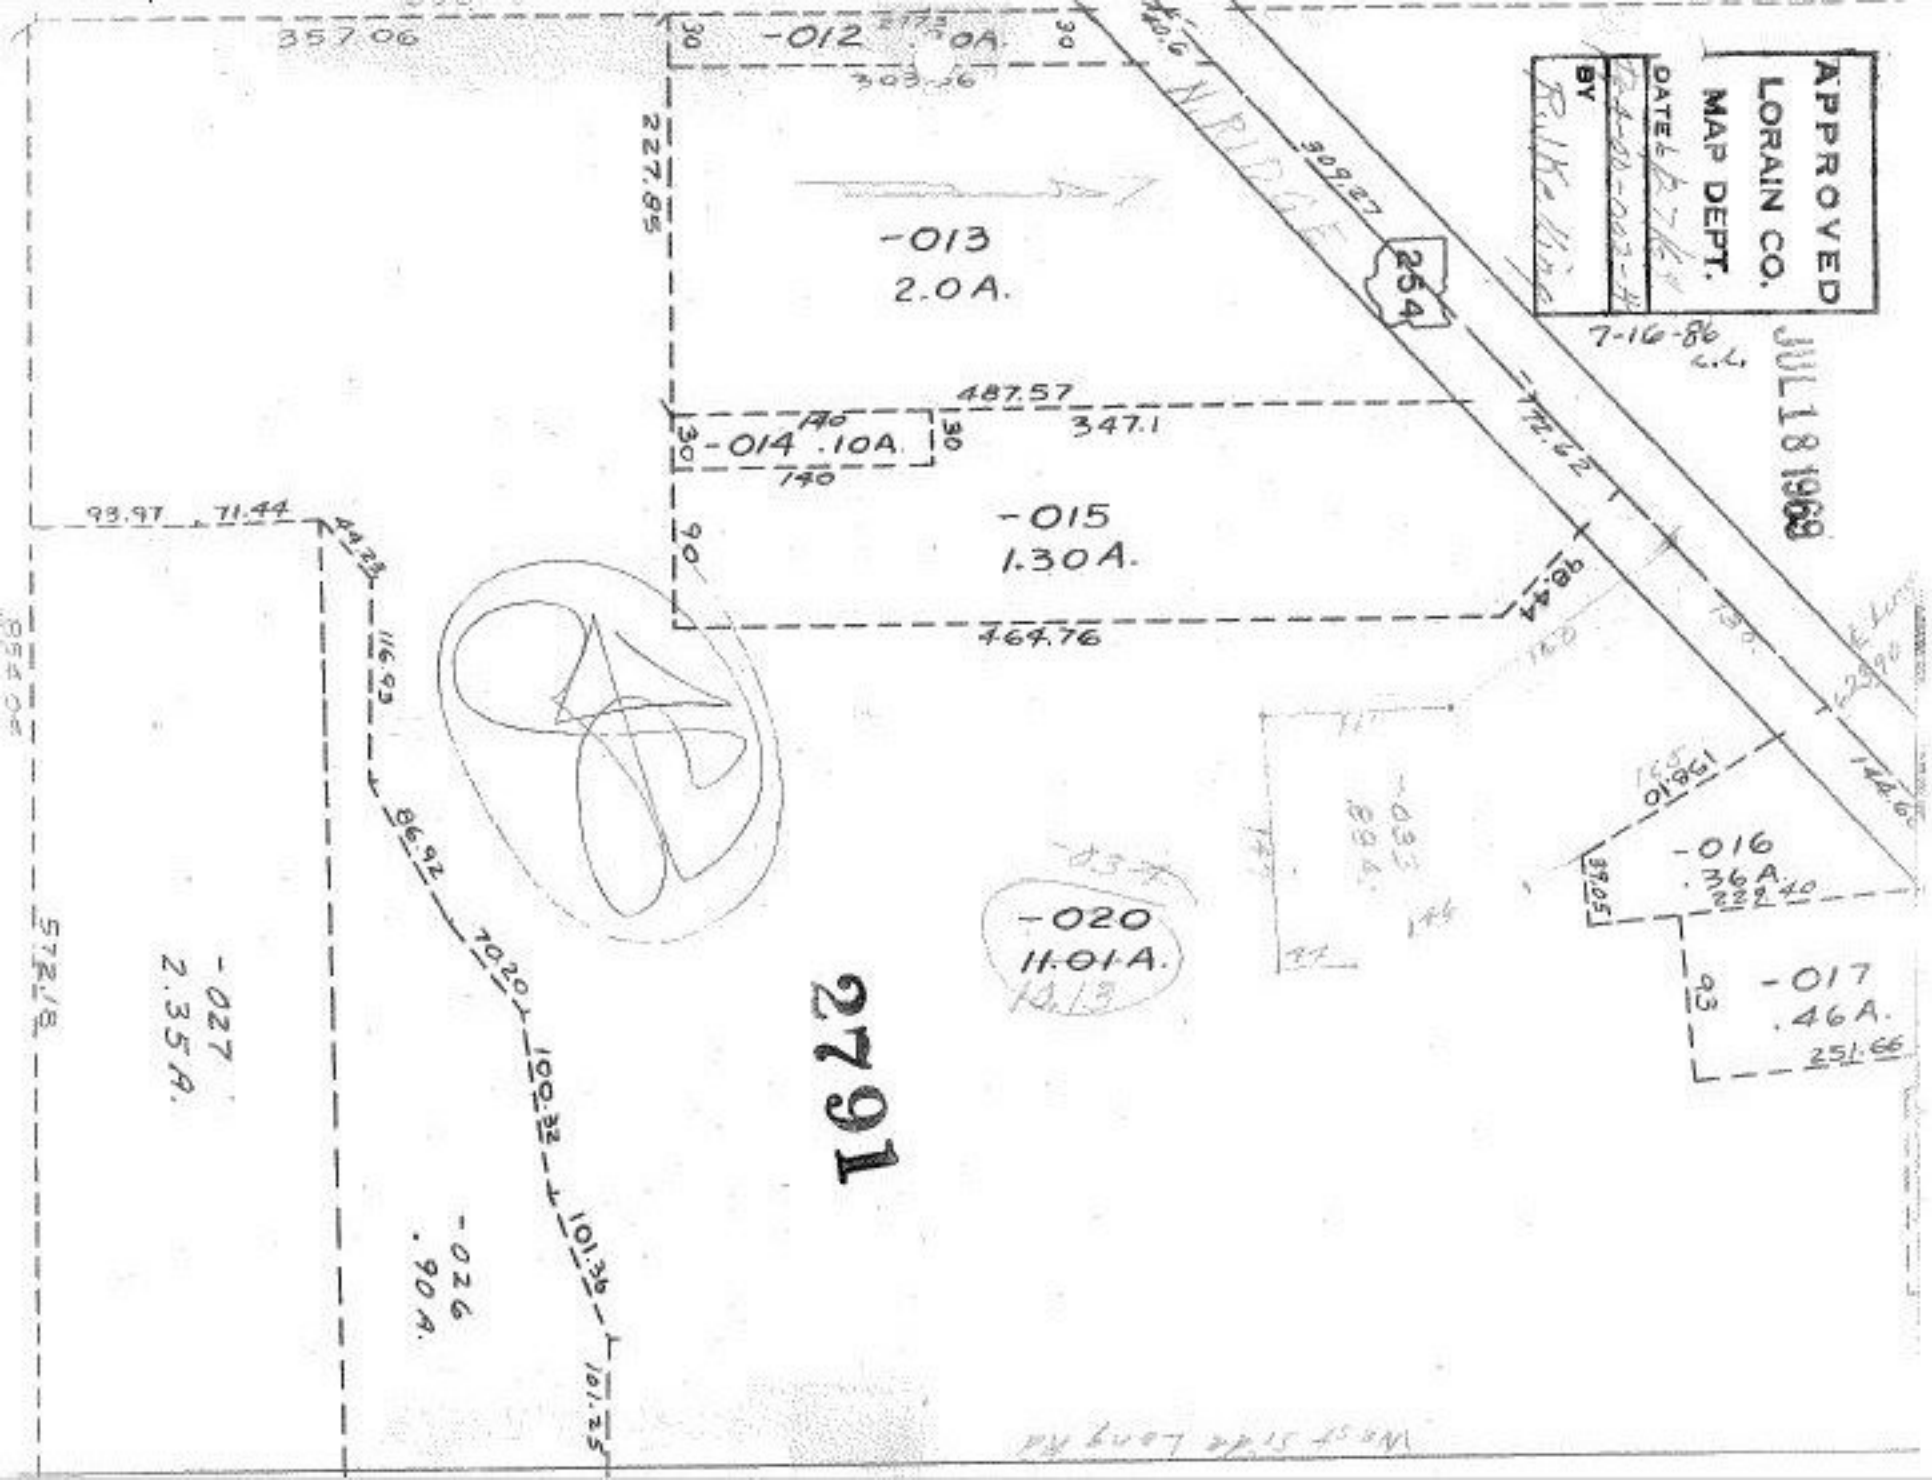
APPROVED
LORAIN CO.
MAP DEPT.
DATE
BY
7-16-86
JUL 18 1969
-012 .0A.
-013
2.0A.
-014 .10A.
-015
1.30A.
-016
.36A.
-017
.46A.
-020
11.01A.
-027
2.35A.
-026
.90A.
254
2791
357.06
227.85
487.57
347.1
464.76
93.97
71.44
116.93
86.92
70.20
100.32
101.36
101.25
309.27
772.62
98.44
144.66
251.66
229.40
39.05
93
90
30
140
N RIDGE