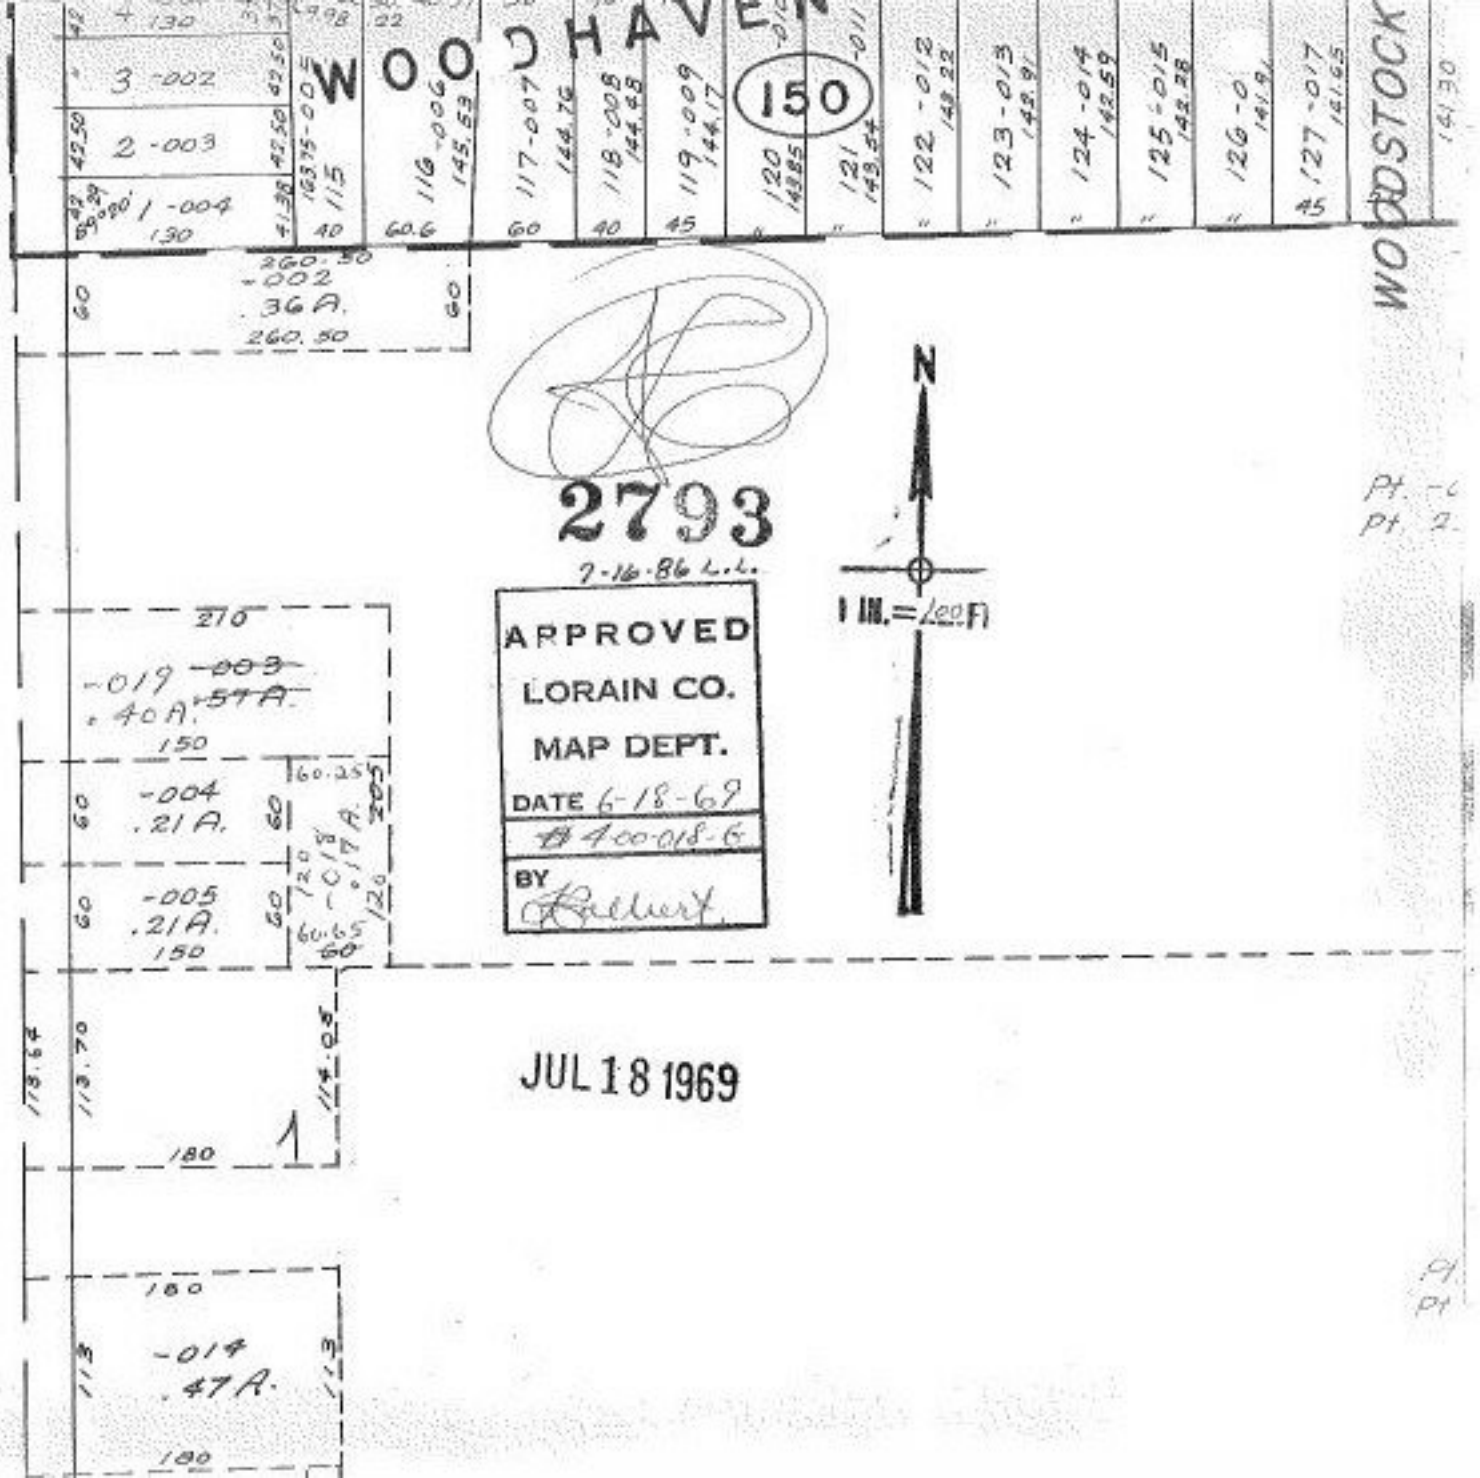
WOODHAVEN
150
WOODSTOCK
3 -002
2 -003
1 -004
130
116-006
145.53
117-007
144.76
118-008
144.48
119-009
144.17
120
143.85
121
143.54
122-012
143.22
123-013
143.91
124-014
142.59
125-015
142.28
126-0
141.91
127-017
141.65
141.30
260.50
-002
.36 A.
260.50
N
1 IN. = 100 FT
2793
7-16-86 L.L.
APPROVED
LORAIN CO.
MAP DEPT.
DATE 6-18-69
#4-00-018-6
BY
JUL 18 1969
210
-019 ~~-003~~
.40 A. ~~.57 A.~~
150
-004
.21 A.
-005
.21 A.
150
60.25
60.65
205
120
-018
.17 A.
113.64
113.70
114.05
180
180
-014
.47 A.
180
Pt. -
Pt. 2
Pt.
Pt.

57
17
40