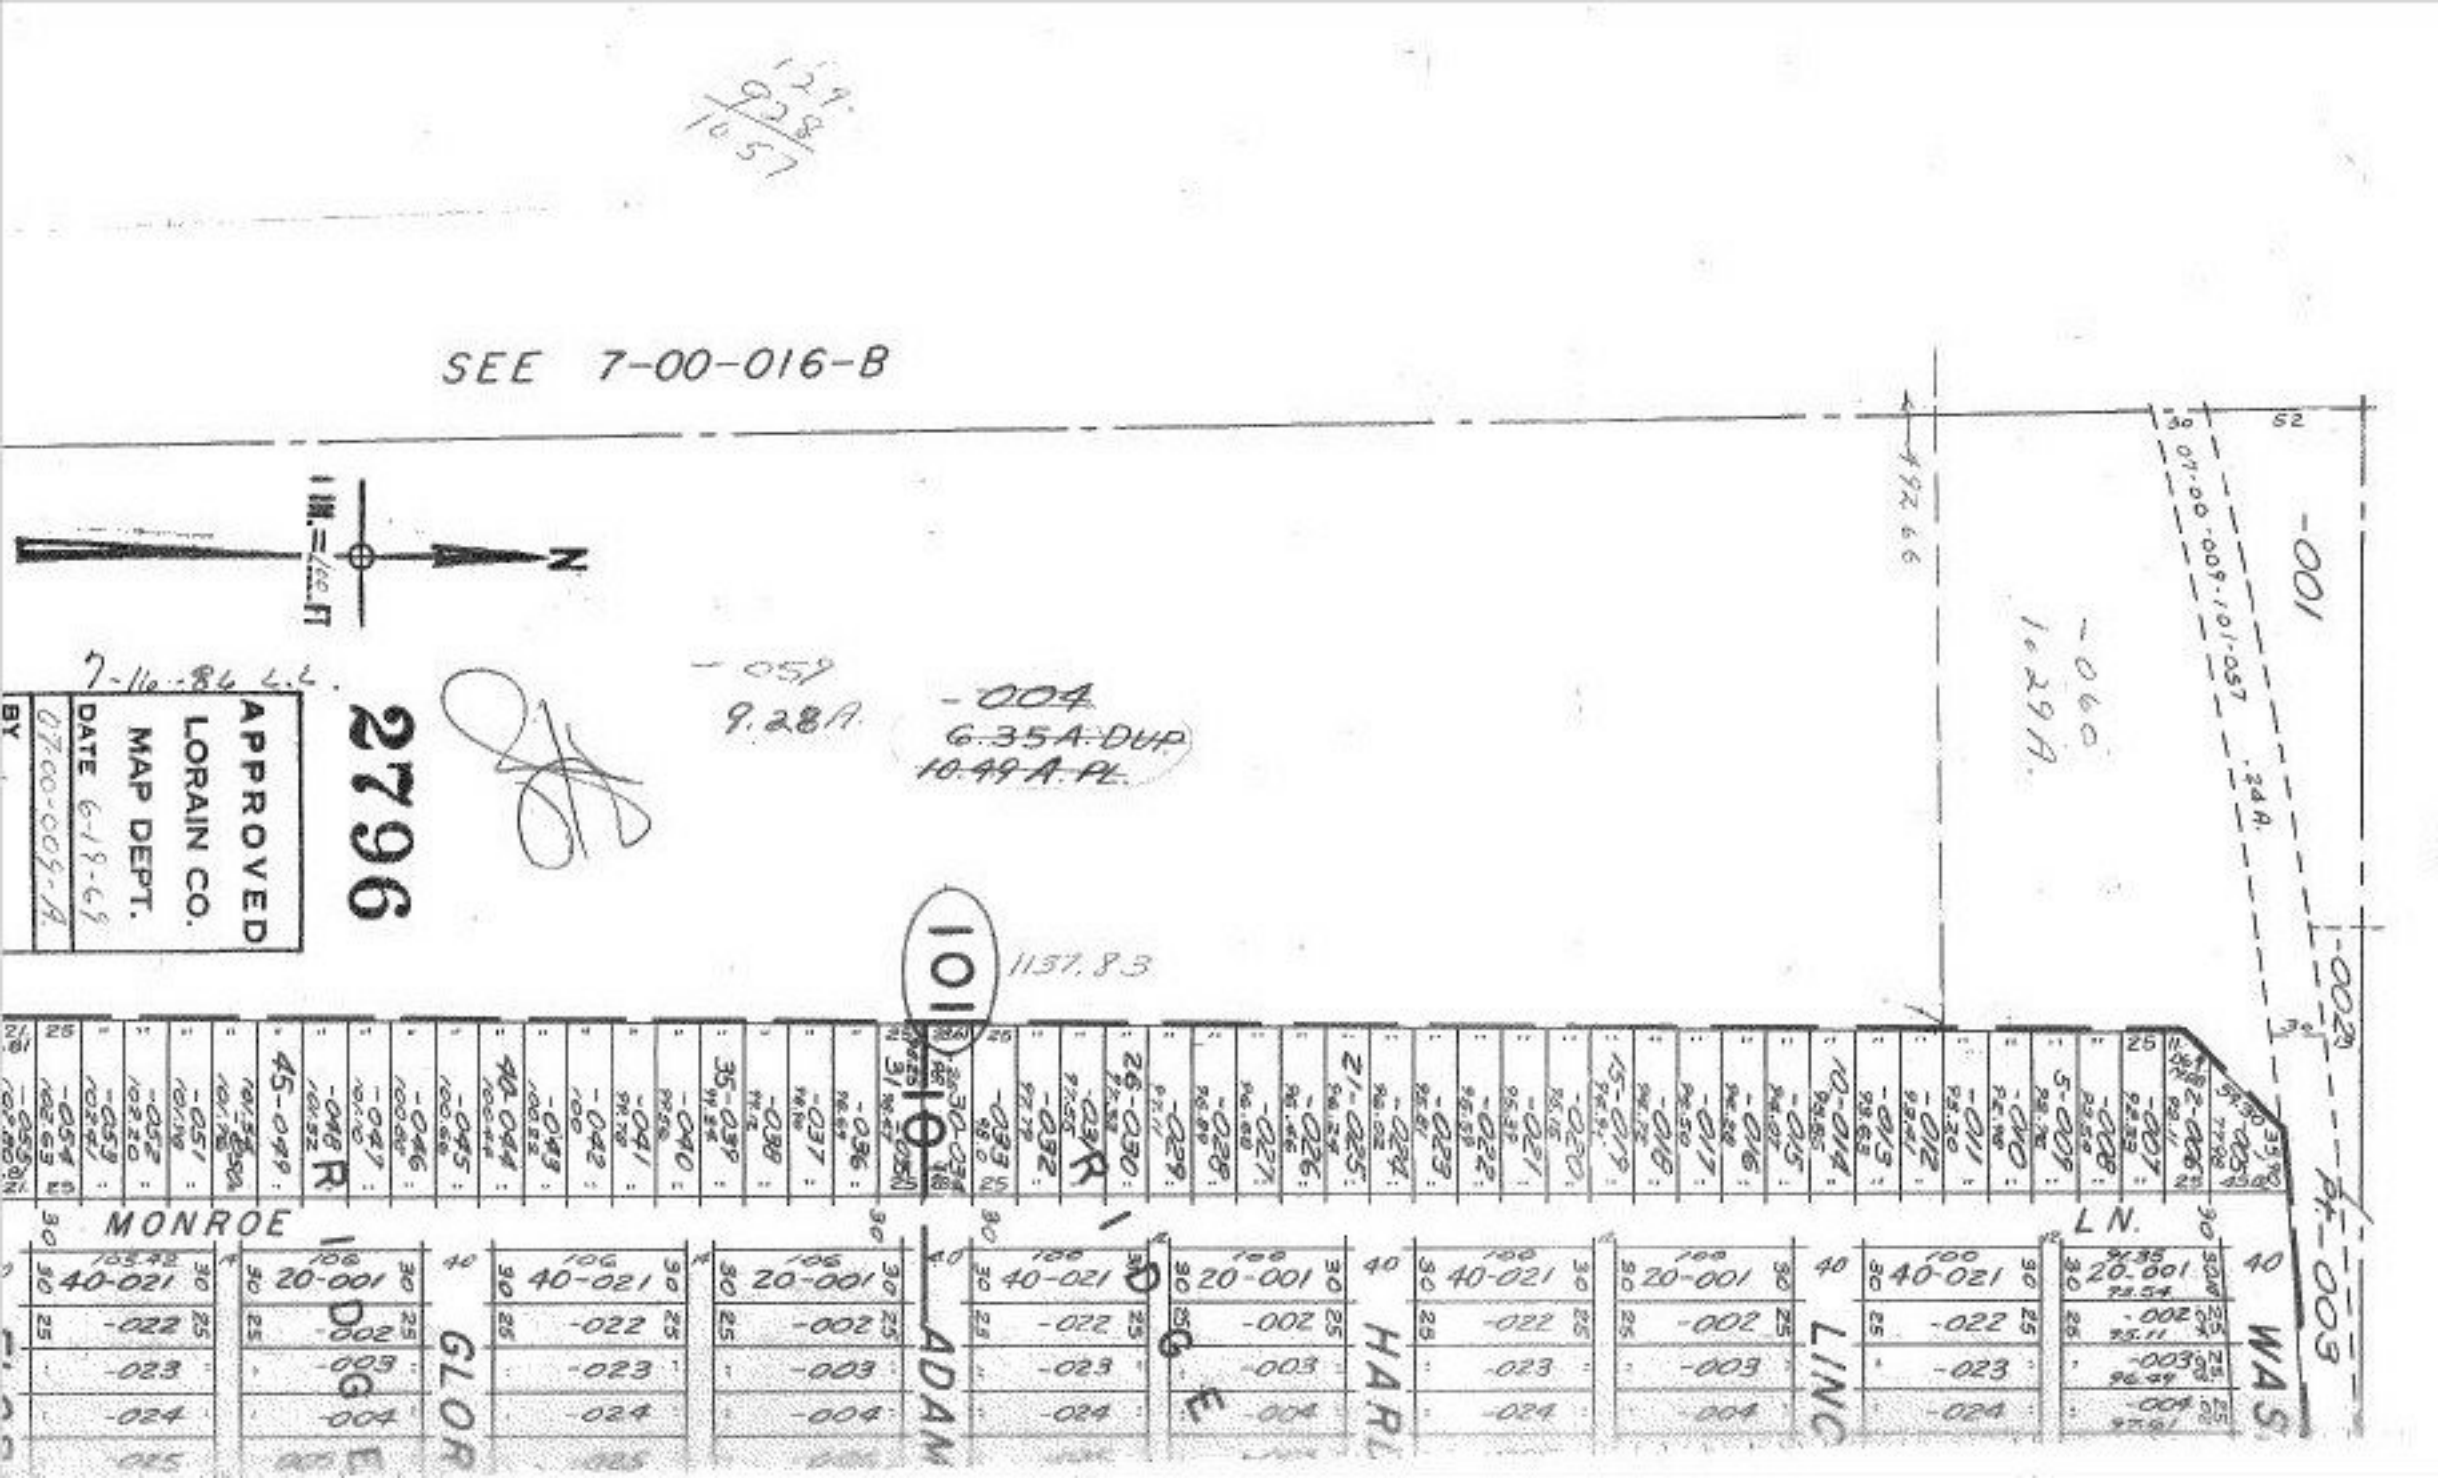

SEE 7-00-016-B
N
1 IN. = 100 FT
7-16-86 L.L.
APPROVED
LORAIN CO.
MAP DEPT.
DATE 6-19-69
07-00-009-A
BY
2796
-059
9.28A.
-004
6.35A. DUP
10.49 A. PL.
1137.83
101
10
MONROE
LN.
GLOR
ADAM
HARL
LINC
WAS
-001
-002
-003
-060
1.29A.
07-00-009-101-057
.24A.
Pt.-003