#2

APPROVED
LORAIN CO.
MAP DEPT.
DATE 6/23/60
BY R. J. Kelling

2806
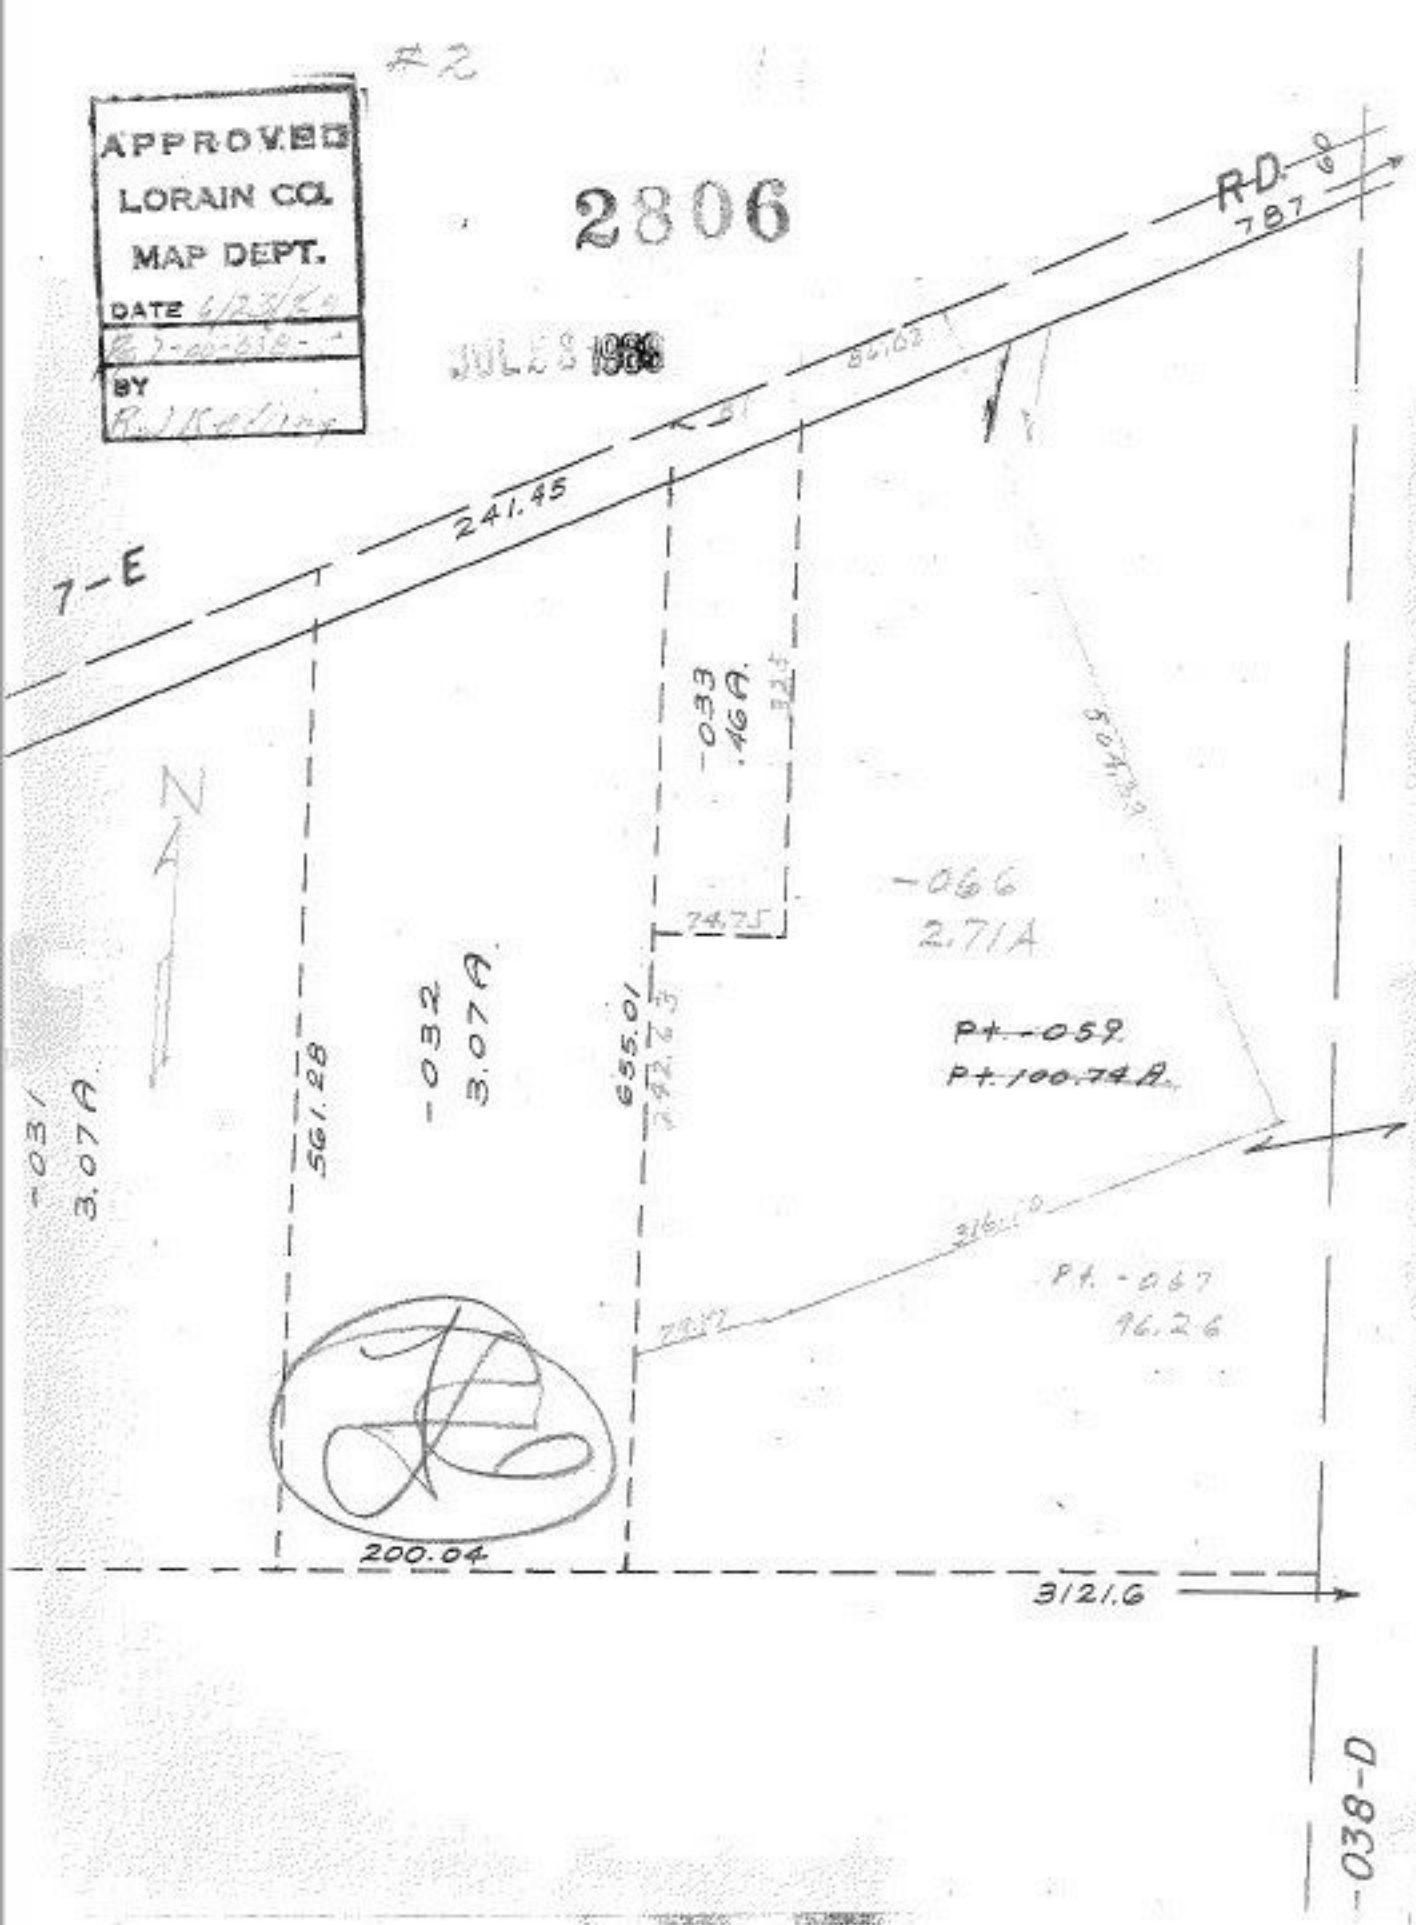
JUL 28 1966