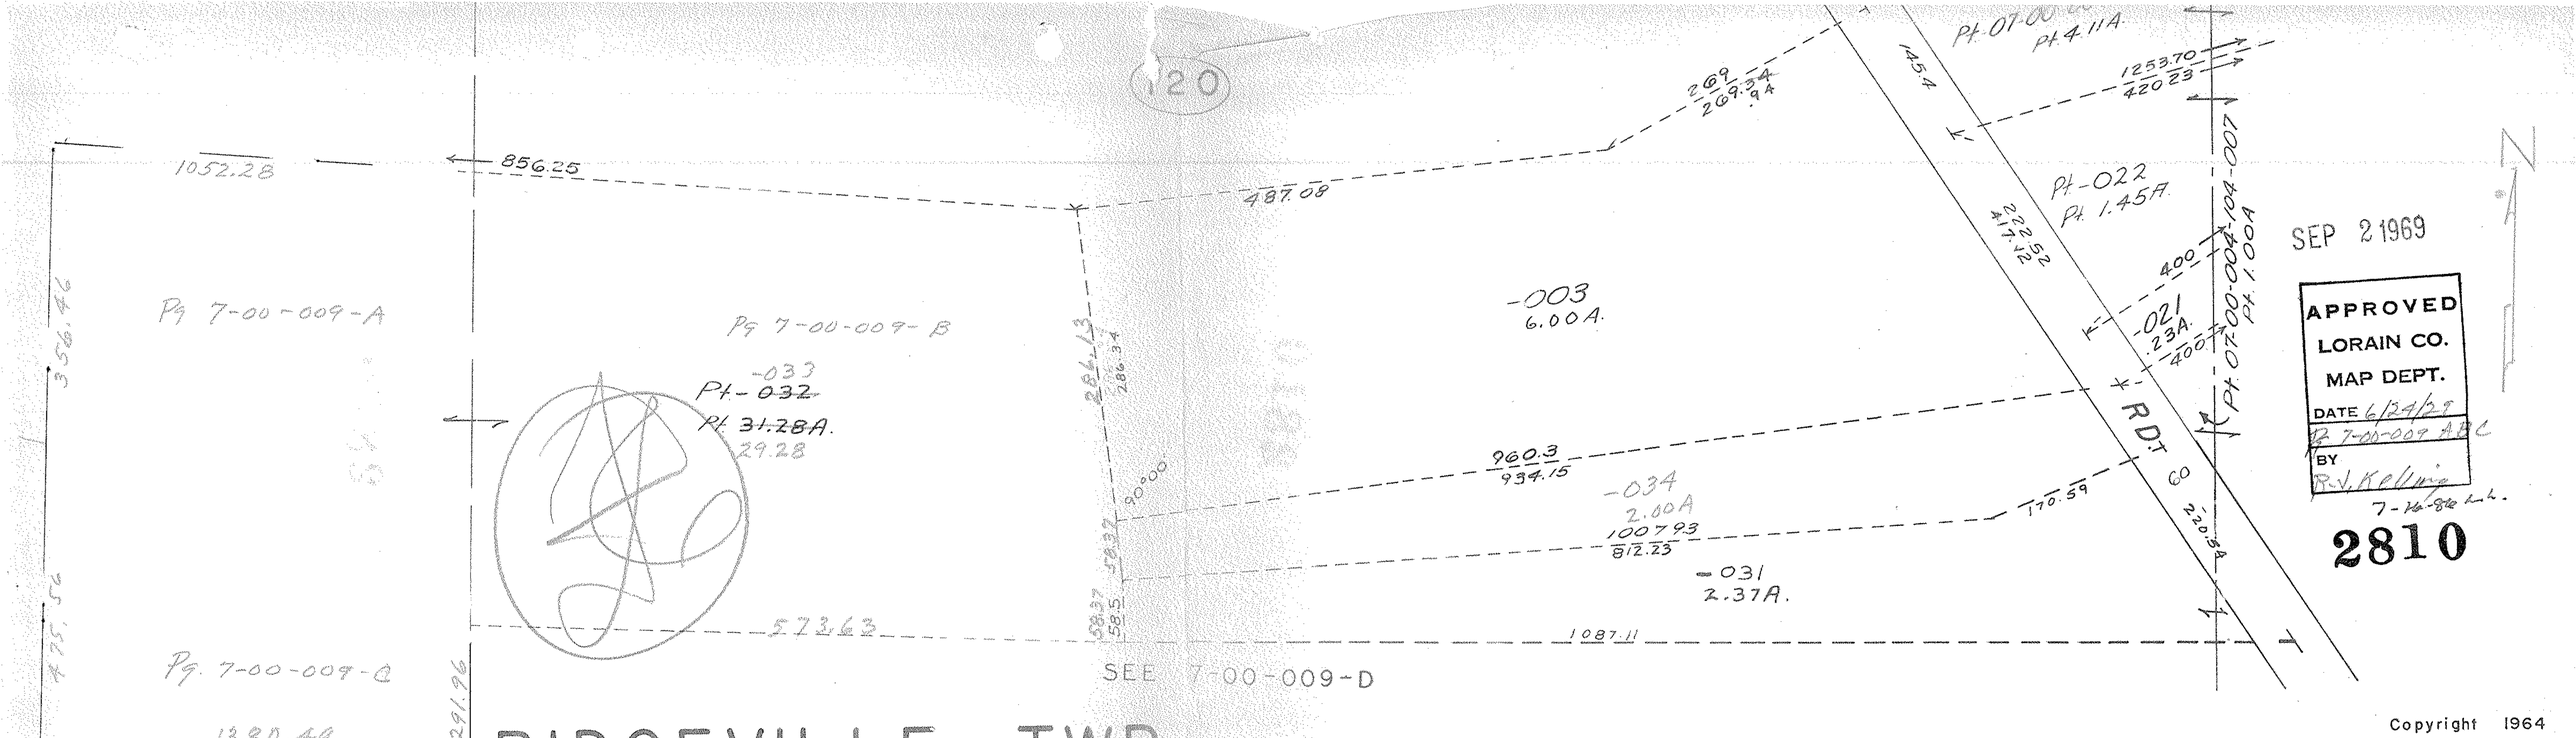

RIDGEVILLE TWP.

SCALE 1" = 100'

NE 1/4 LOT 9

7-00-009-B

Copyright 1964

Revised 6-16-69