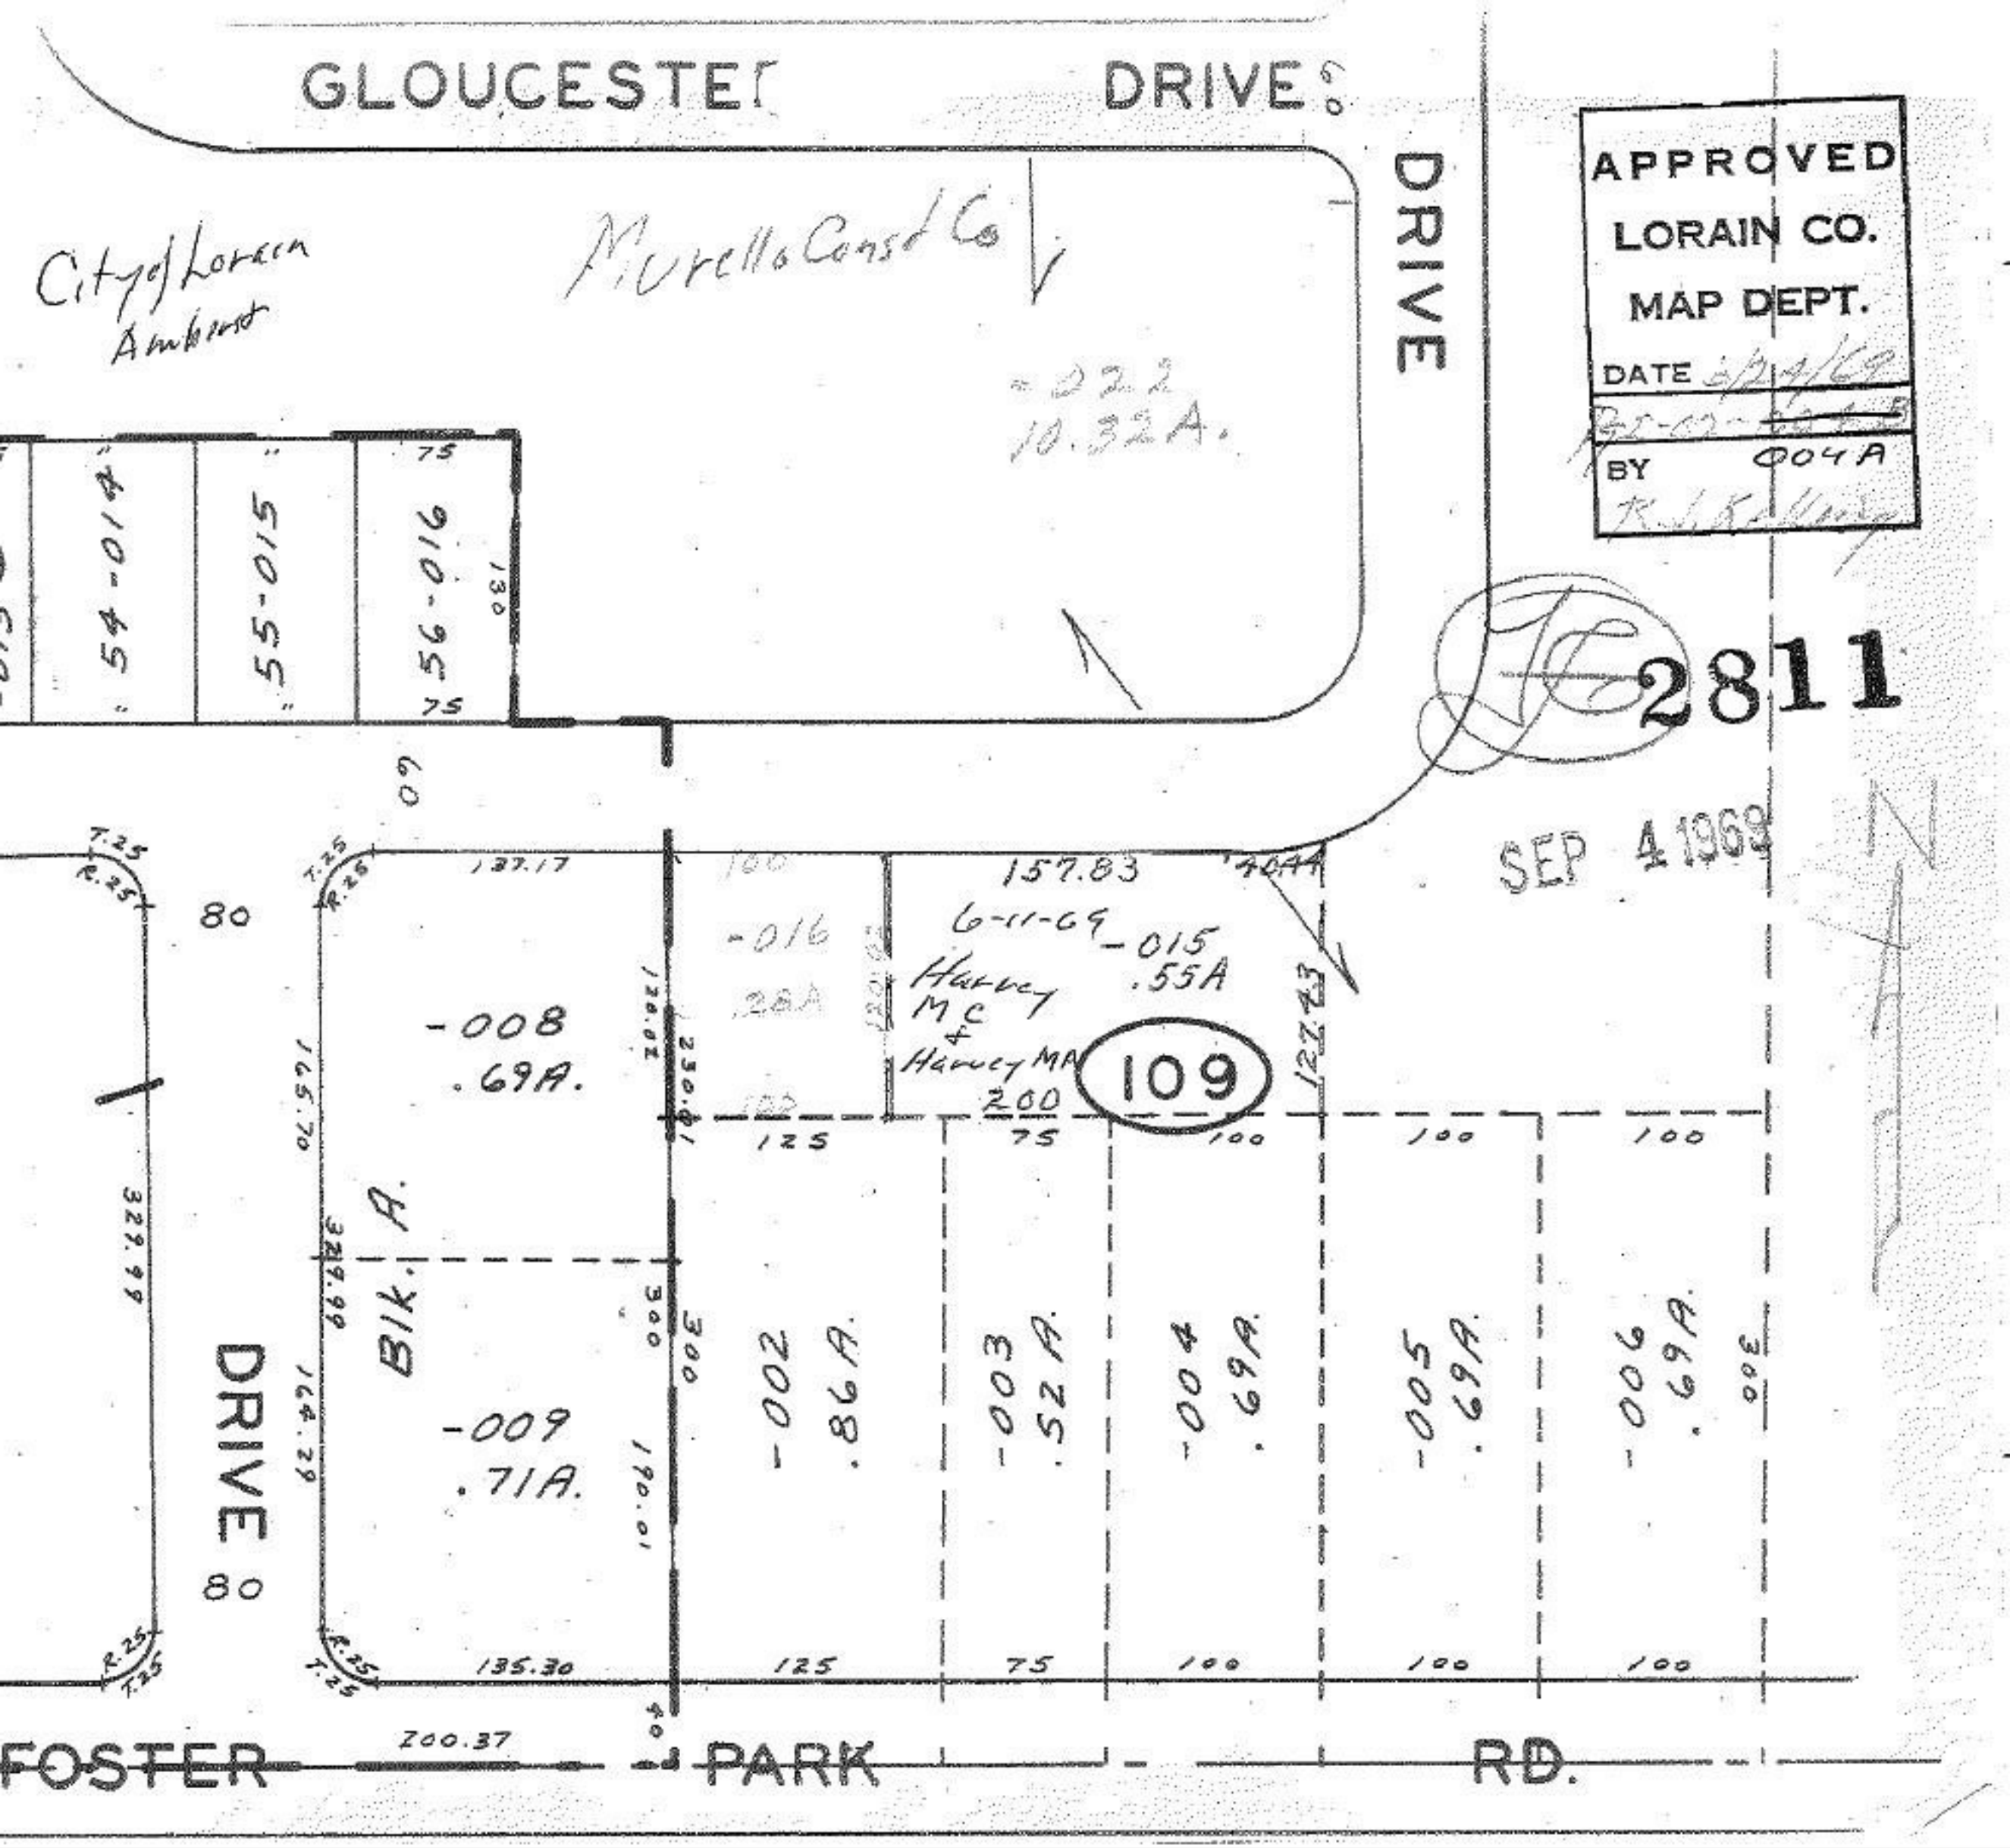
GLOUCESTER DRIVE
DRIVE
APPROVED
LORAIN CO.
MAP DEPT.
DATE 6/24/69
BY 004A
2811
SEP 4 1969
City of Lorain
Amherst
Murello Const Co
-022
10.32A.
54-014
55-015
56-016
75
130
60
80
T.25
R.25
137.17
157.83
6-11-69
-015
.55A
-016
Harvey MC
&
Harvey MA
200
109
127.43
-008
.69A.
165.70
120.02
230.01
125
75
100
100
100
329.99
Blk. A.
300
-002
.86A.
-003
.52A.
-004
.69A.
-005
.69A.
-006
.69A.
-009
.71A.
164.29
190.01
DRIVE
80
135.30
125
75
100
100
100
200.37
FOSTER PARK RD.