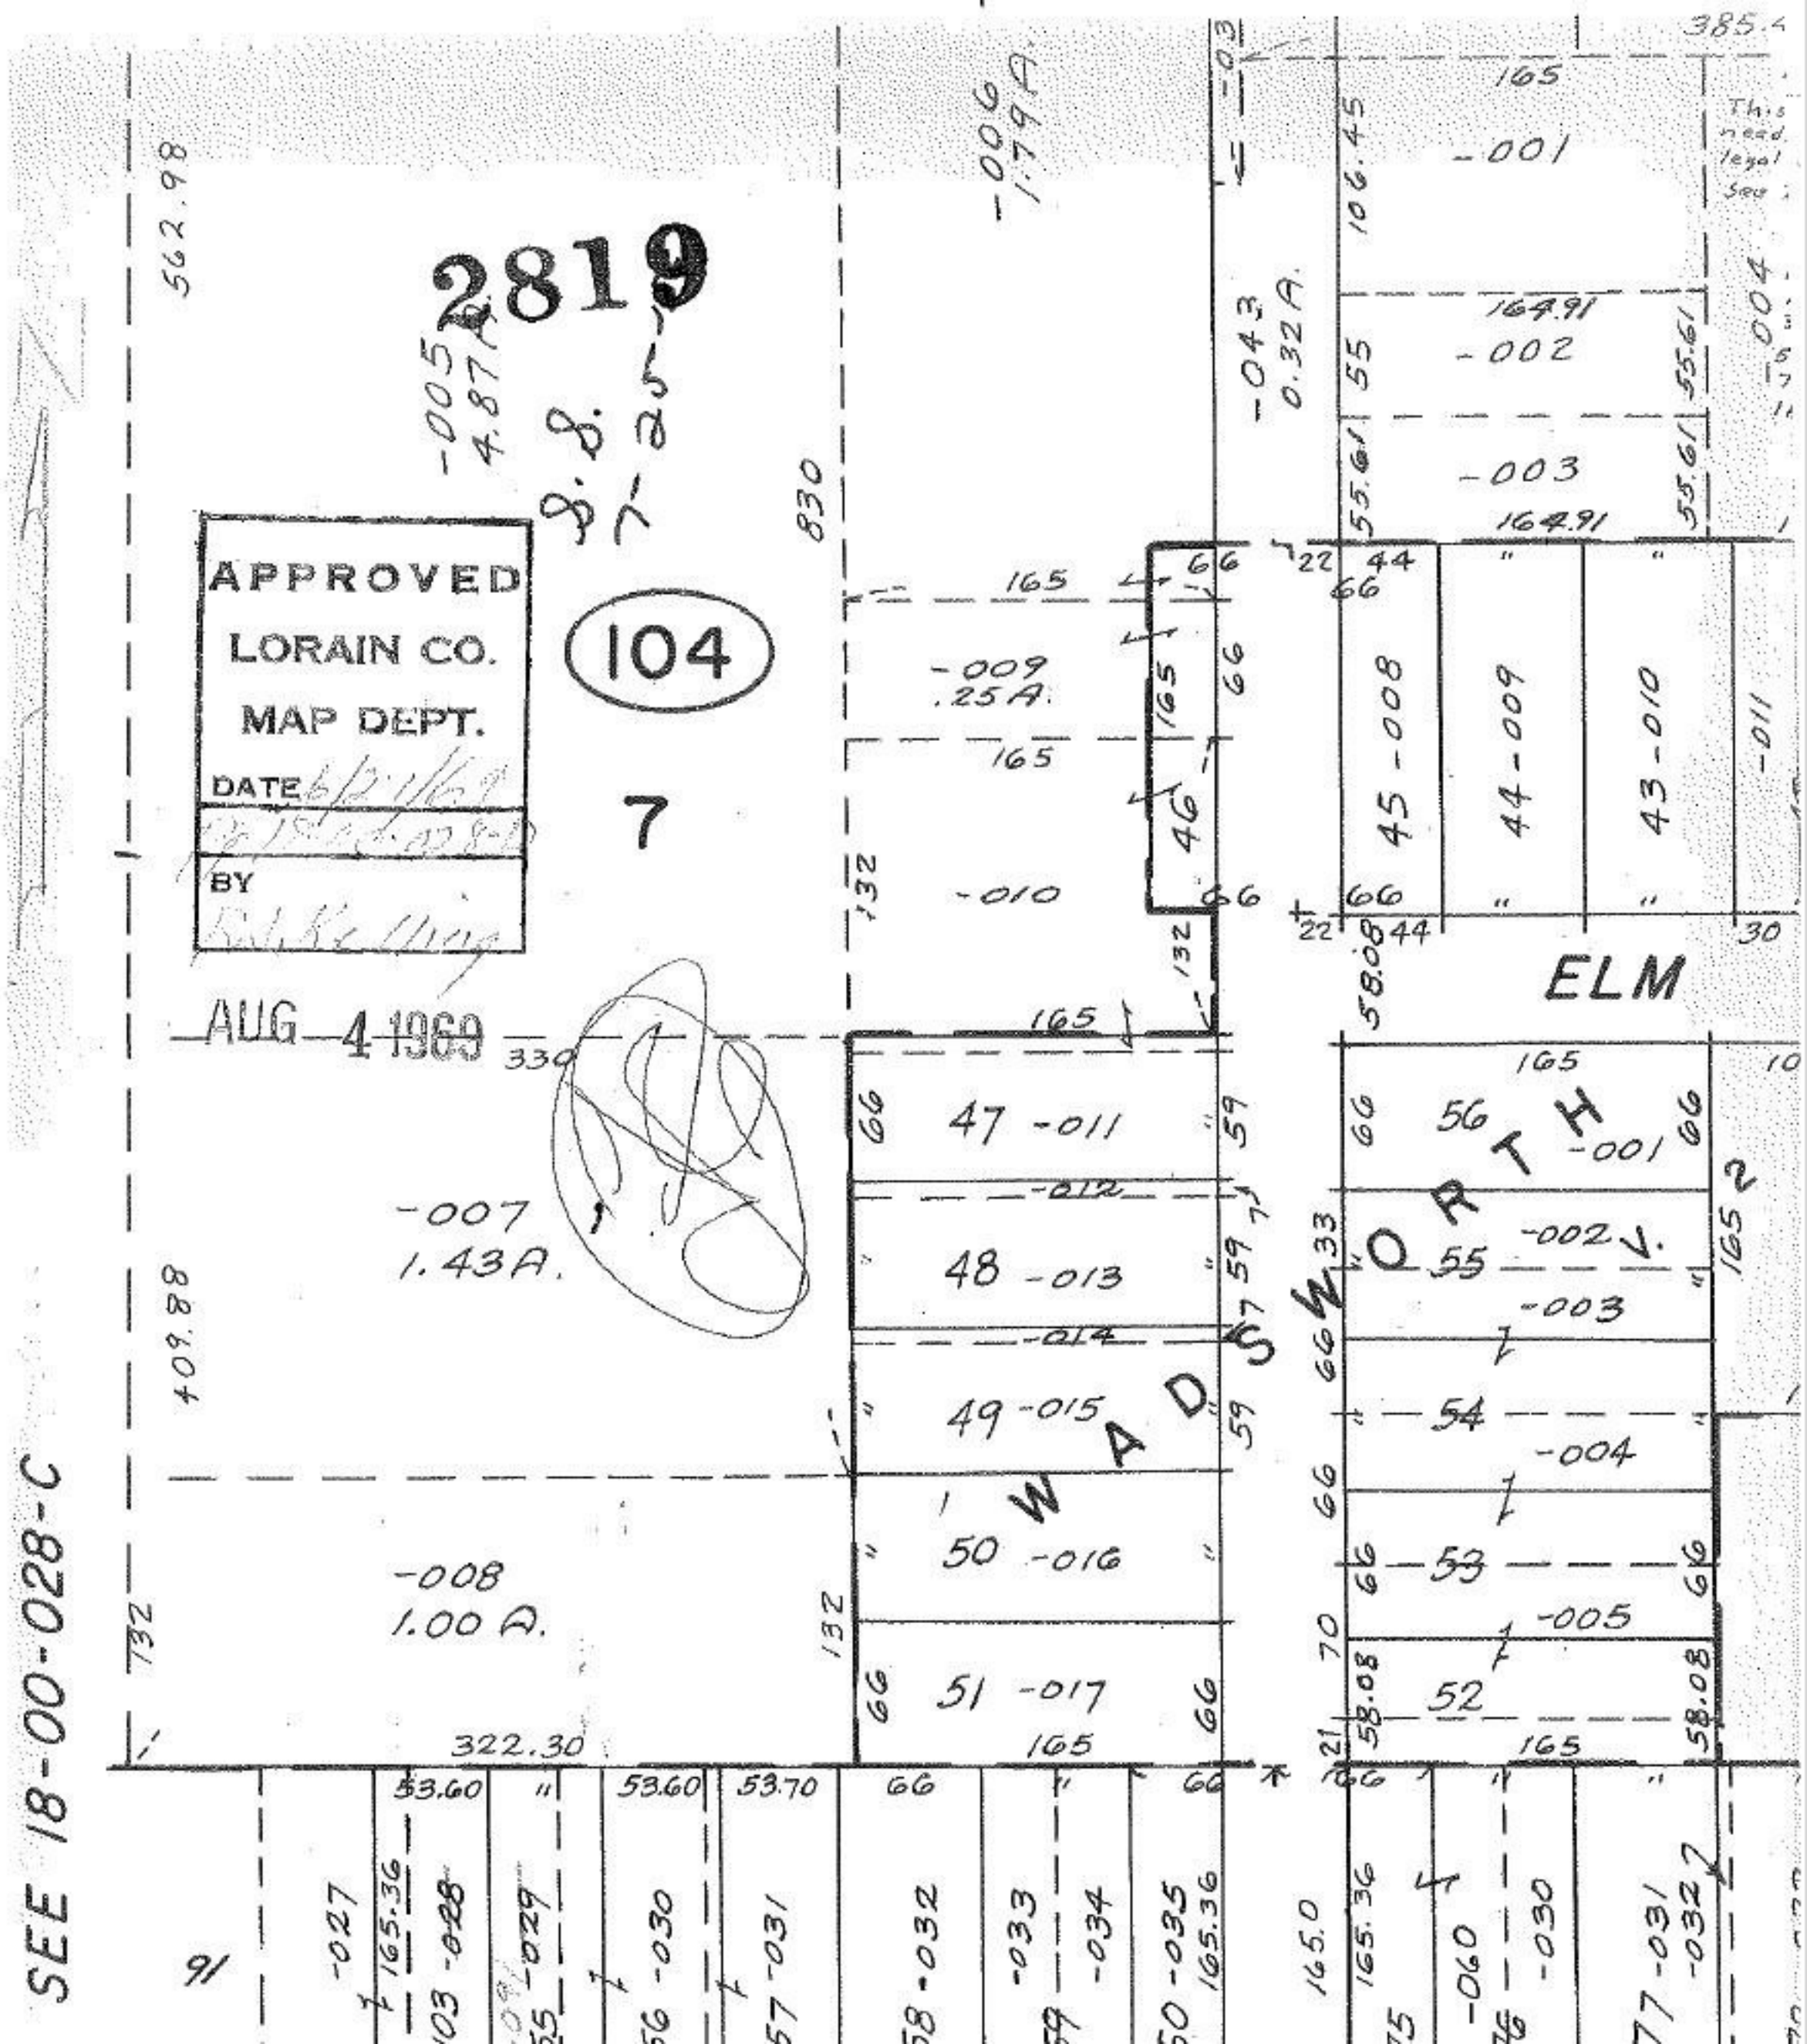

2819
APPROVED
LORAIN CO.
MAP DEPT.
DATE
BY
104
7
AUG 4 1969
ELM
WADSWORTH
SEE 18-00-028-C
-007
1.43A.
-008
1.00 A.
-009
.25A.
-010
-005
4.87A.
-006
1.79A.
-043
0.32A.
-001
-002
-003
-004
-005
-007
-008
-009
-010
-011
-012
-013
-014
-015
-016
-017
-001
-002
-003
-004
-005
-027
-028
-029
-030
-031
-032
-033
-034
-035
-060
-030
-031
-032