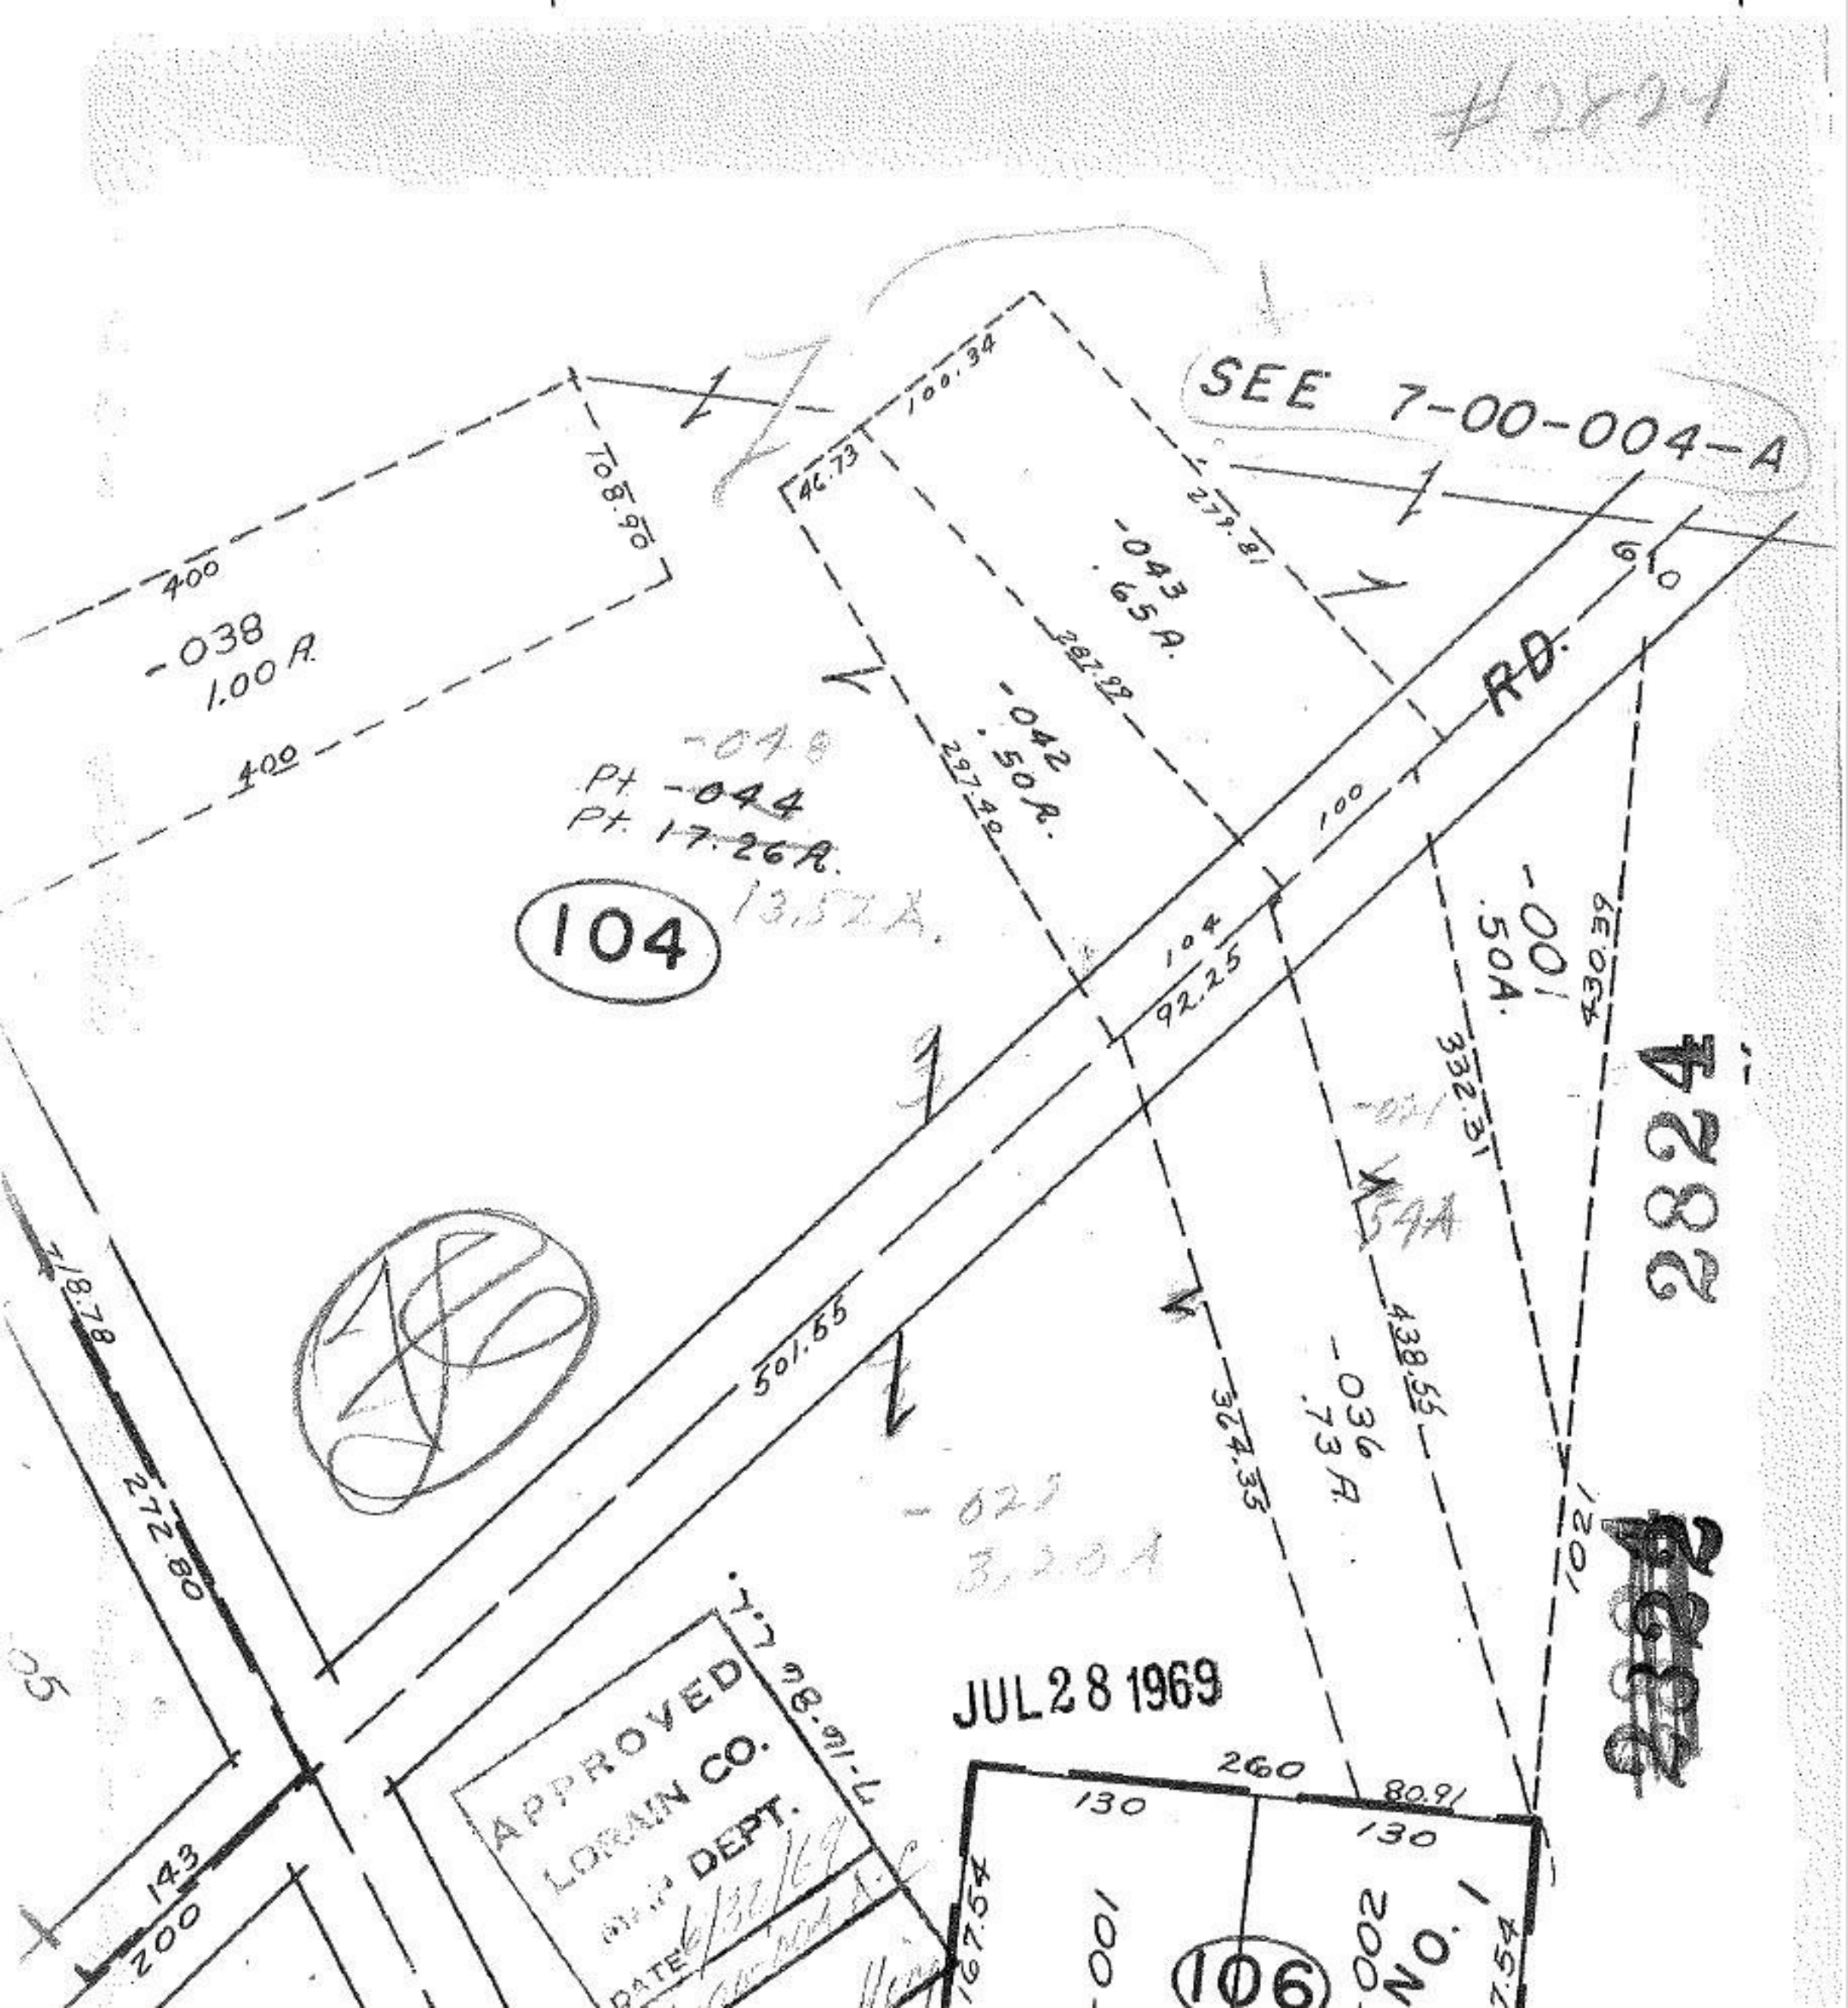

#2824
SEE 7-00-004-A
-038
1.00 A.
400
400
108.90
100.34
46.73
279.81
-043
.65 A.
287.99
-042
.50 A.
297.40
-048
Pt. -044
Pt. 17.26 A.
13.52 A.
104
RD.
100
104
92.25
-001
.50 A.
430.39
332.31
-021
54A
438.55
-036
.73 A.
364.35
501.55
718.78
272.80
-022
3.20 A
1021
2824
JUL 28 1969
APPROVED
LORAIN CO.
DEPT.
DATE
7-16-86 L.L.
260
130
80.91
130
167.54
-001
-002
NO. 1
106
143
200