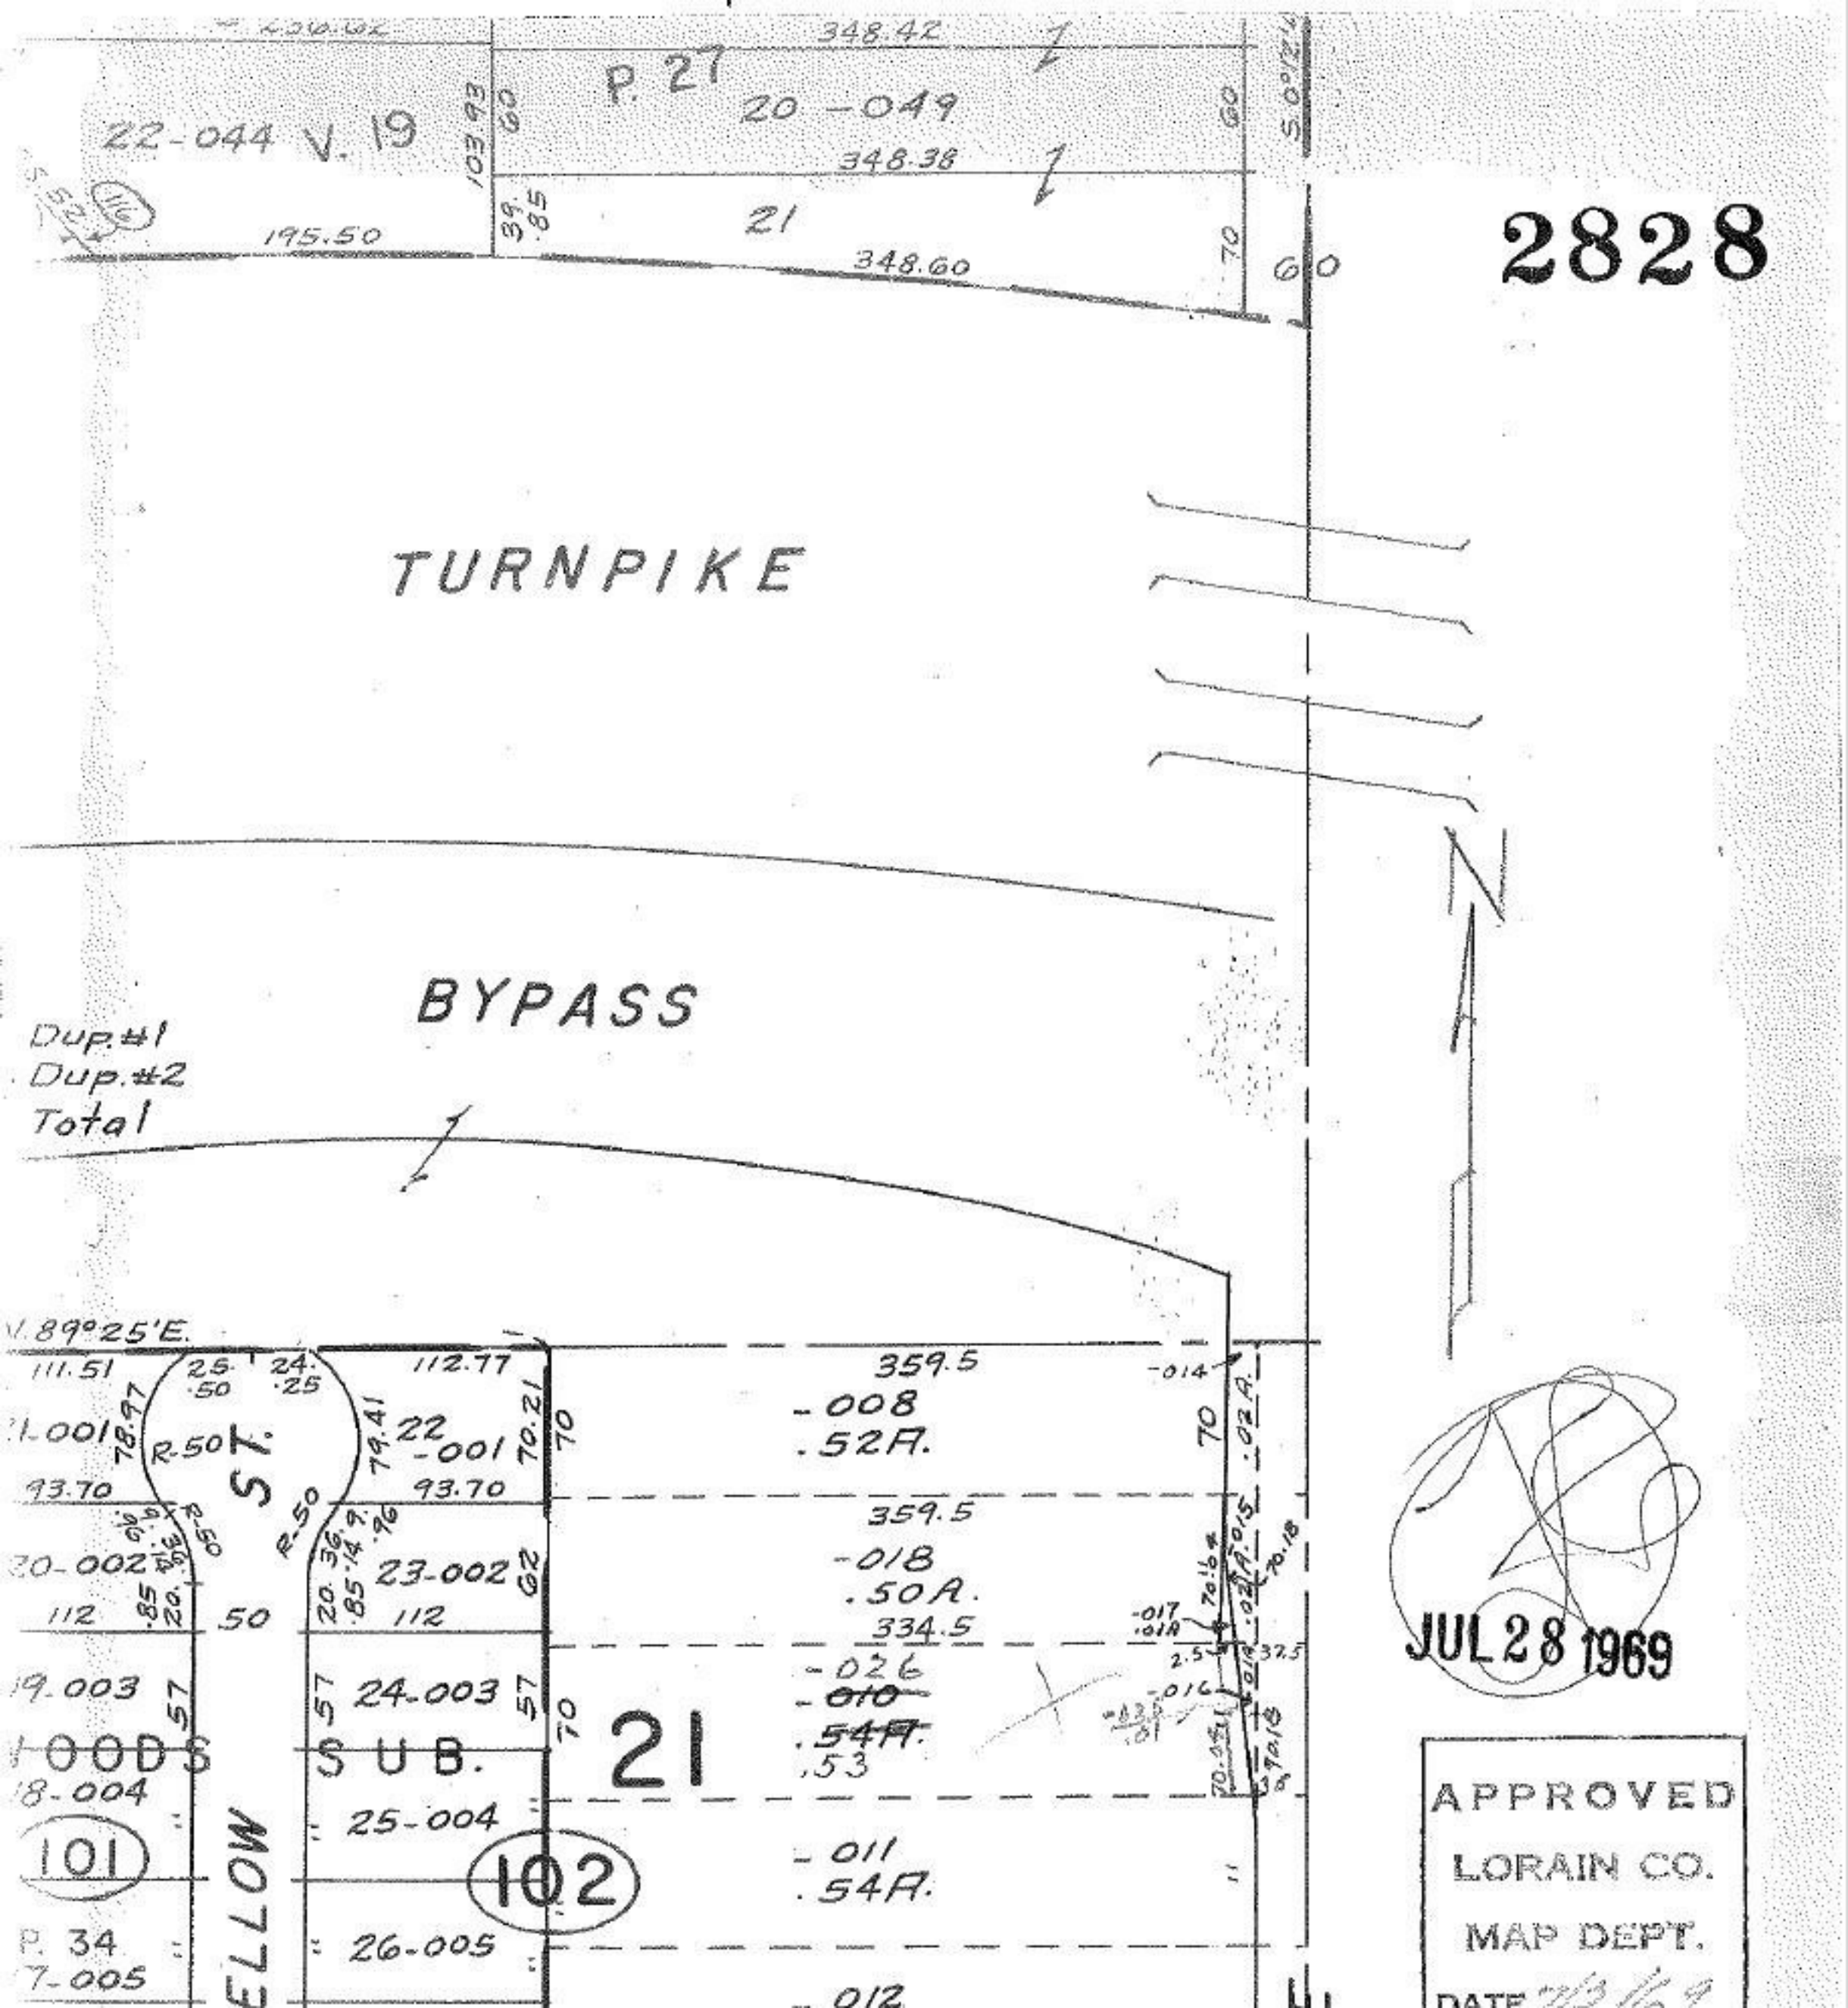

2828
348.42
P. 27
20-049
22-044 V. 19
103.93
60
348.38
21
195.50
39.85
348.60
70
60
TURNPIKE
BYPASS
Dup.#1
Dup.#2
Total
N
N.89°25'E.
111.51
25.50
24.25
112.77
21-001
78.97
R-50
ST.
79.41
22-001
70.21
70
93.70
93.70
359.5
-008
.52A.
-014
70
.02A.
359.5
-018
.50A.
20-002
23-002
62
112
50
112
334.5
-017
.01A
-026
-010
.54A.
.53
19-003
24-003
57
57
57
70
21
WOODS SUB.
18-004
25-004
101
102
-011
.54A.
P. 34
26-005
7-005
-012
JUL 28 1969
APPROVED
LORAIN CO.
MAP DEPT.
DATE