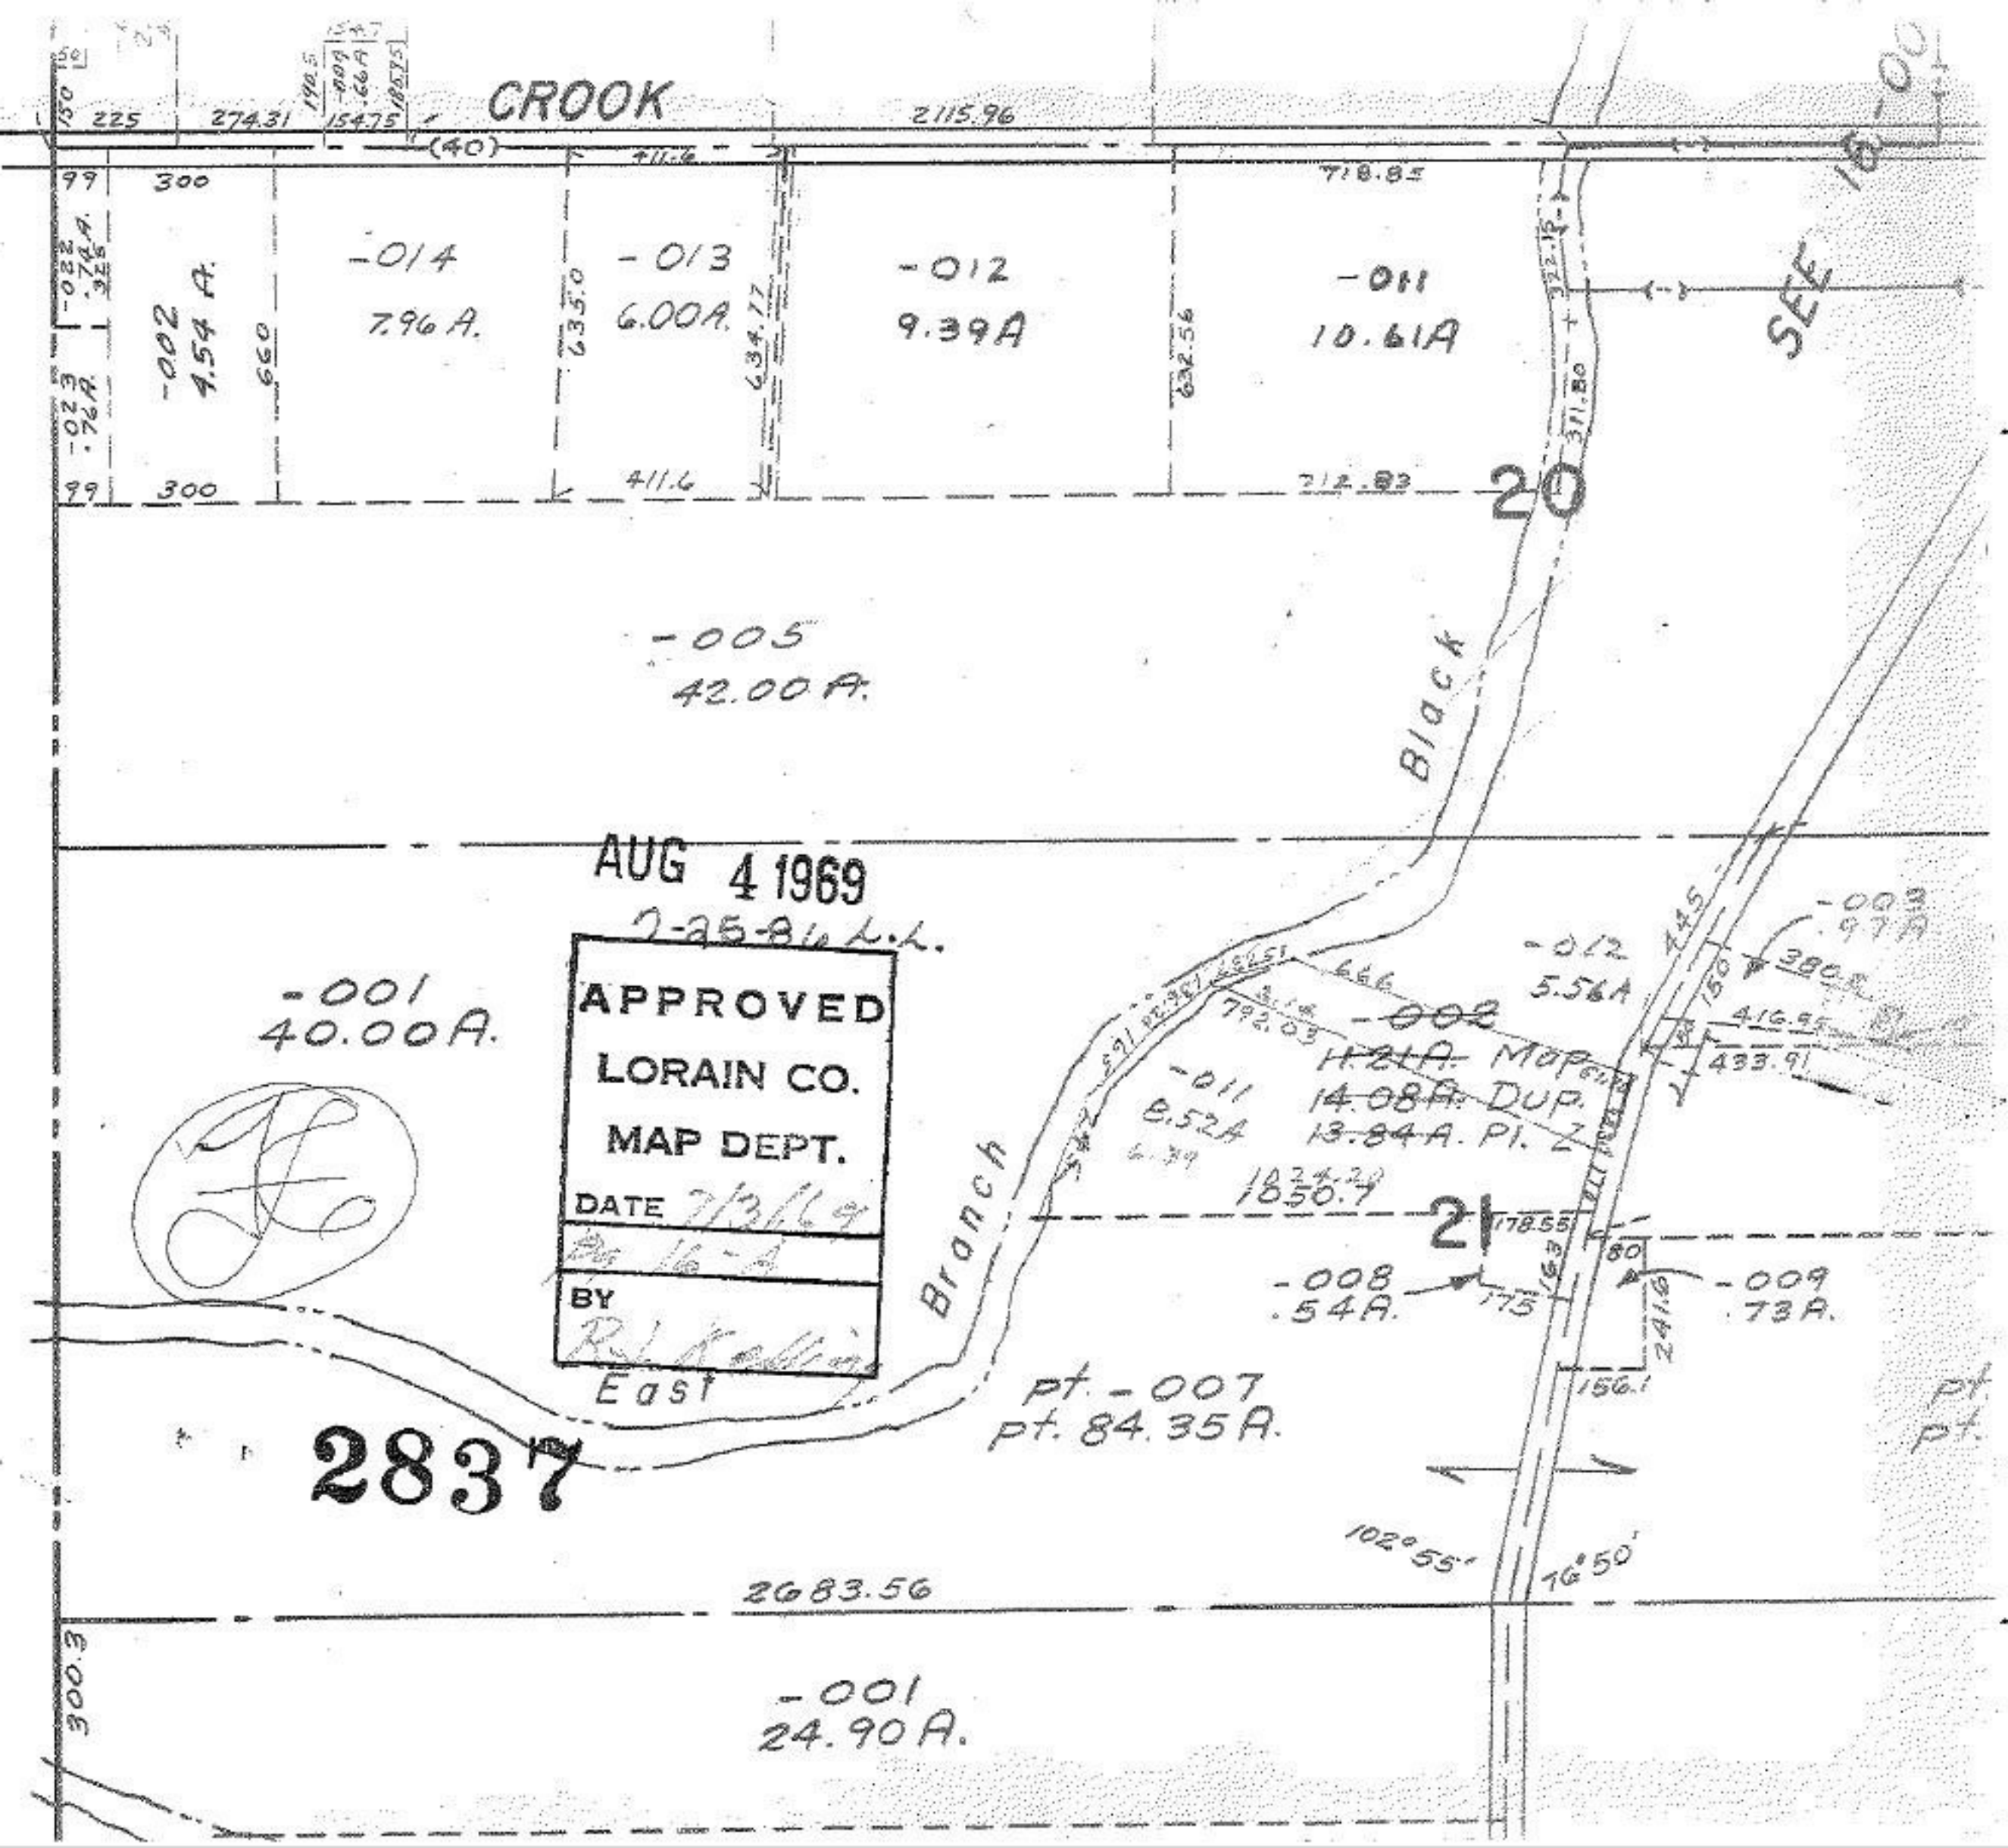
CROOK
(40)
2115.96
225
274.31
154.75
99
300
-014
7.96 A.
-013
6.00A.
-012
9.39A
-011
10.61A
-002
4.54 A.
660
635.0
634.77
632.56
718.85
411.6
212.83
20
SEE 16-00
-005
42.00 A.
Black
AUG 4 1969
2-25-86 L.L.
APPROVED
LORAIN CO.
MAP DEPT.
DATE 7/3/69
BY
-001
40.00A.
-012
5.56A
-003
.97A
380.8
416.95
433.91
-002
11.21A. Map
14.08A. Dup.
13.84A. Pl. Z
-011
8.52A
1050.7
21
178.55
-008
.54A.
-009
.73A.
175
241.6
156.1
Branch
East
pt. -007
pt. 84.35A.
2837
102°55'
76°50'
2683.56
300.3
-001
24.90A.