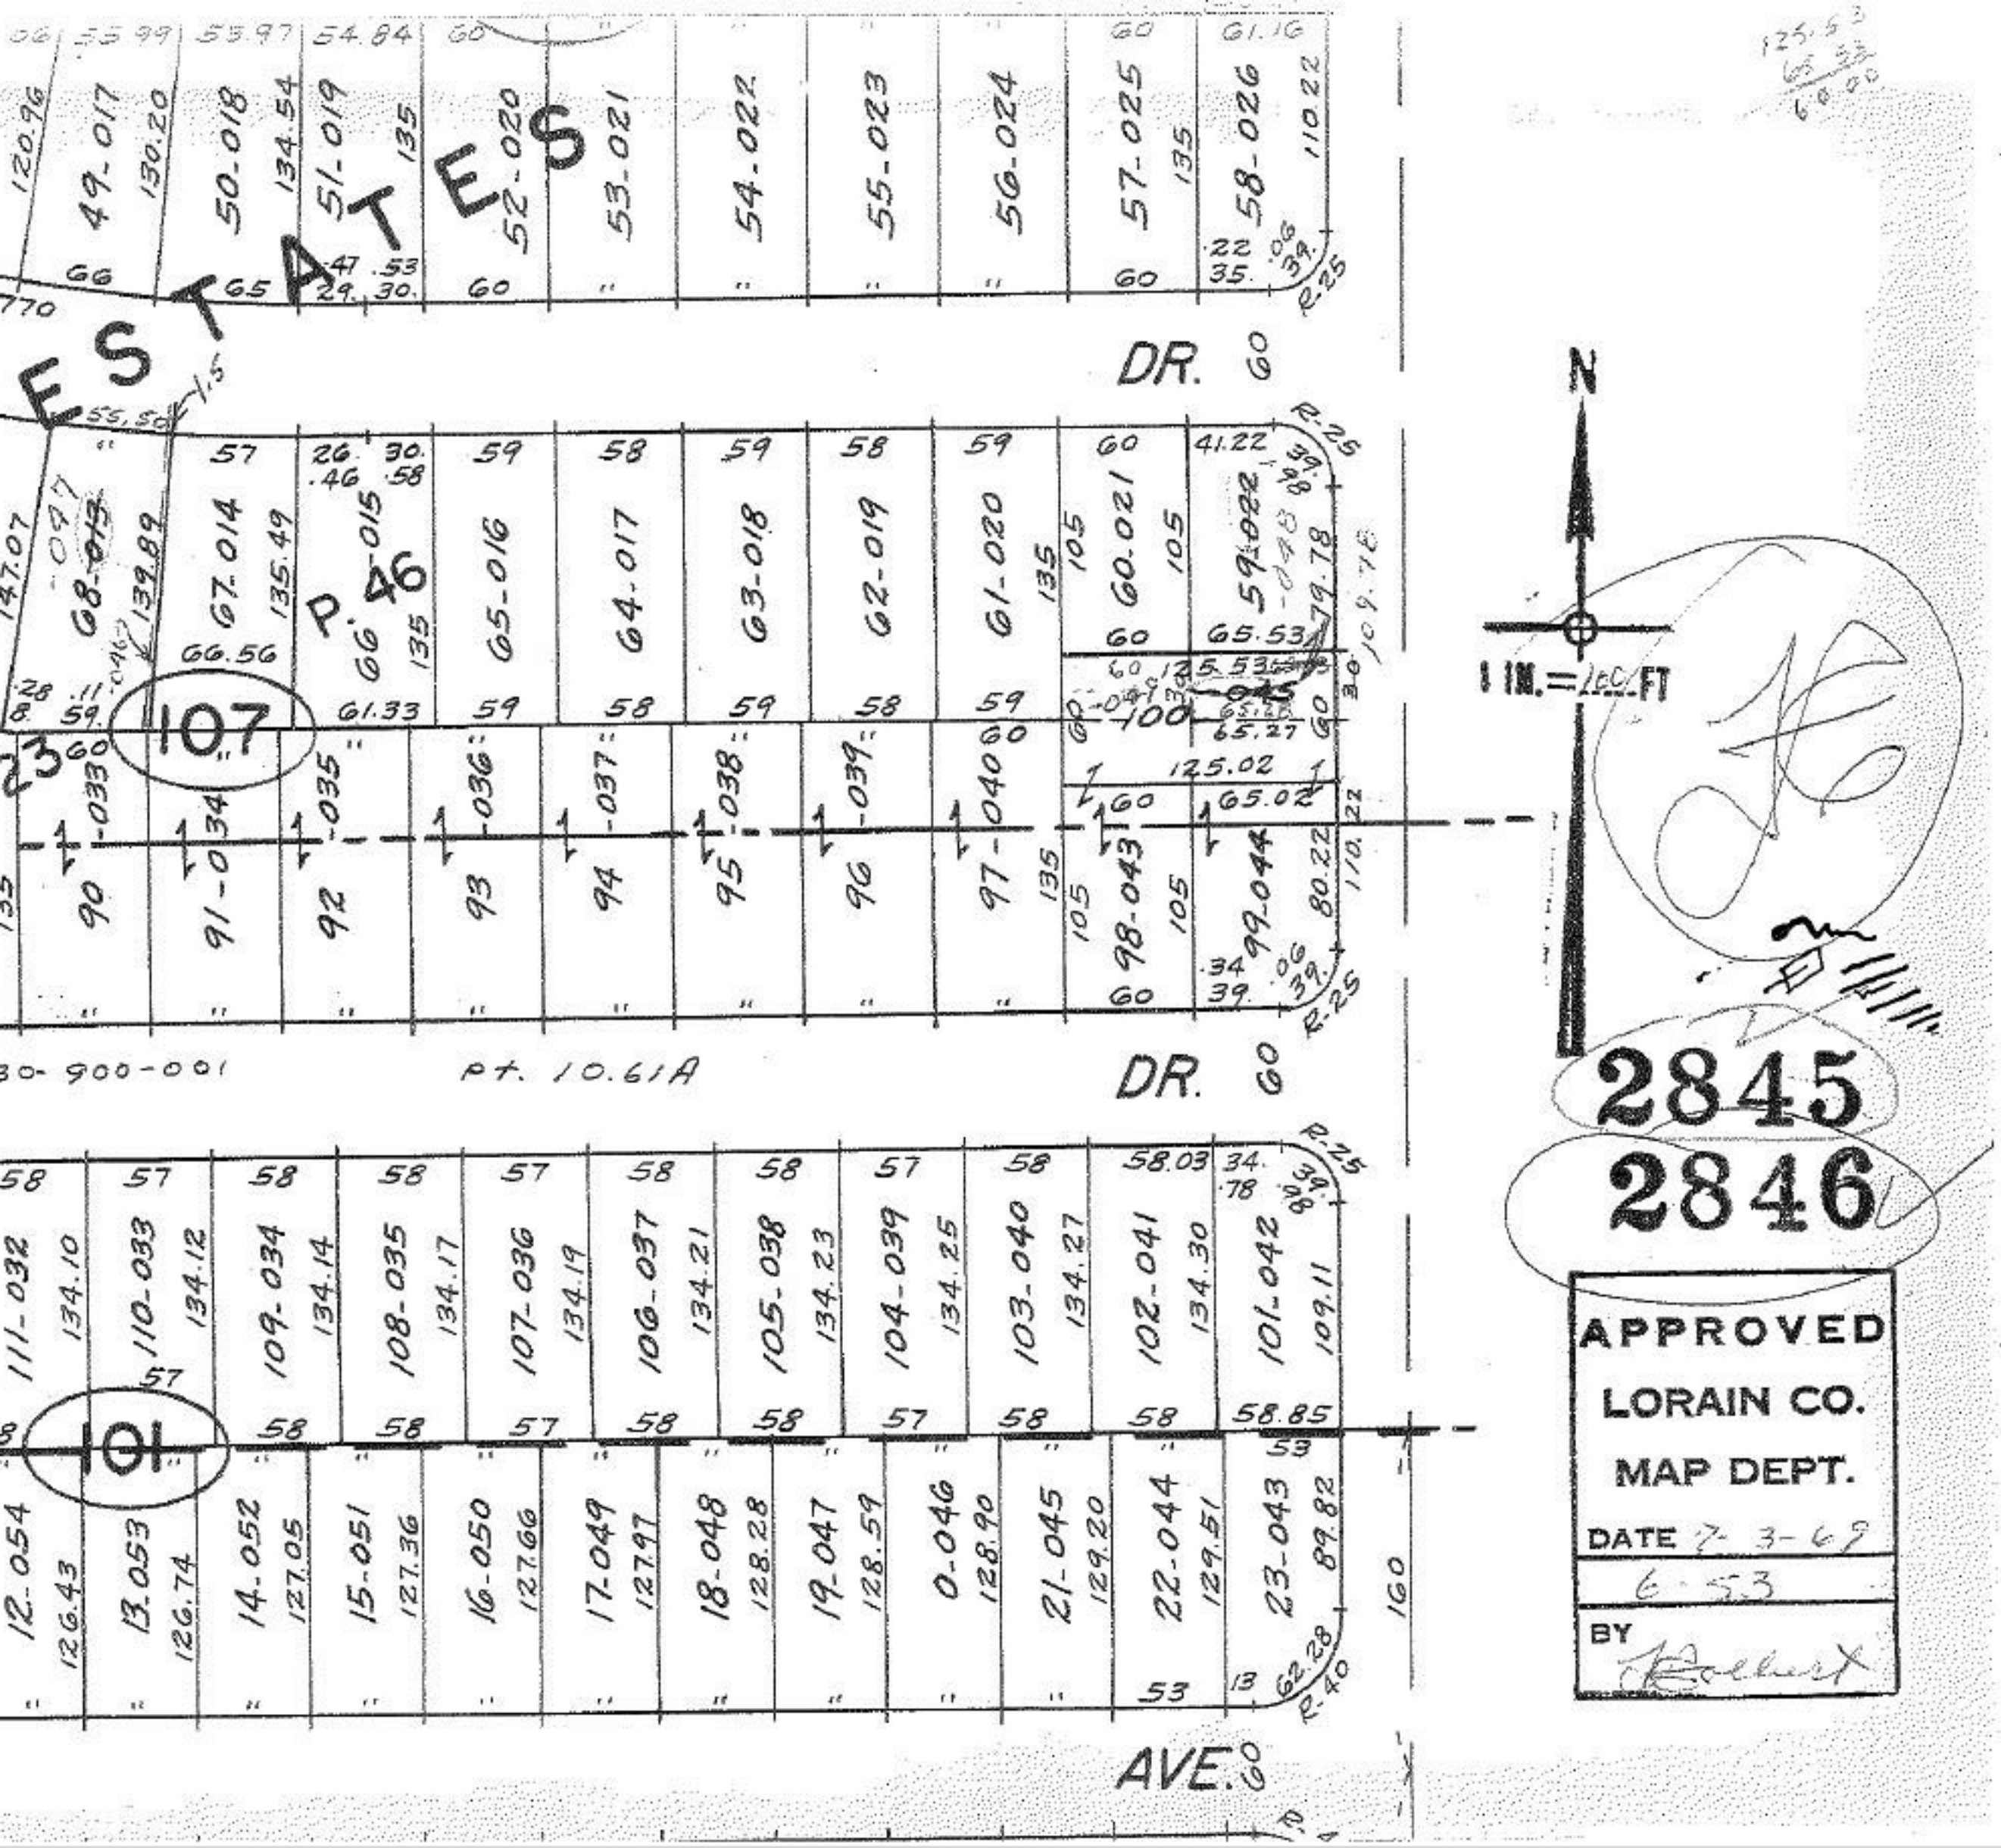
ESTATES
DR.
DR.
AVE.
P. 46
107
101
30-900-001
pt. 10.61A
N
1 IN. = 100 FT
2845
2846
APPROVED
LORAIN CO.
MAP DEPT.
DATE 7-3-69
6-53
BY