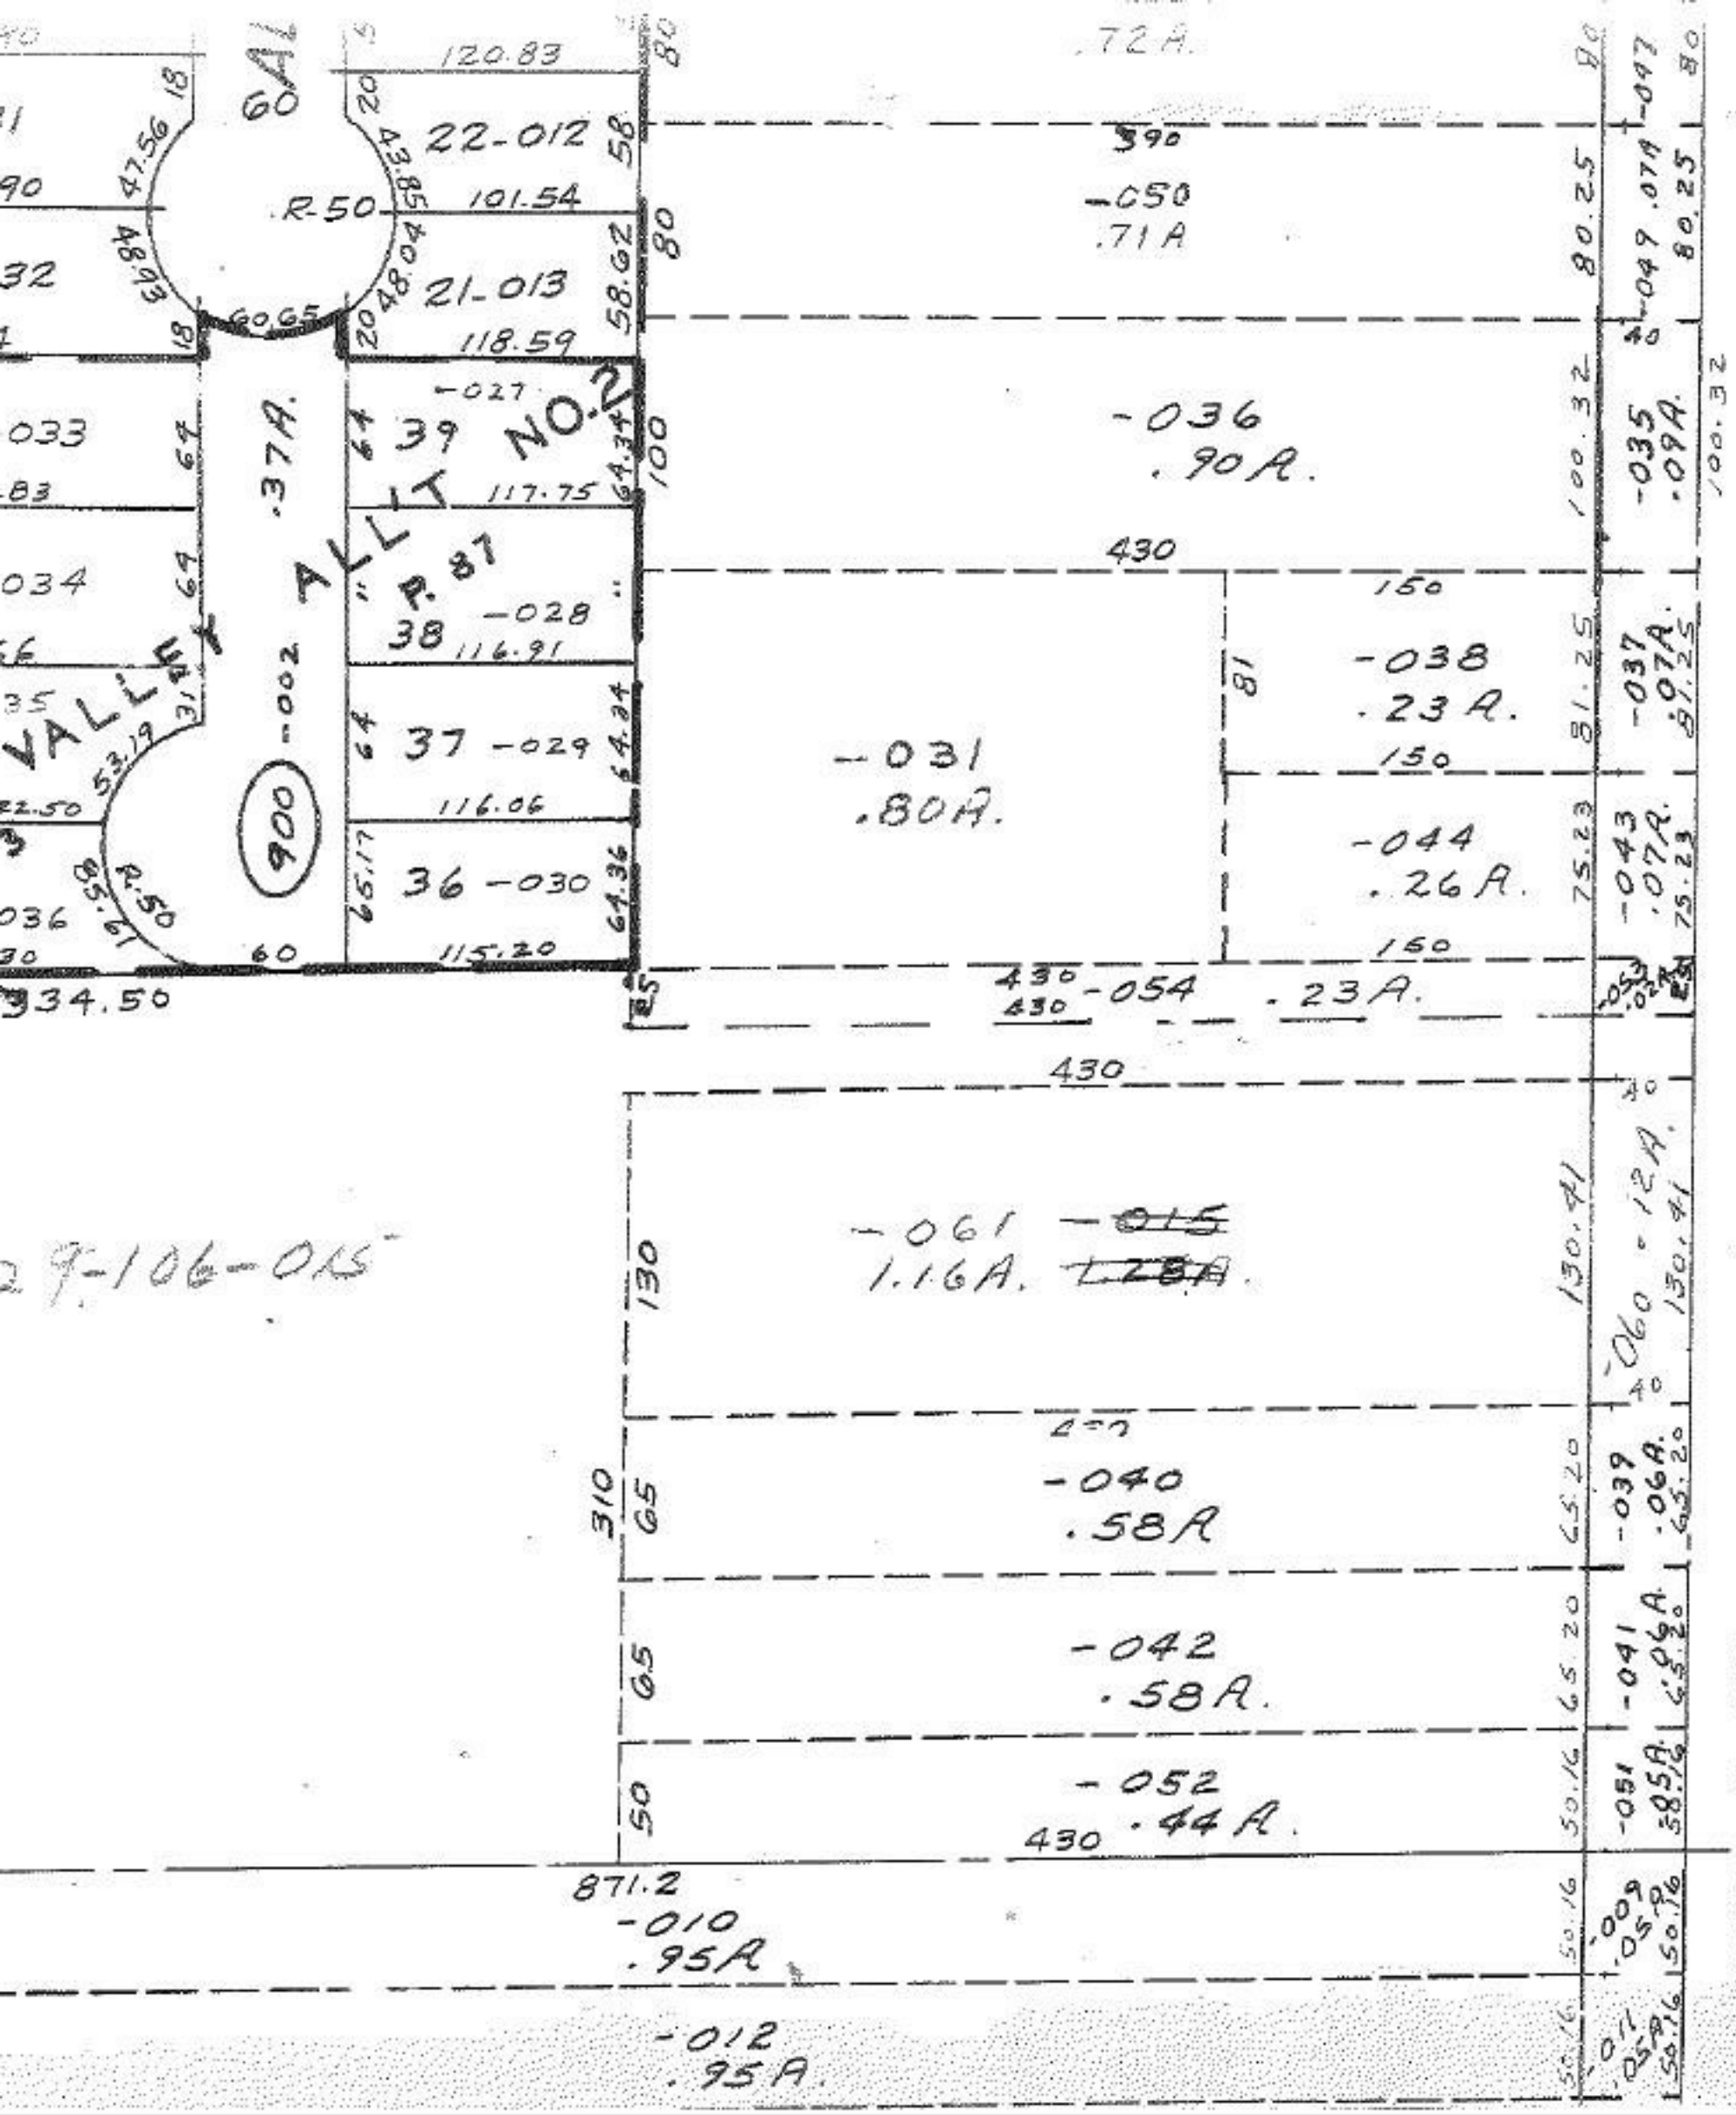

SEE 6-53

N

IN. = 100 FT

SEP 4 1969

2855

APPROVED
LORAIN CO.
MAP DEPT.
DATE 7-10-69
6-52
BY F. Colbert

128
12
116