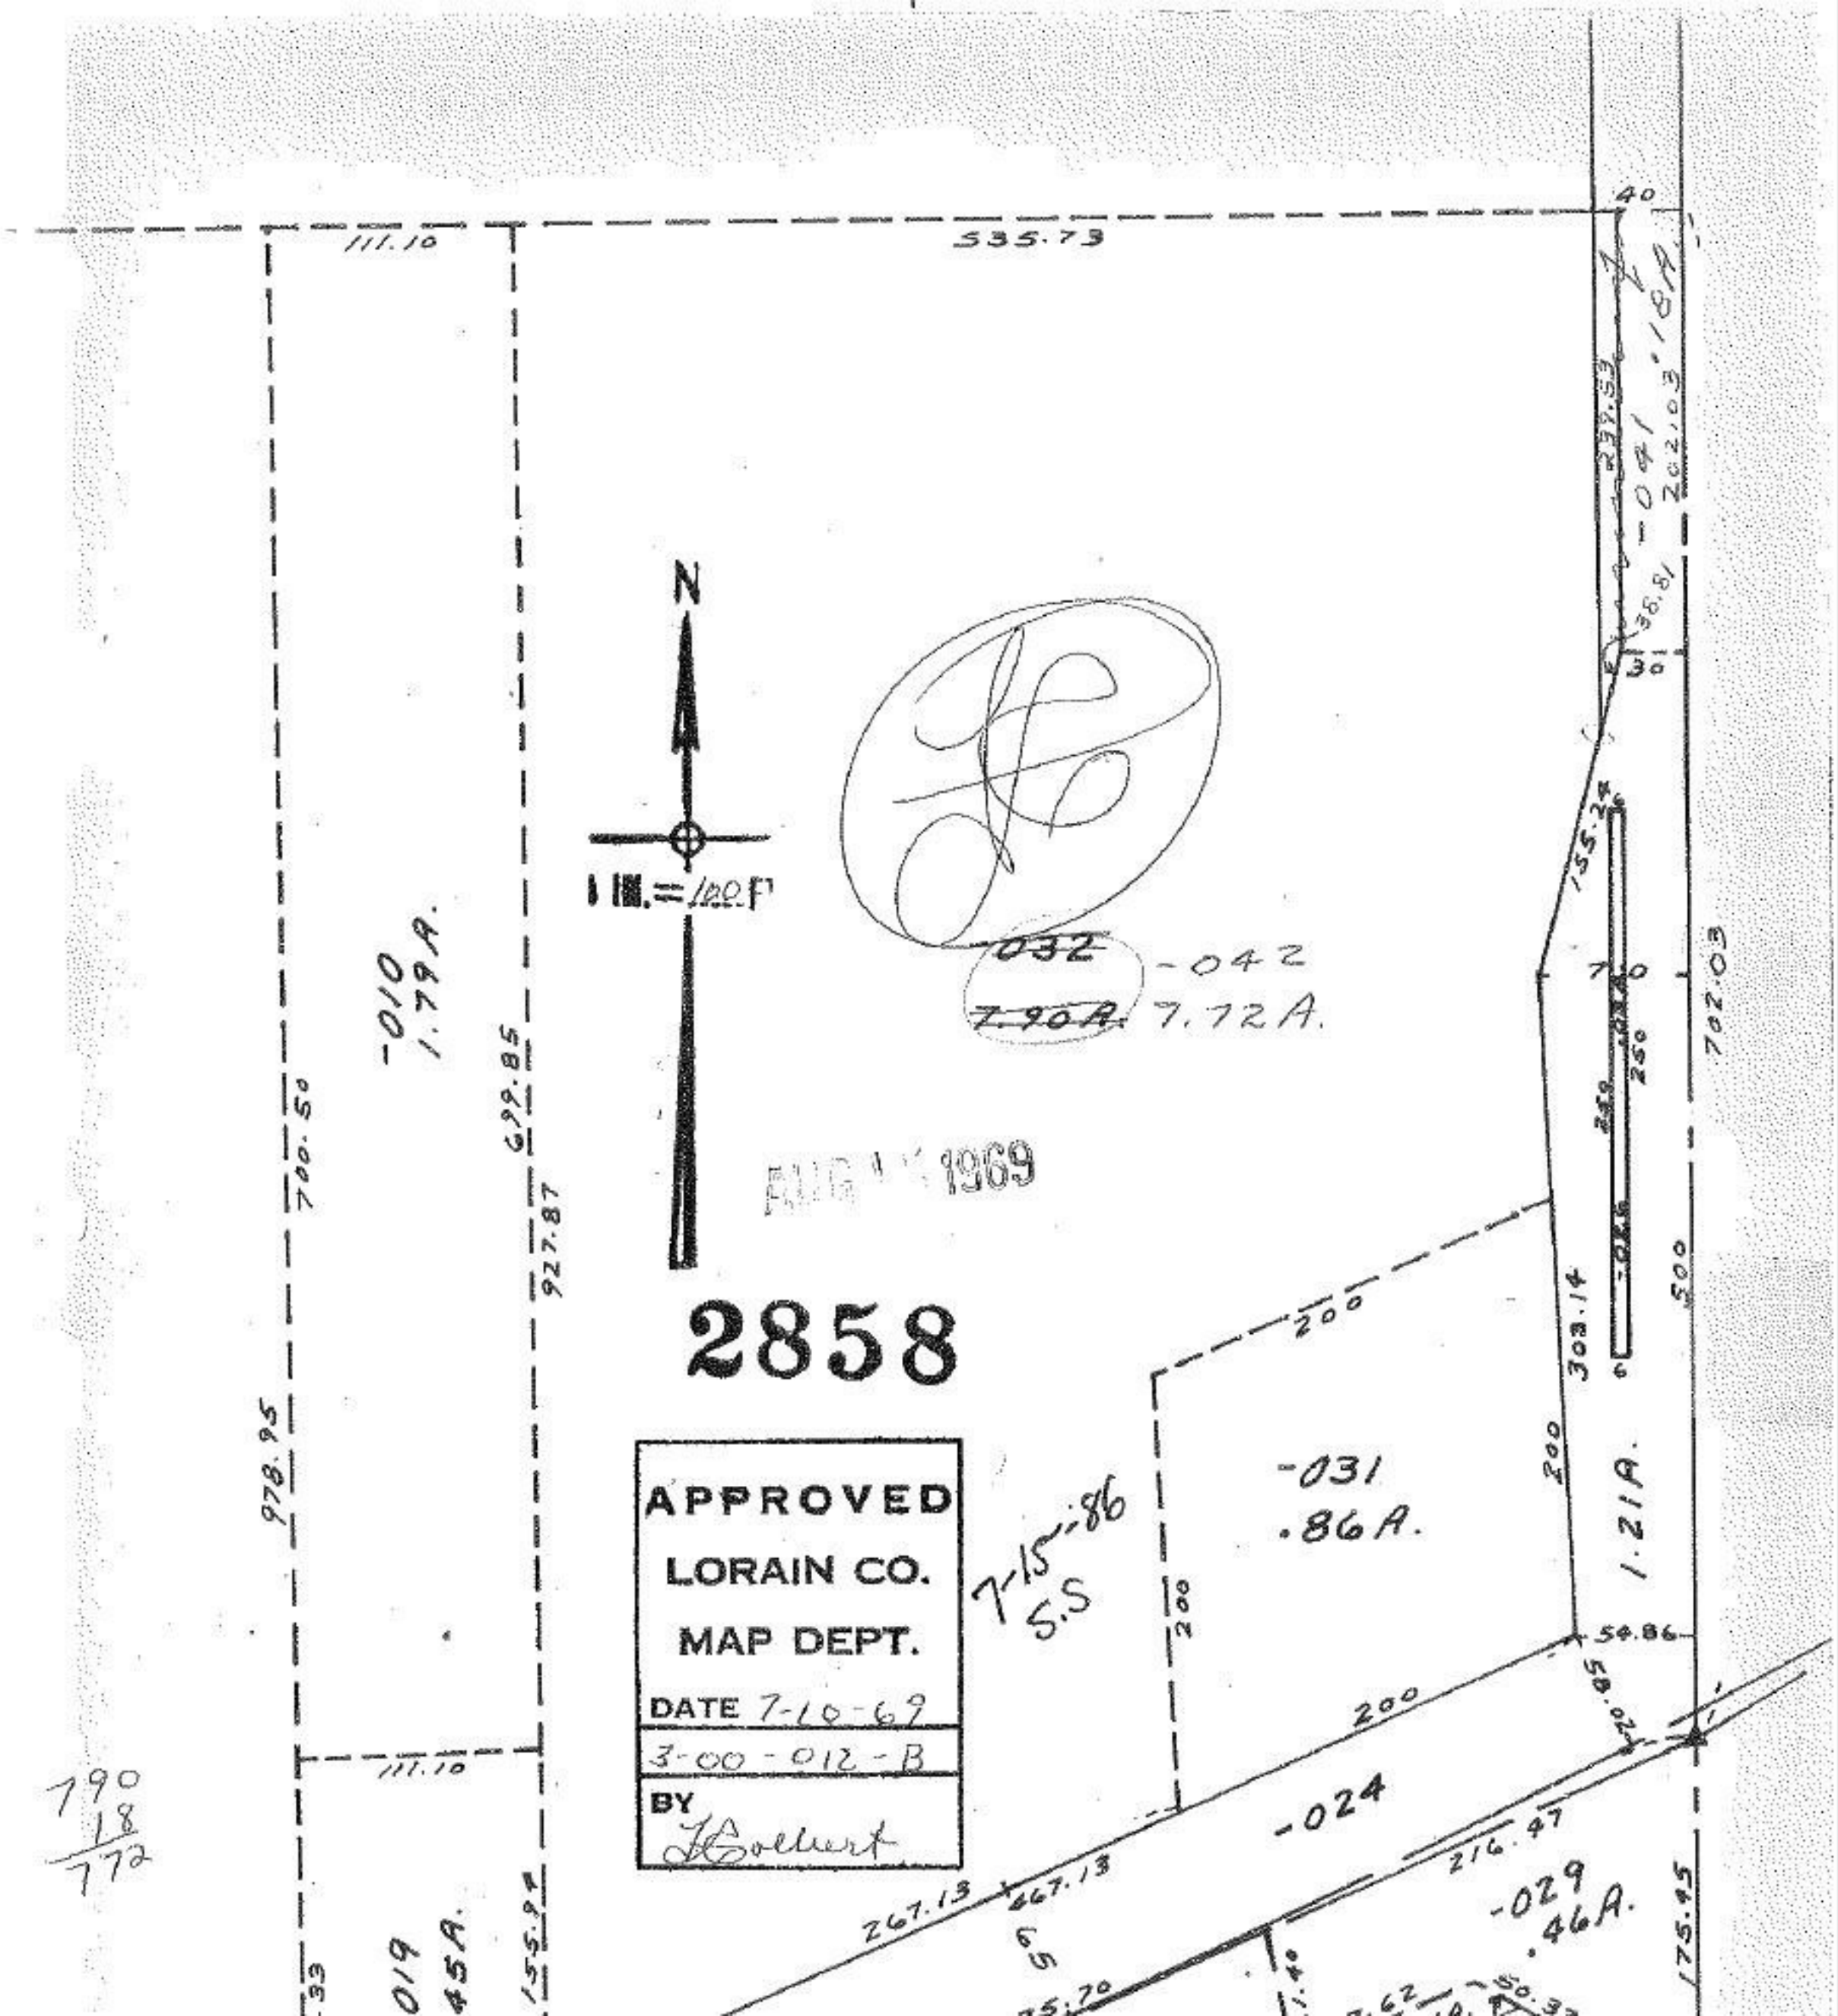

APPROVED
LORAIN CO.
MAP DEPT.
DATE 7-10-69
3-00-012-B
BY