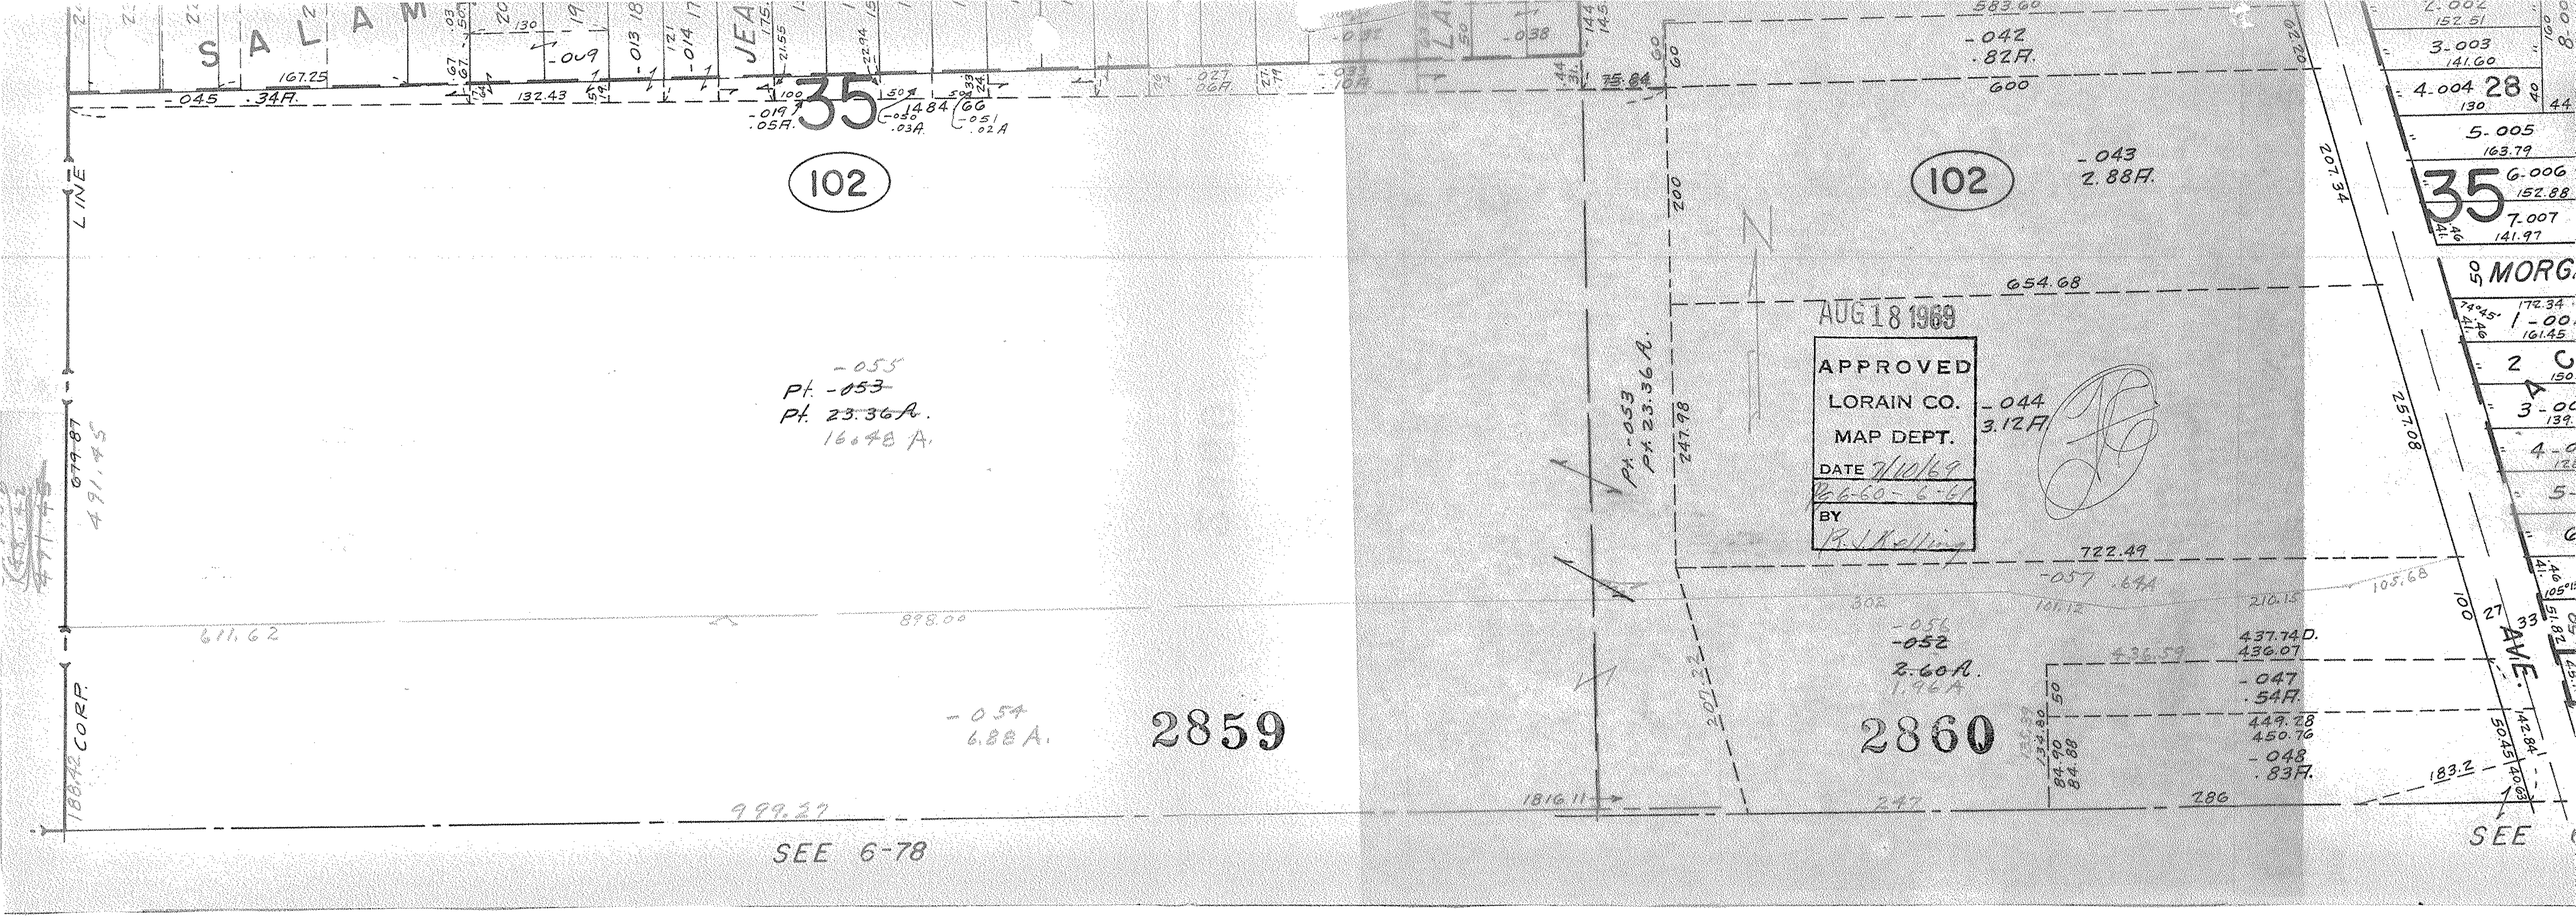

SALAM
JEA
35
102
LINE
CORP.
-055
Pt. -053
Pt. 23.36 A.
16.48 A.
-054
6.88 A.
2859
2860
-056
-052
2.60 A.
1.96 A.
-057 .64 A
-042
.82 A.
-043
2.88 A.
-044
3.12 A.
-047
.54 A.
-048
.83 A.
Pt. -053
Pt. 23.36 A.
AUG 18 1969
APPROVED
LORAIN CO.
MAP DEPT.
DATE 7/10/69
BY
SEE 6-78
SEE
MORG
AVE.