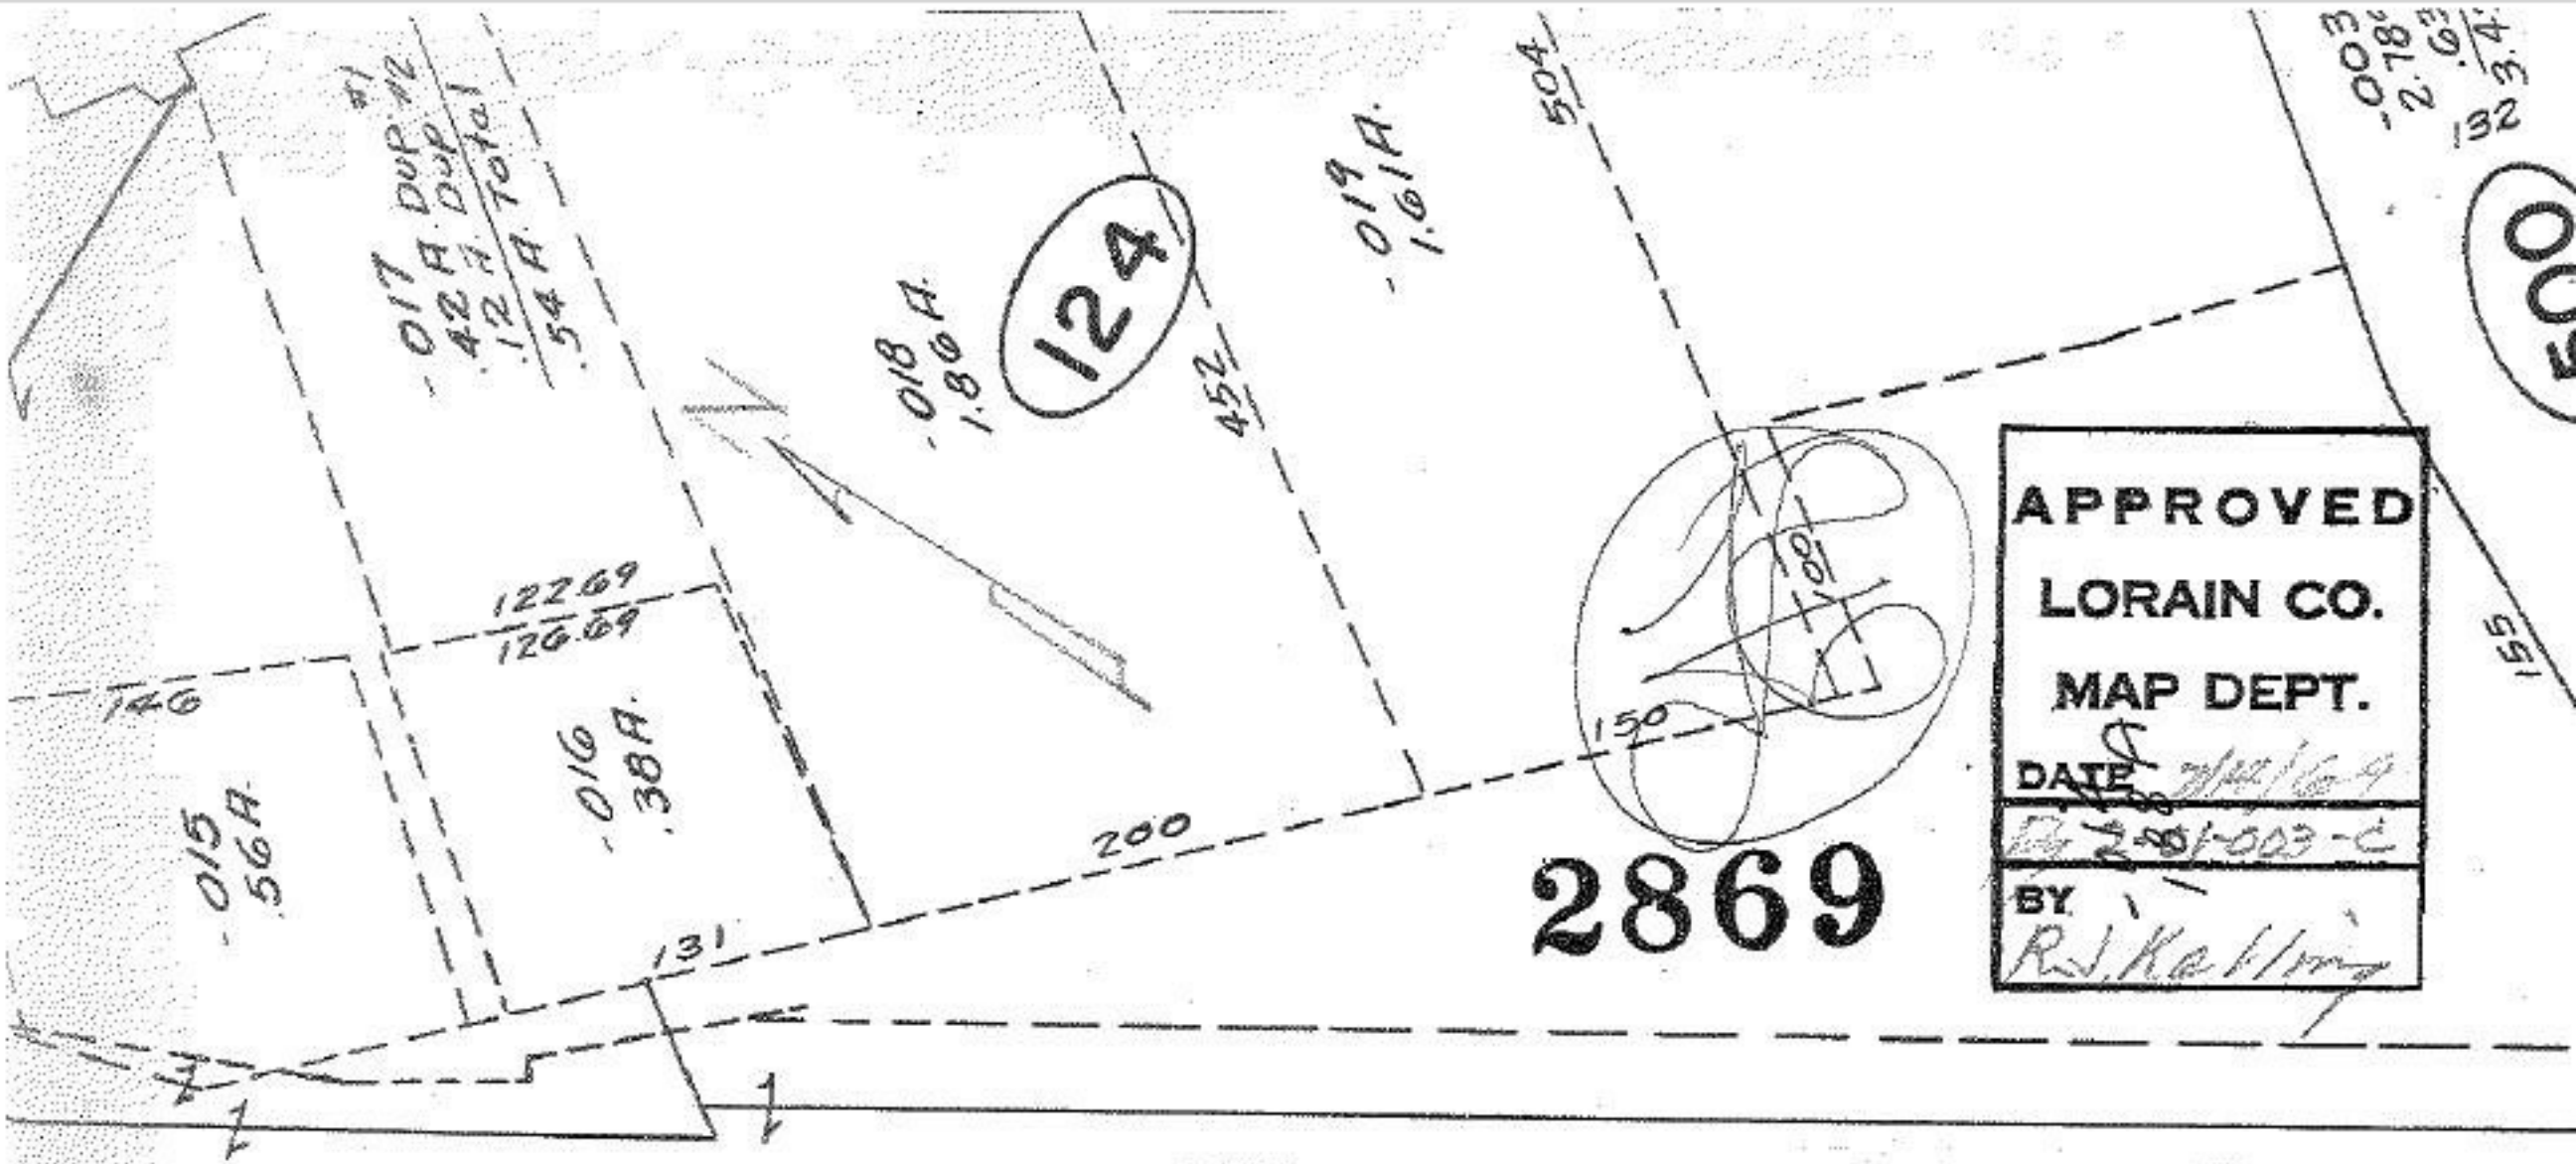

02-01-003-501-037

501

~~.039~~ .042
Bldg. on -039

3.98 A.
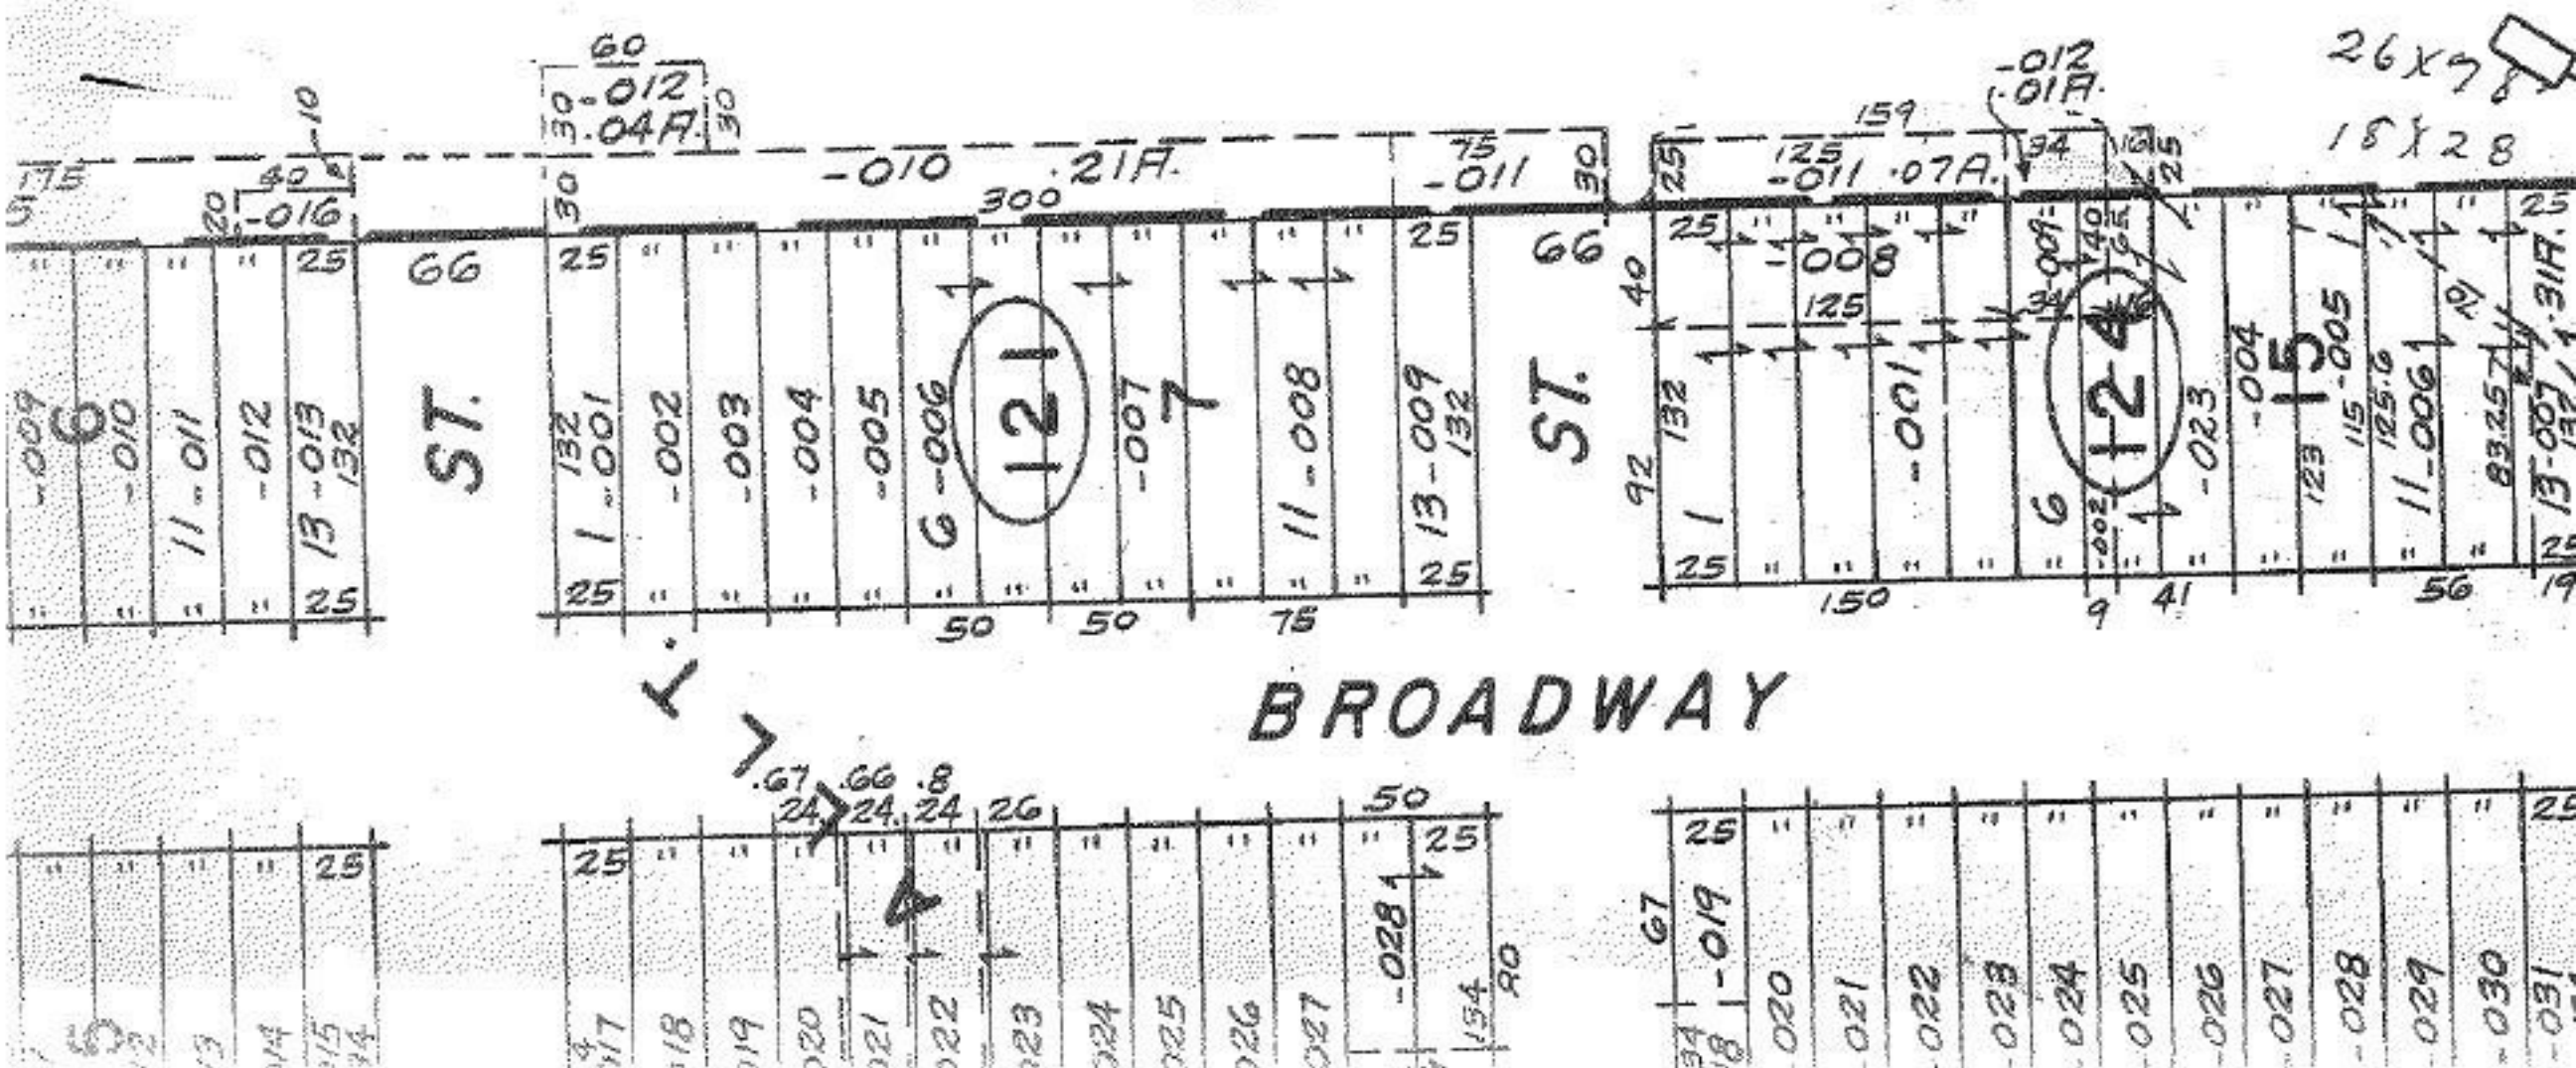
JUL 24 1989