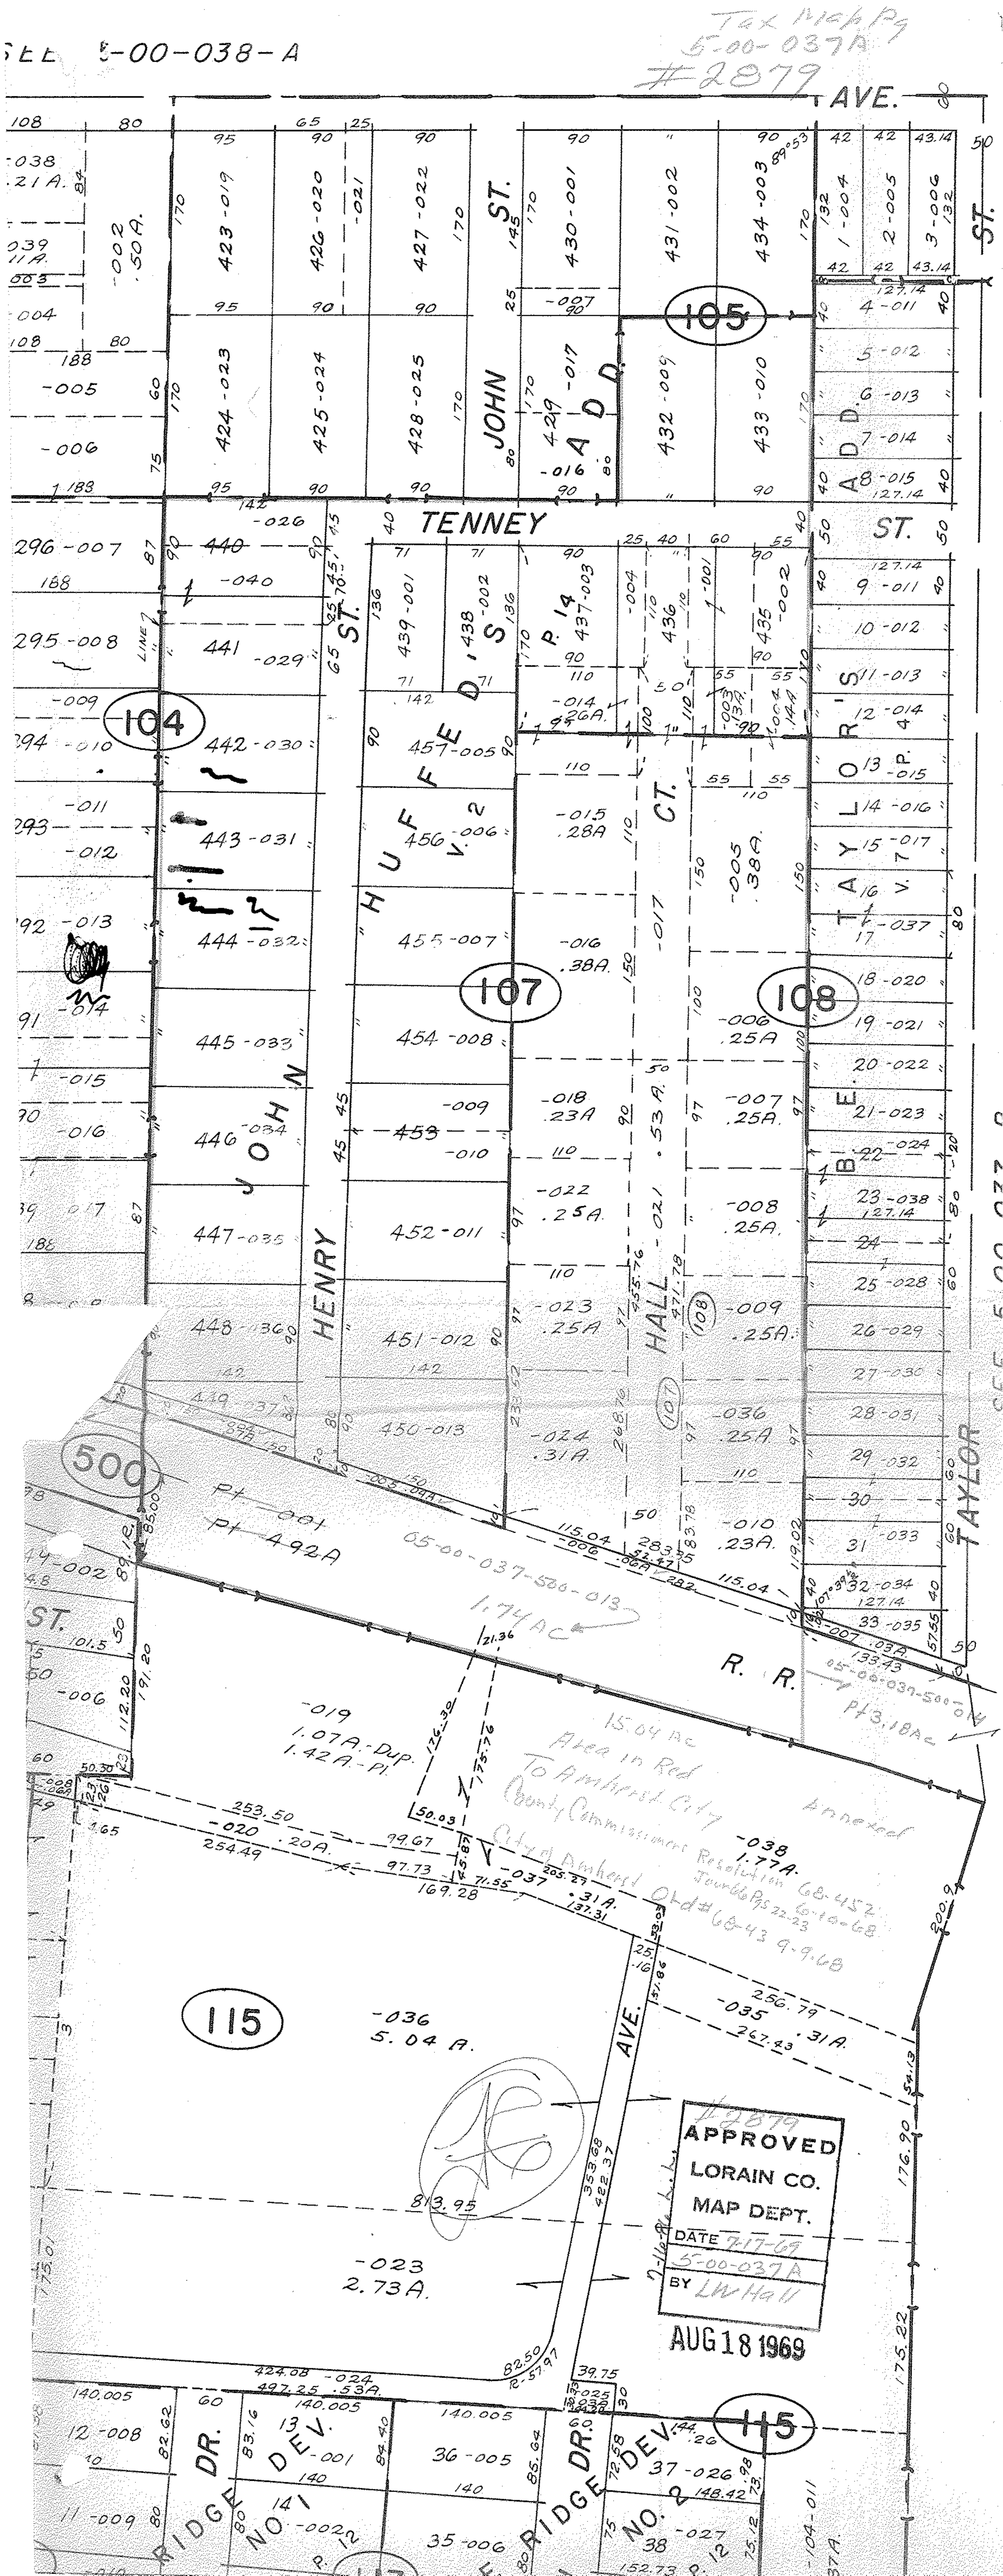
Tax Map Pg 5-00-037A
#2879
AVE.
ST.
JOHN
TENNEY
HUFFED
HENRY
HALL
TAYLOR
CT.
ADD.
105
104
107
108
115
500
R. R.
05-00-037-500-013
1.74 AC
Pt. 001
Pt. 492A
15.04 Ac
Area in Red
To Amherst City
County Commissioners Resolution 68-452
Ord #68-43 9-9-68
Annexed
APPROVED
LORAIN CO.
MAP DEPT.
DATE 7-17-69
5-00-037A
BY LW Hall
AUG 18 1969
RIDGE DR. DEV. NO. 2
RIDGE DR. DEV. NO. 1