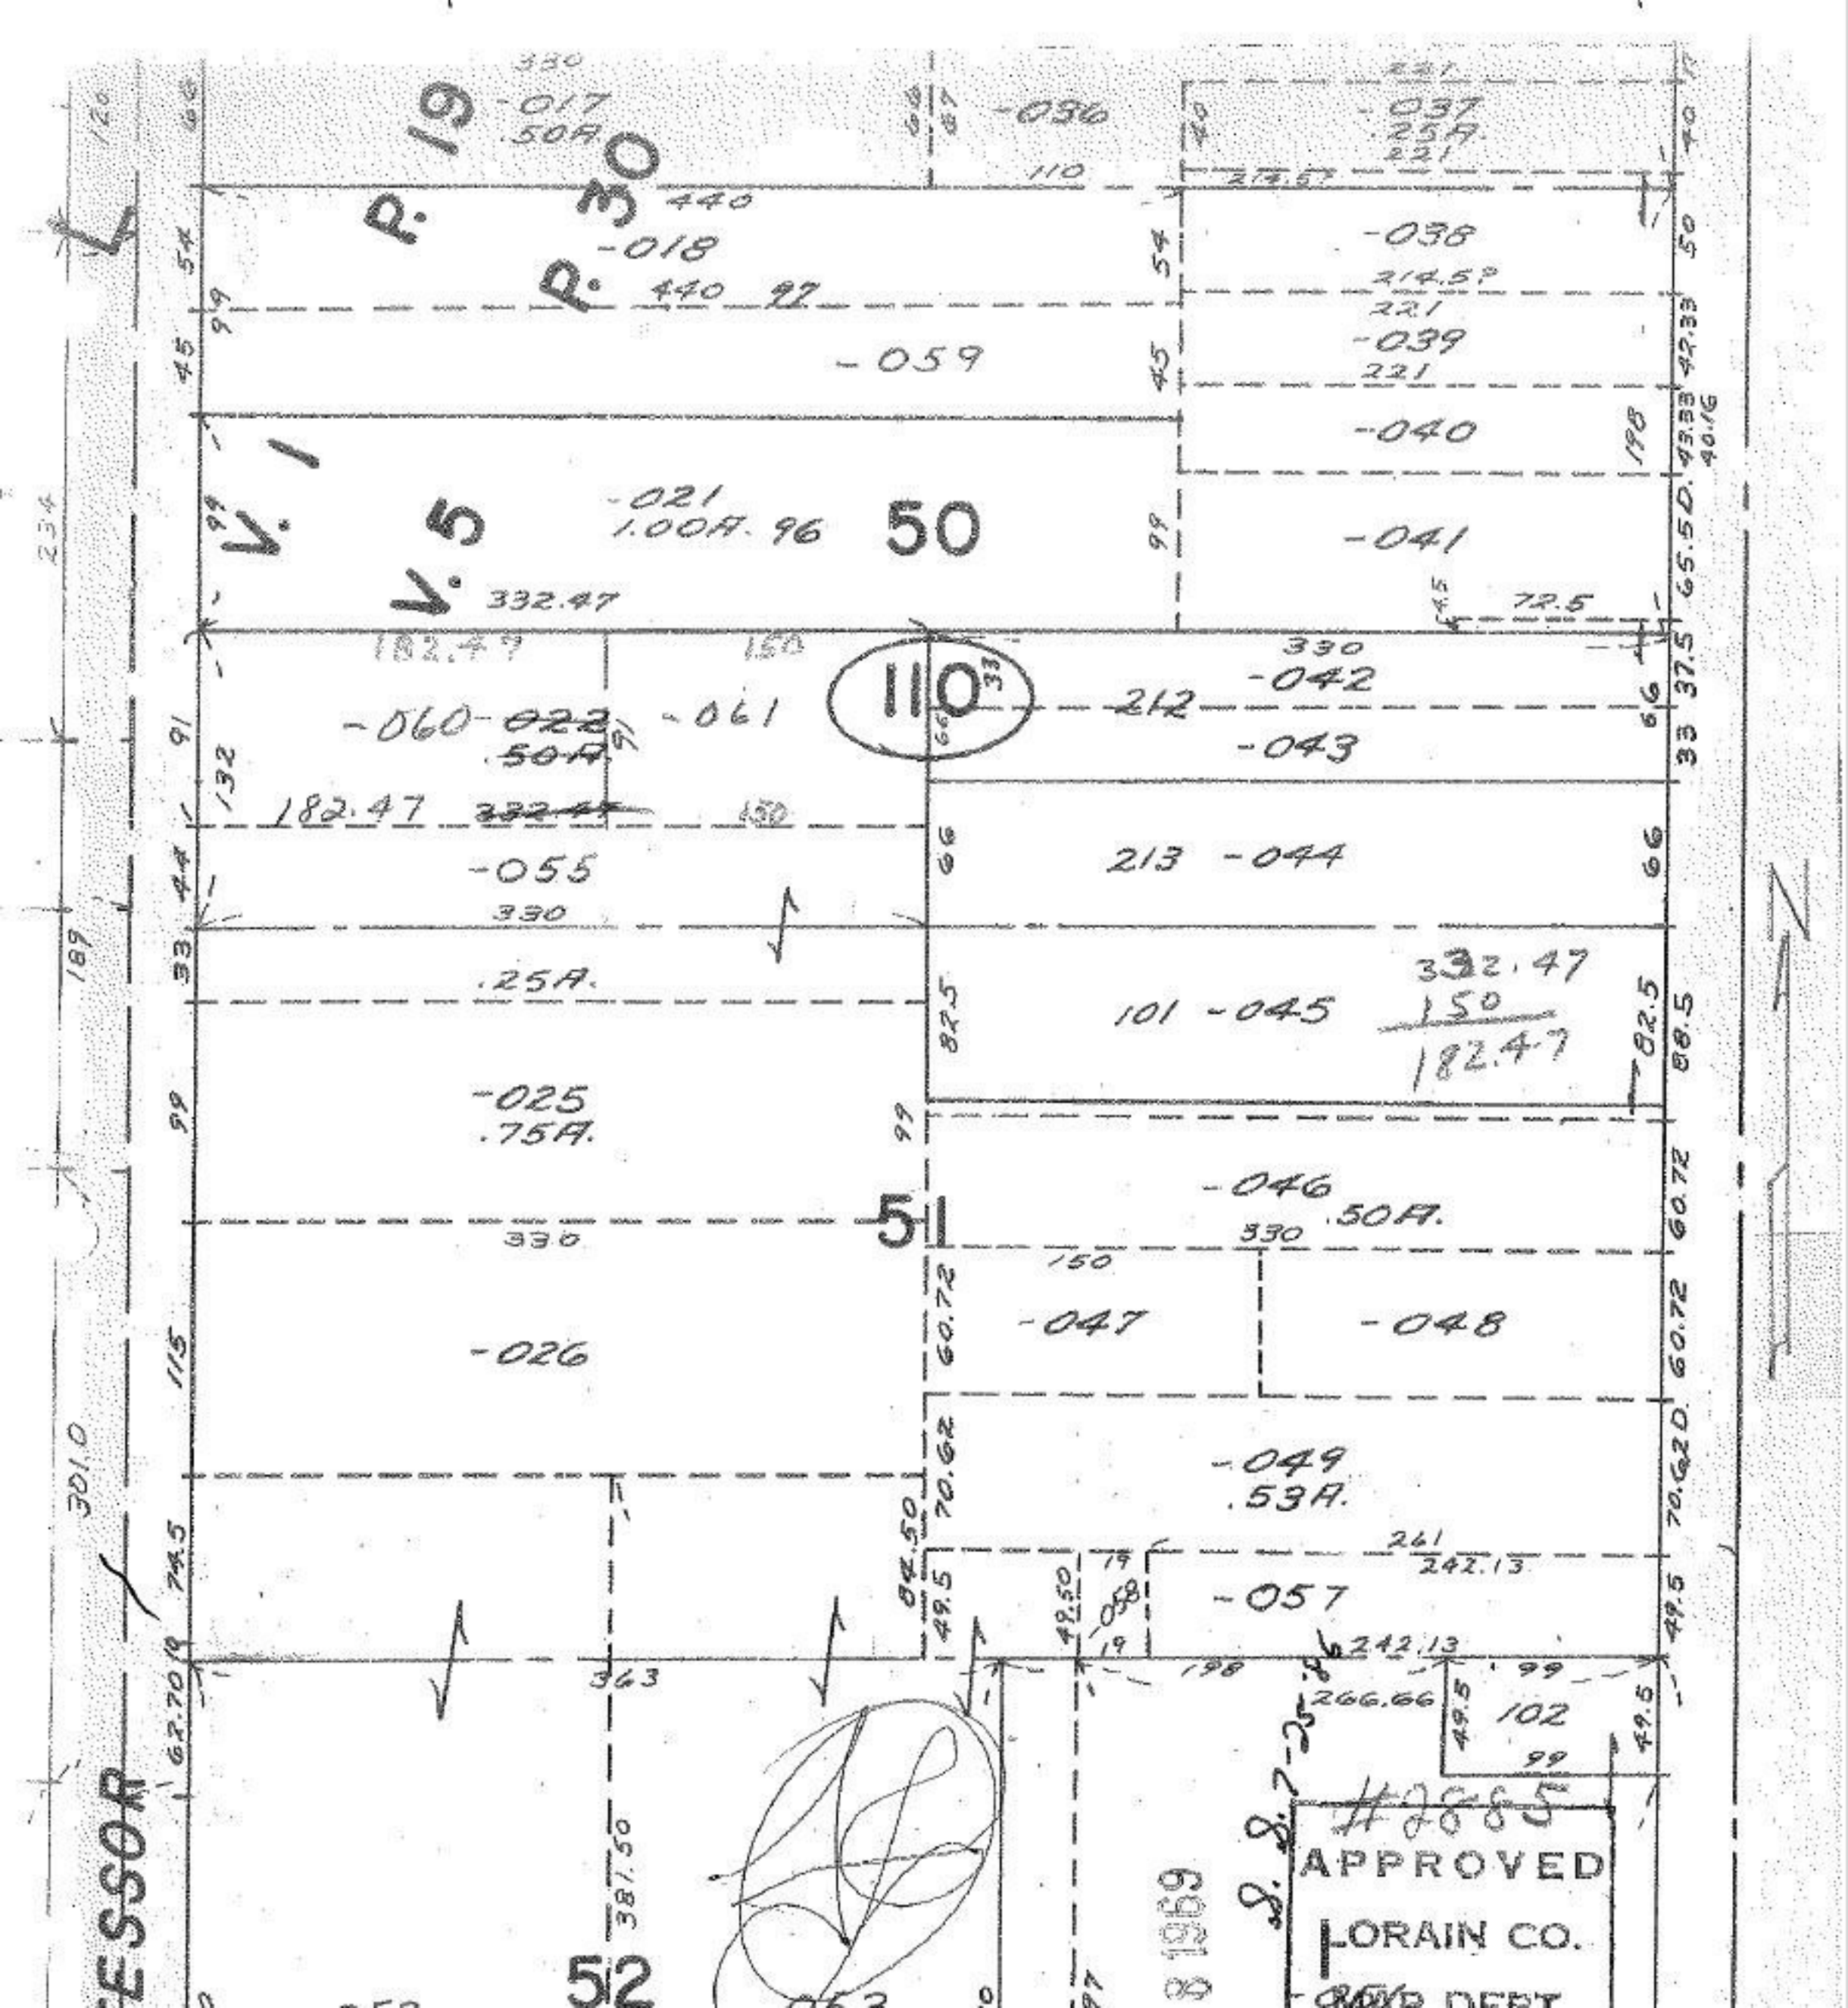

P. 19
P. 30
V. 1
V. 5
50
110
51
52
-017
.50A.
-018
-059
-021
1.00A. 96
-036
-037
.25A.
-038
-039
-040
-041
-042
-043
-060
-061
-055
-025
.75A.
-026
-046
.50A.
-047
-048
-049
.53A.
-057
-044
-045
101
212
213
102
332.47
150
182.47
APPROVED
LORAIN CO.