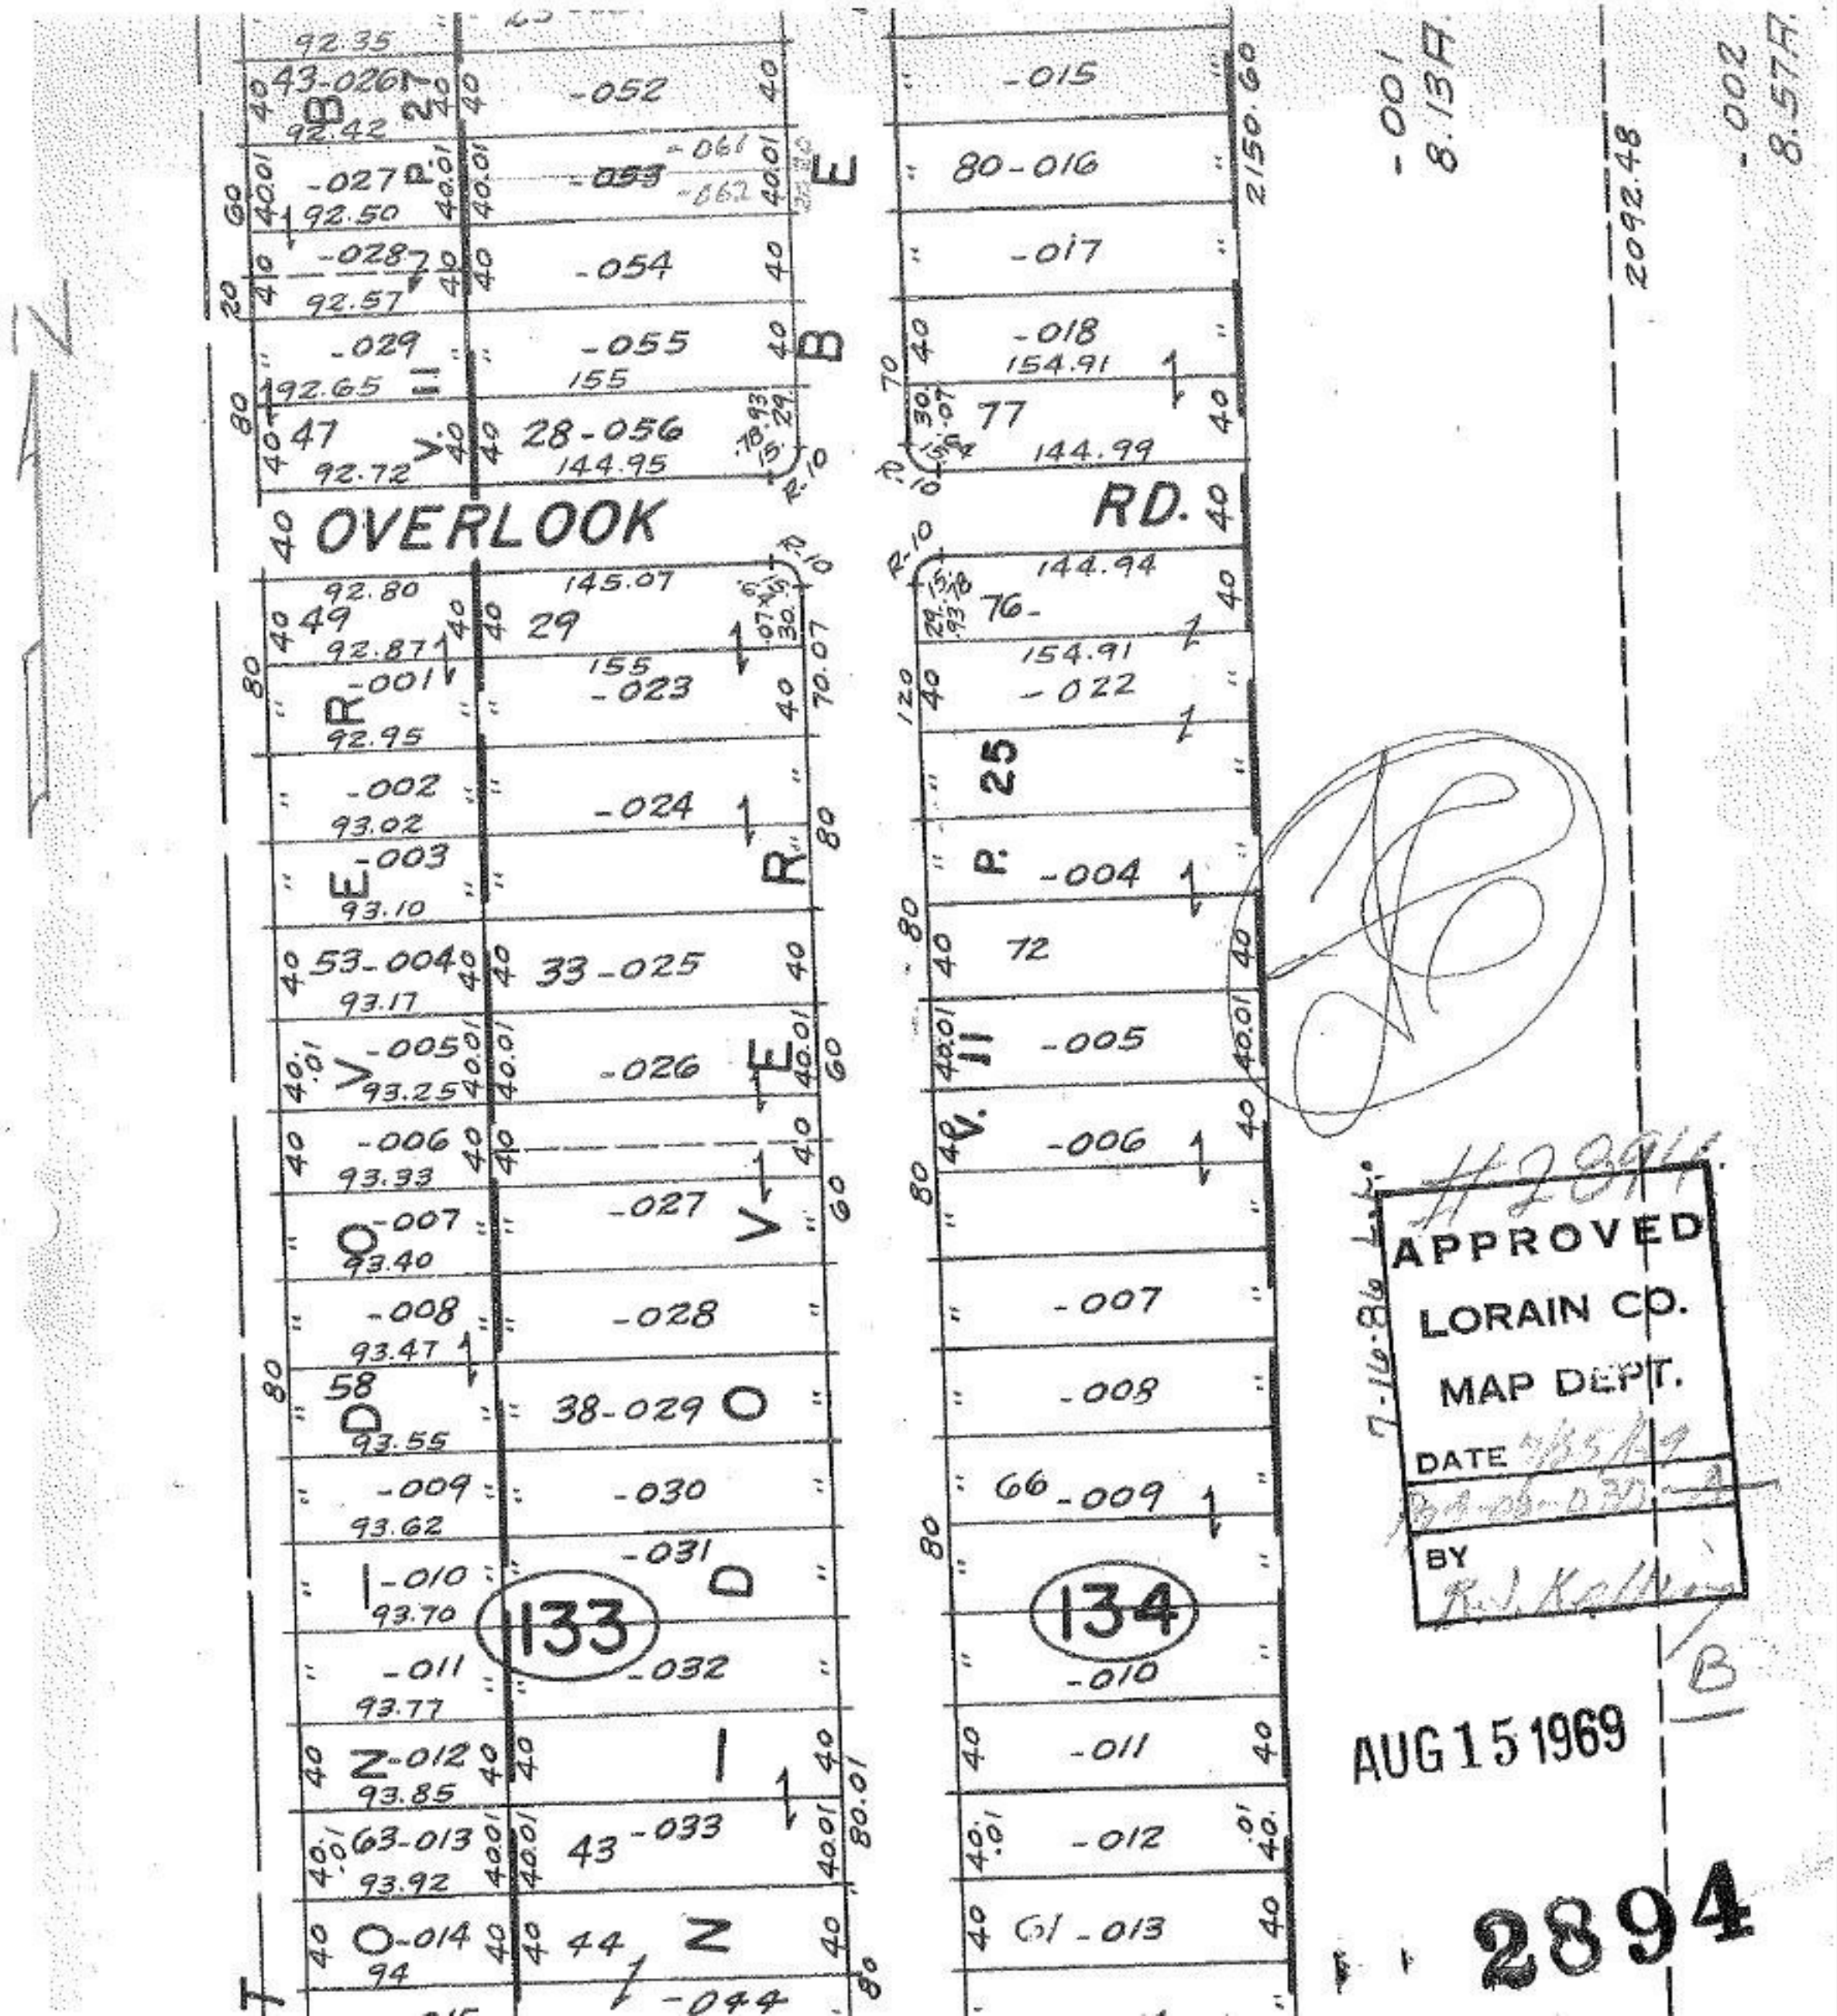

OVERLOOK
RD.
133
134
2150.60
2092.48
-001
8.13A.
-002
8.57A.
APPROVED
LORAIN CO.
MAP DEPT.
DATE
BY
AUG 15 1969
2894