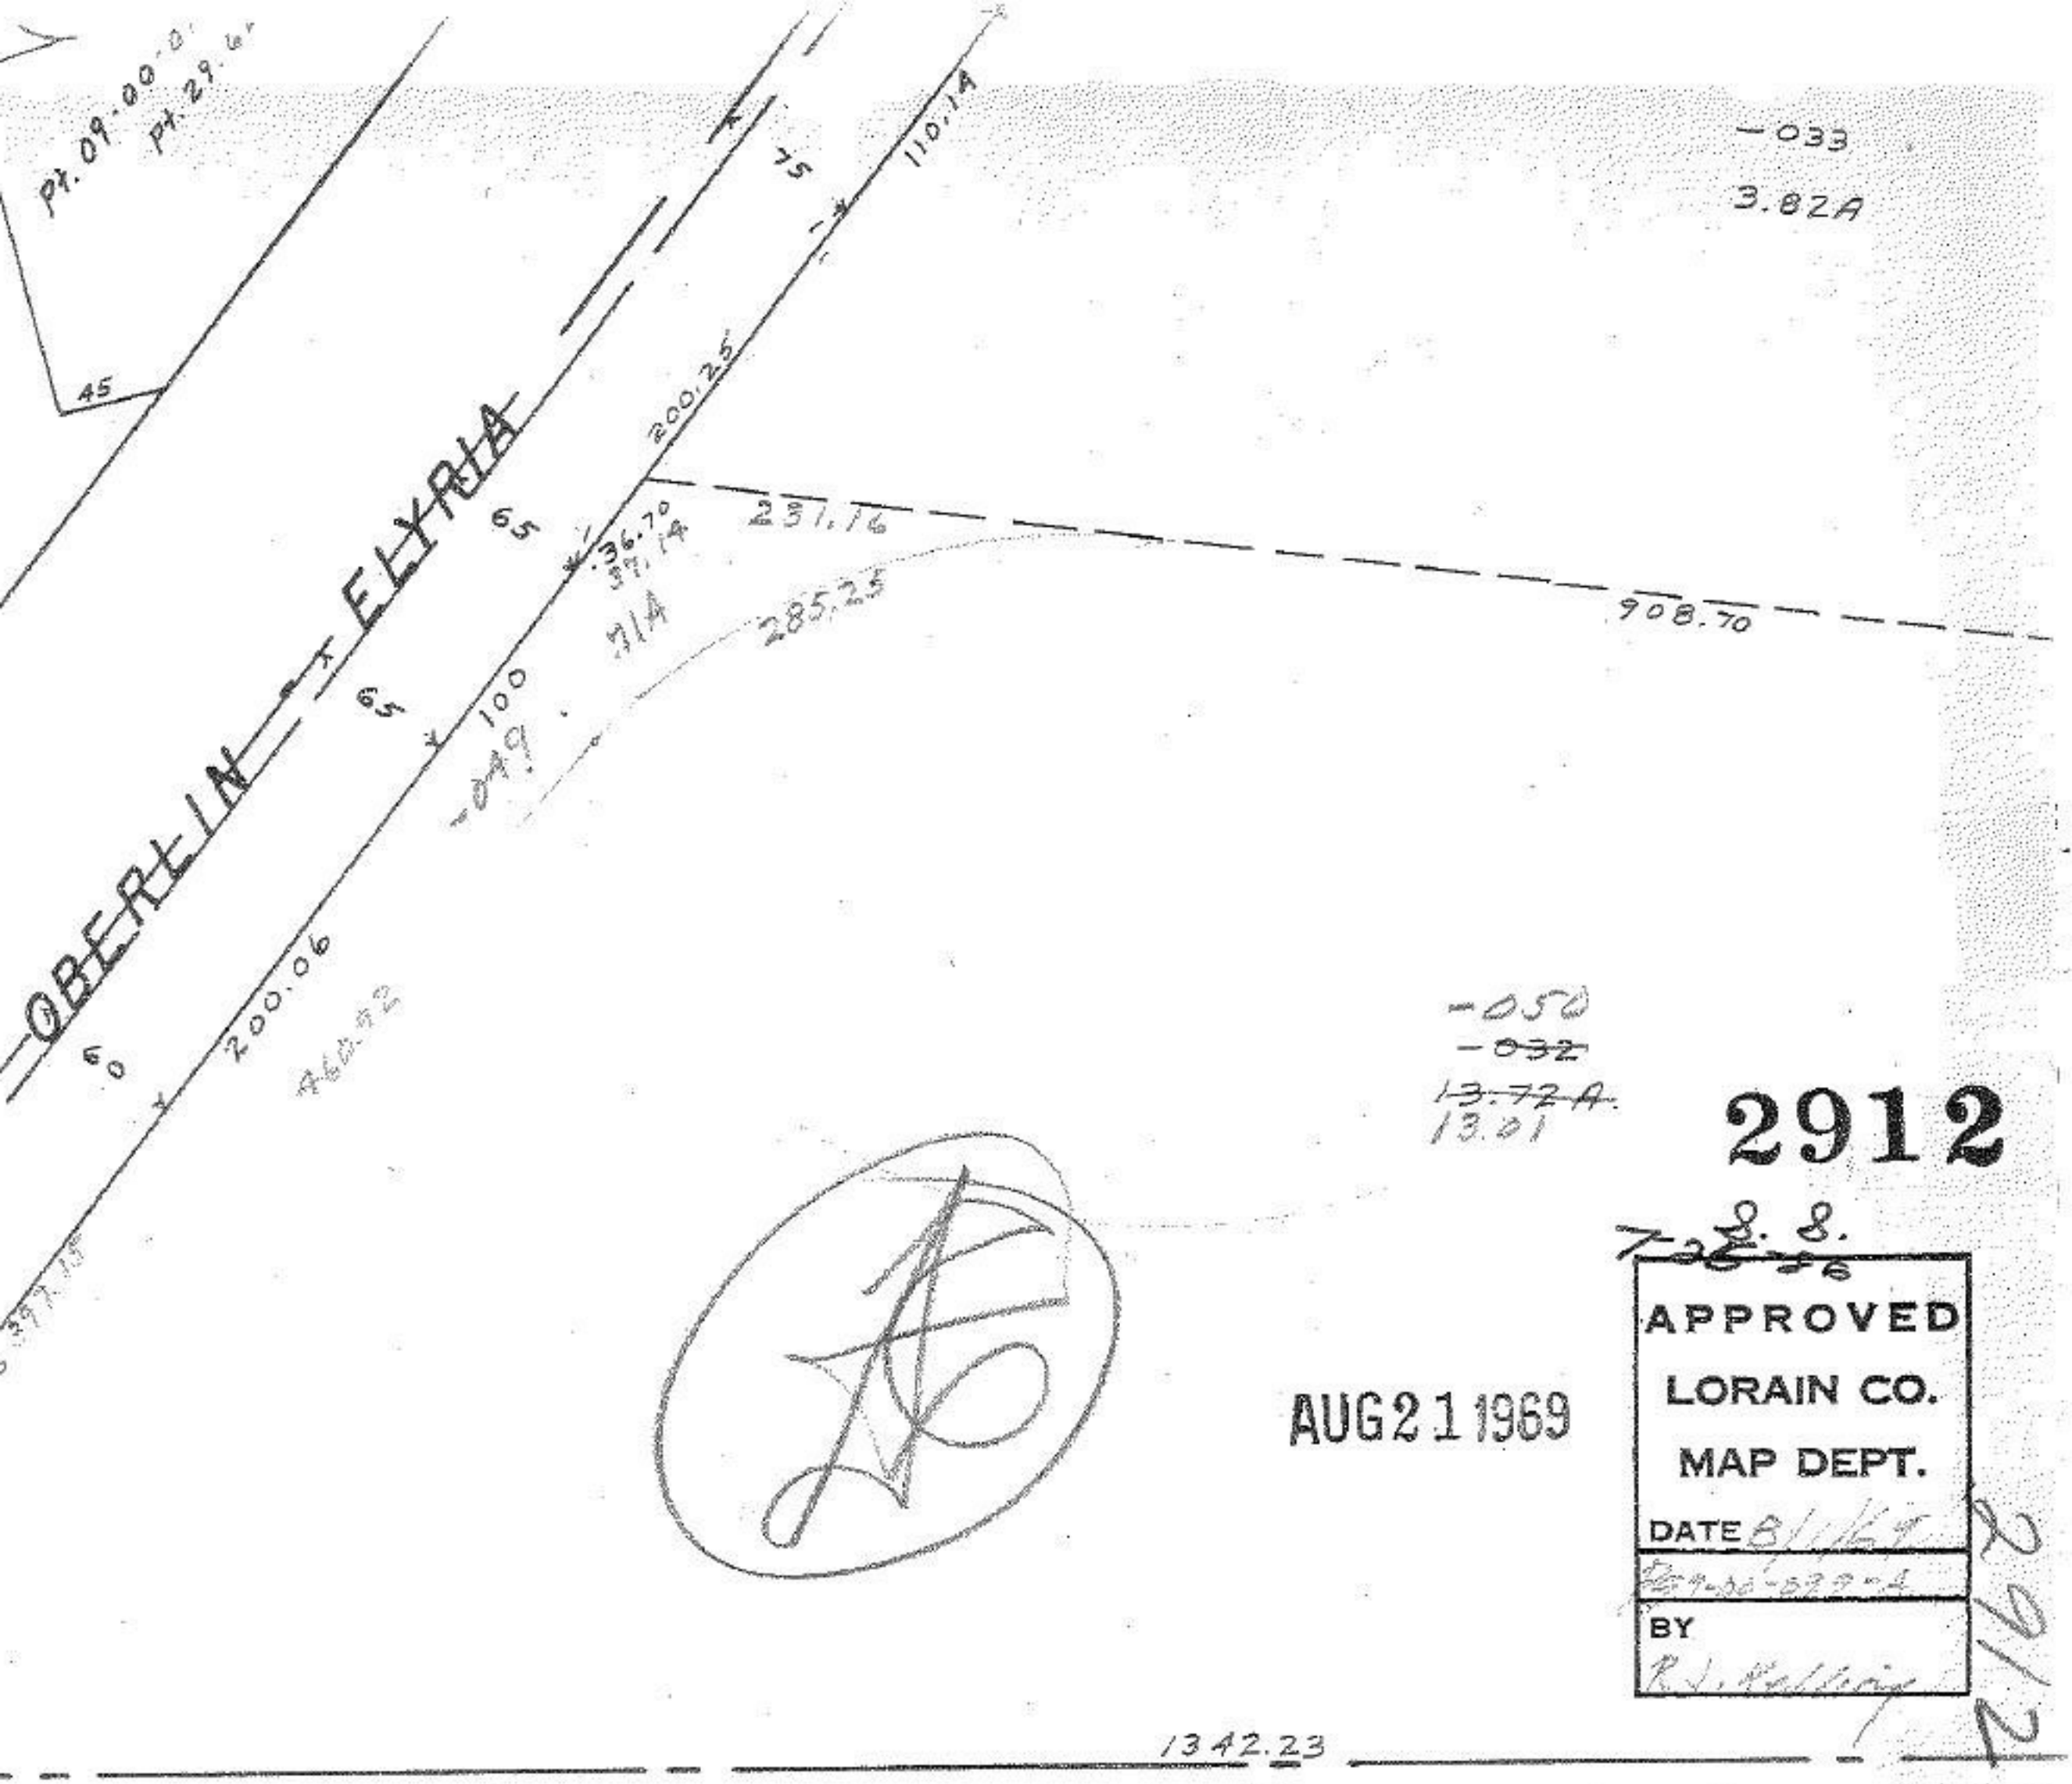

Pt. 09-00-0
Pt. 29.6
45
75
110.14
-033
3.82A
200.25
OBERLIN - ELYRIA
65
36.70
37.14
71A
231.16
285.25
908.70
65
100
-049
200.06
460.92
-050
-032
13.72A
13.01
2912
8.8.
APPROVED
LORAIN CO.
MAP DEPT.
DATE 8/1/69
BY
AUG 21 1969
1342.23
SEE 9-H