2925

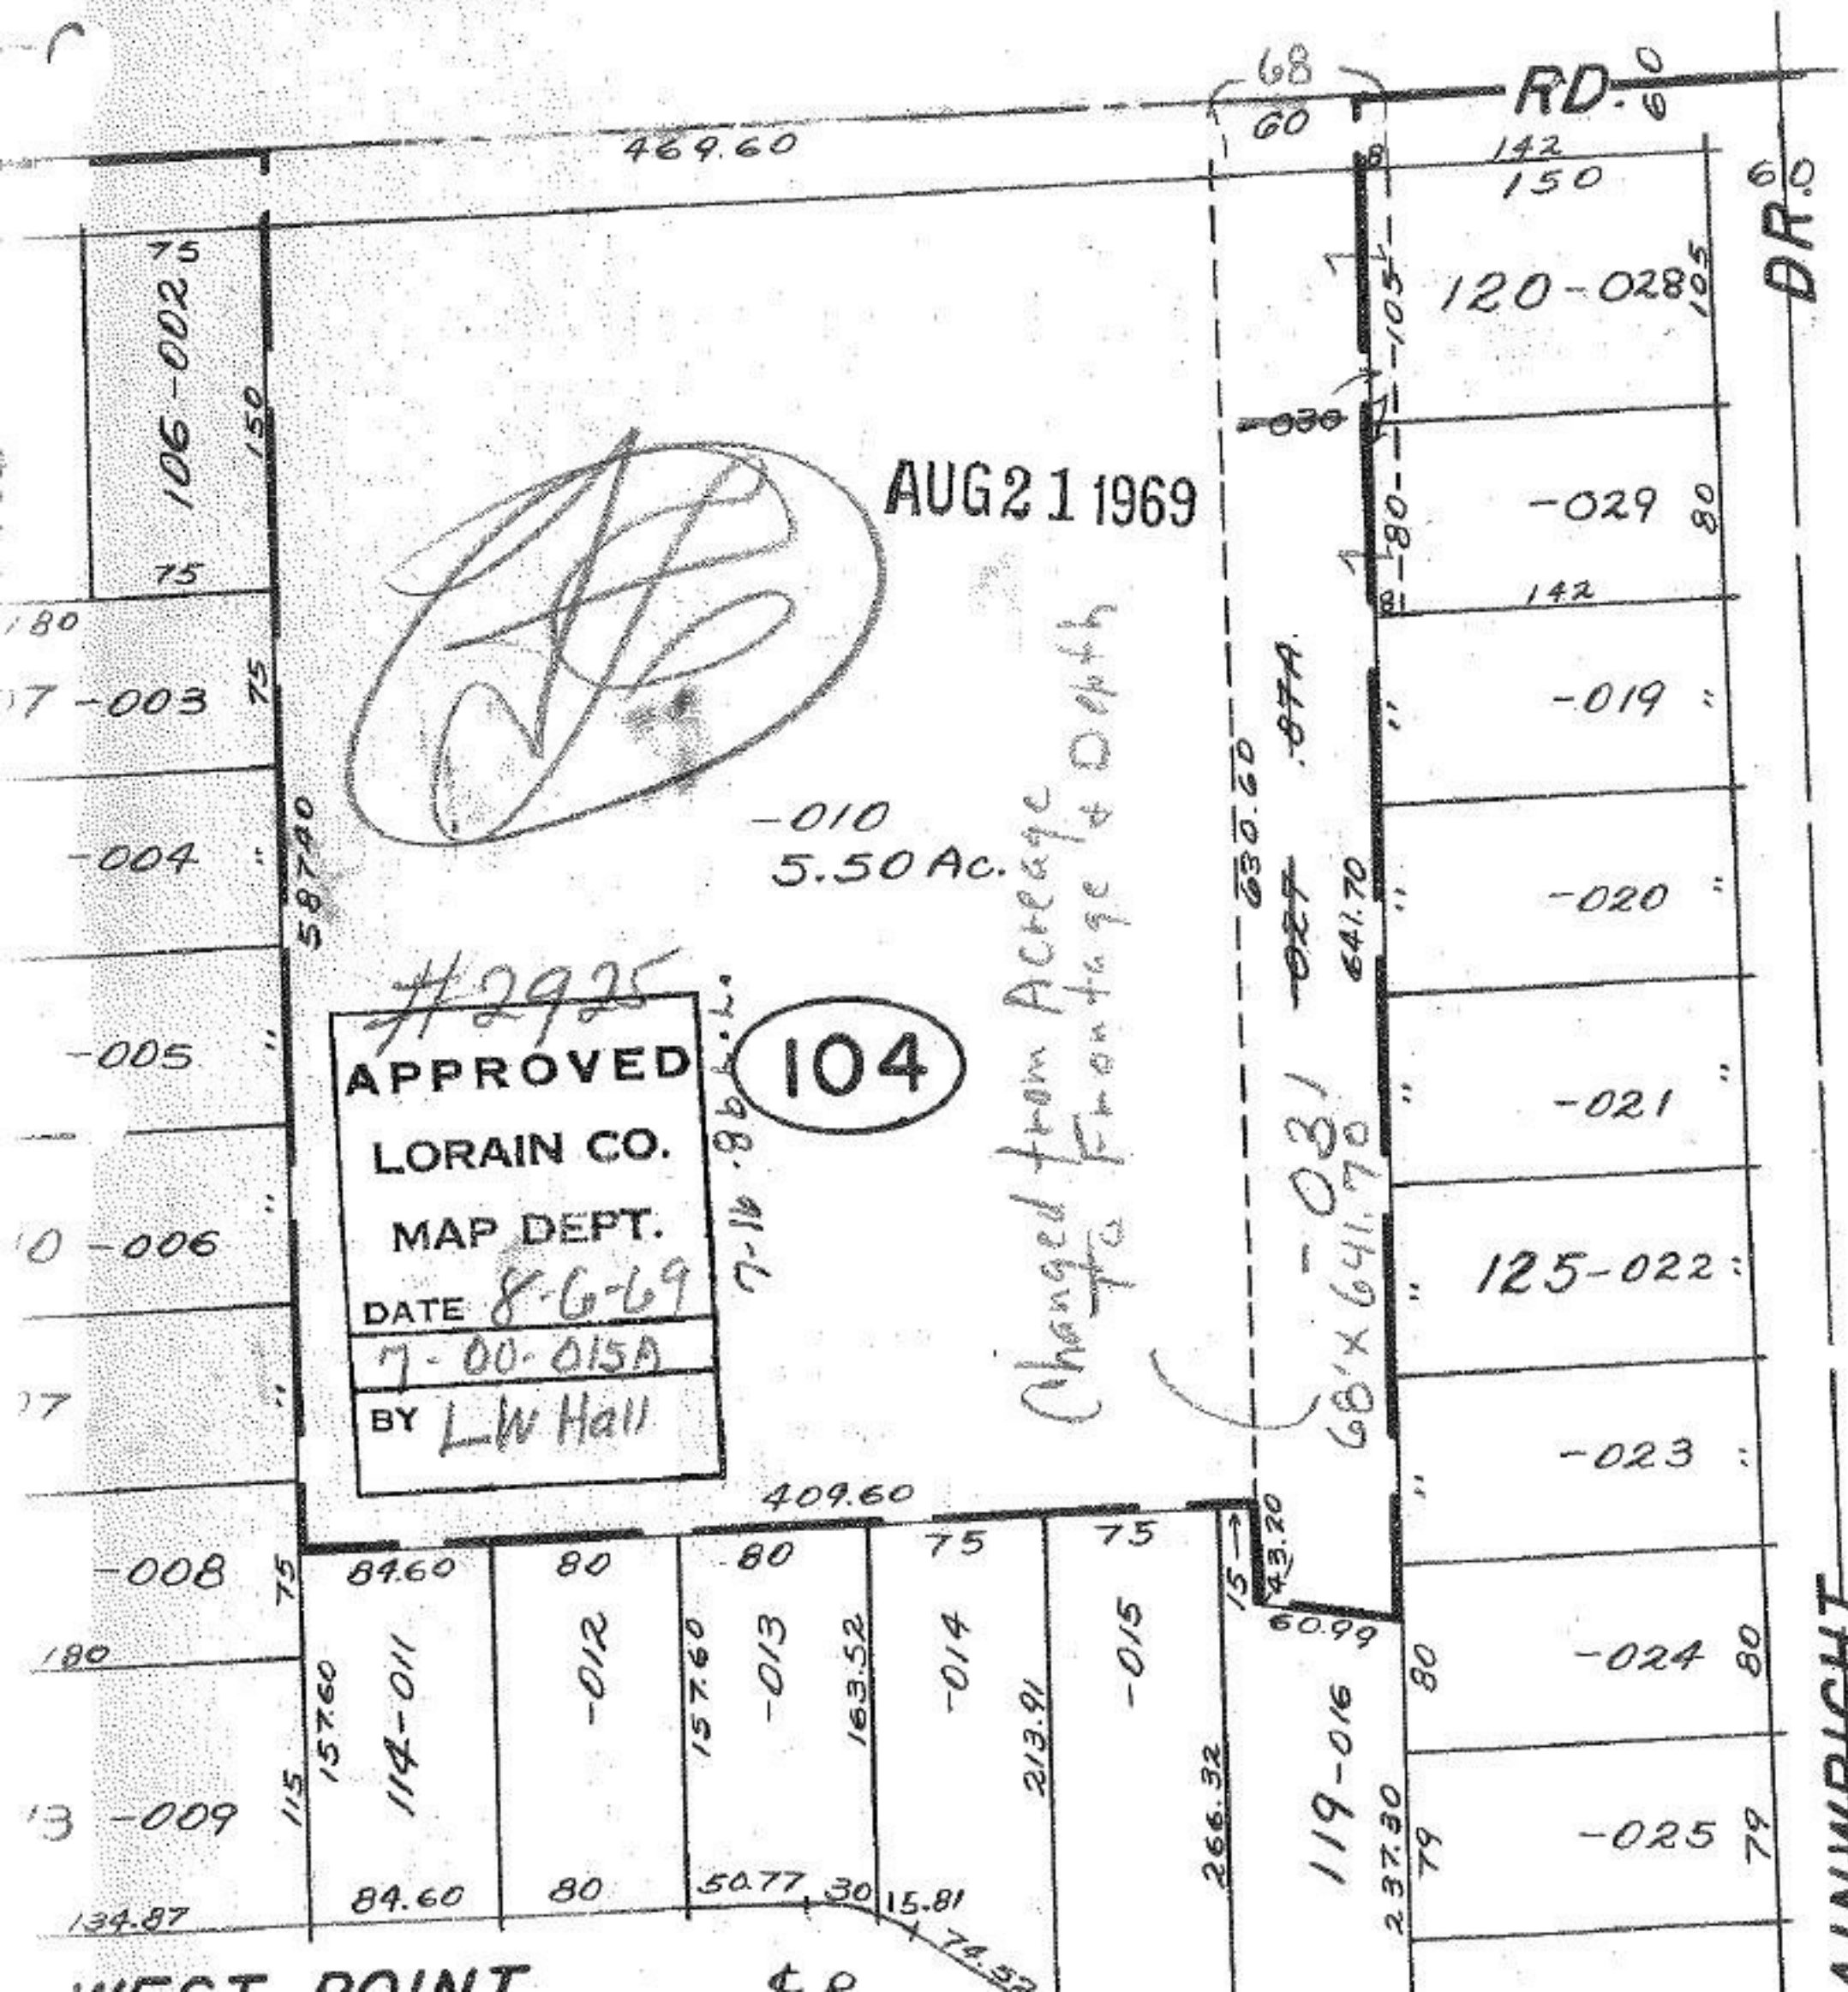

RD.
DR.
469.60
68
60
142
150
120-028
105
-029
80
142
-019
-020
-021
125-022
-023
-024
-025
106-002
75
150
-003
-004
-005
-006
-008
-009
-010
5.50 Ac.
587.40
630.60
641.70
-031
68'x641.70
409.60
84.60
80
75
114-011
-012
-013
-014
-015
157.60
163.52
213.91
266.32
43.20
60.99
119-016
237.30
134.87
50.77
15.81
74.52
WEST POINT
AUG 21 1969
#2925
APPROVED
LORAIN CO.
MAP DEPT.
DATE 8-6-69
7-00-015A
BY LW Hall
104
Changed from Acreage to Frontage & Depth