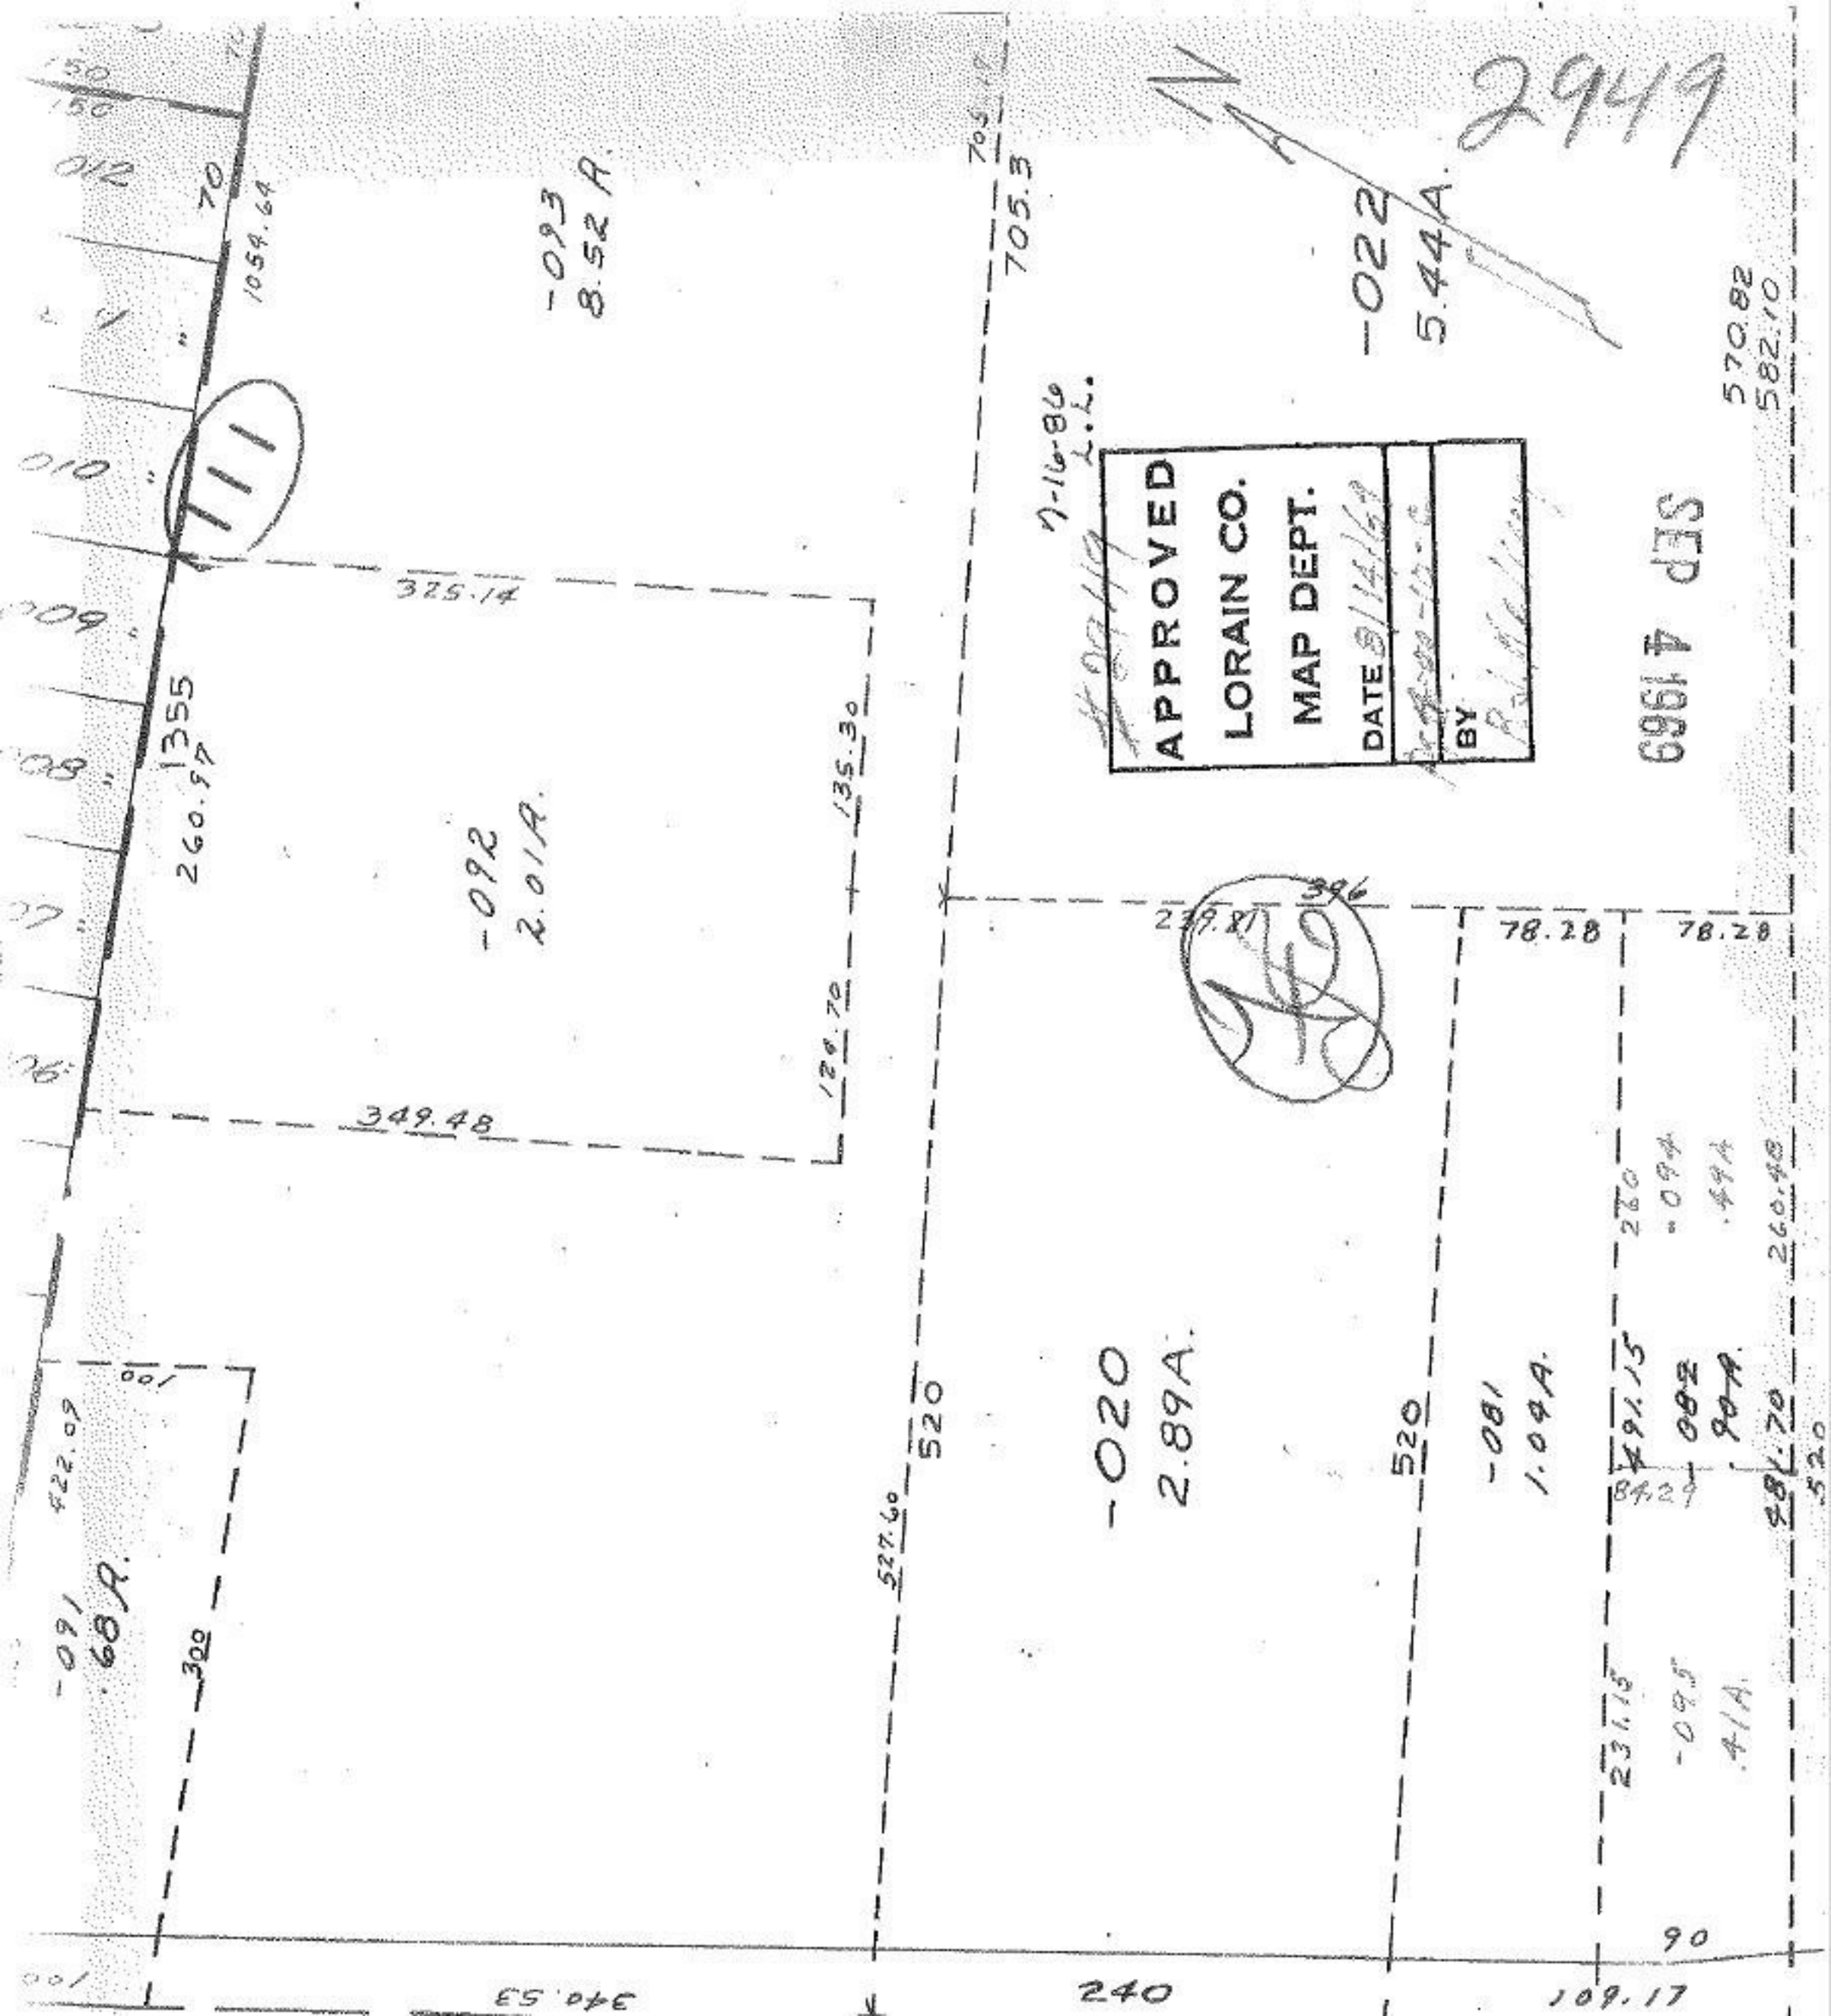
2949
APPROVED
LORAIN CO.
MAP DEPT.
DATE
BY
SEP 4 1969
-093
8.52 A.
-022
5.44 A.
-092
2.01 A.
-020
2.89 A.
-081
1.04 A.
-091
.68 A.
-095
.41 A.
1355
1054.64
325.14
260.97
135.30
349.48
124.70
705.3
570.82
582.10
239.81
78.28
78.28
520
520
527.60
422.09
300
260.48
491.15
481.70
231.15
84.29
90
240
109.17
340.53