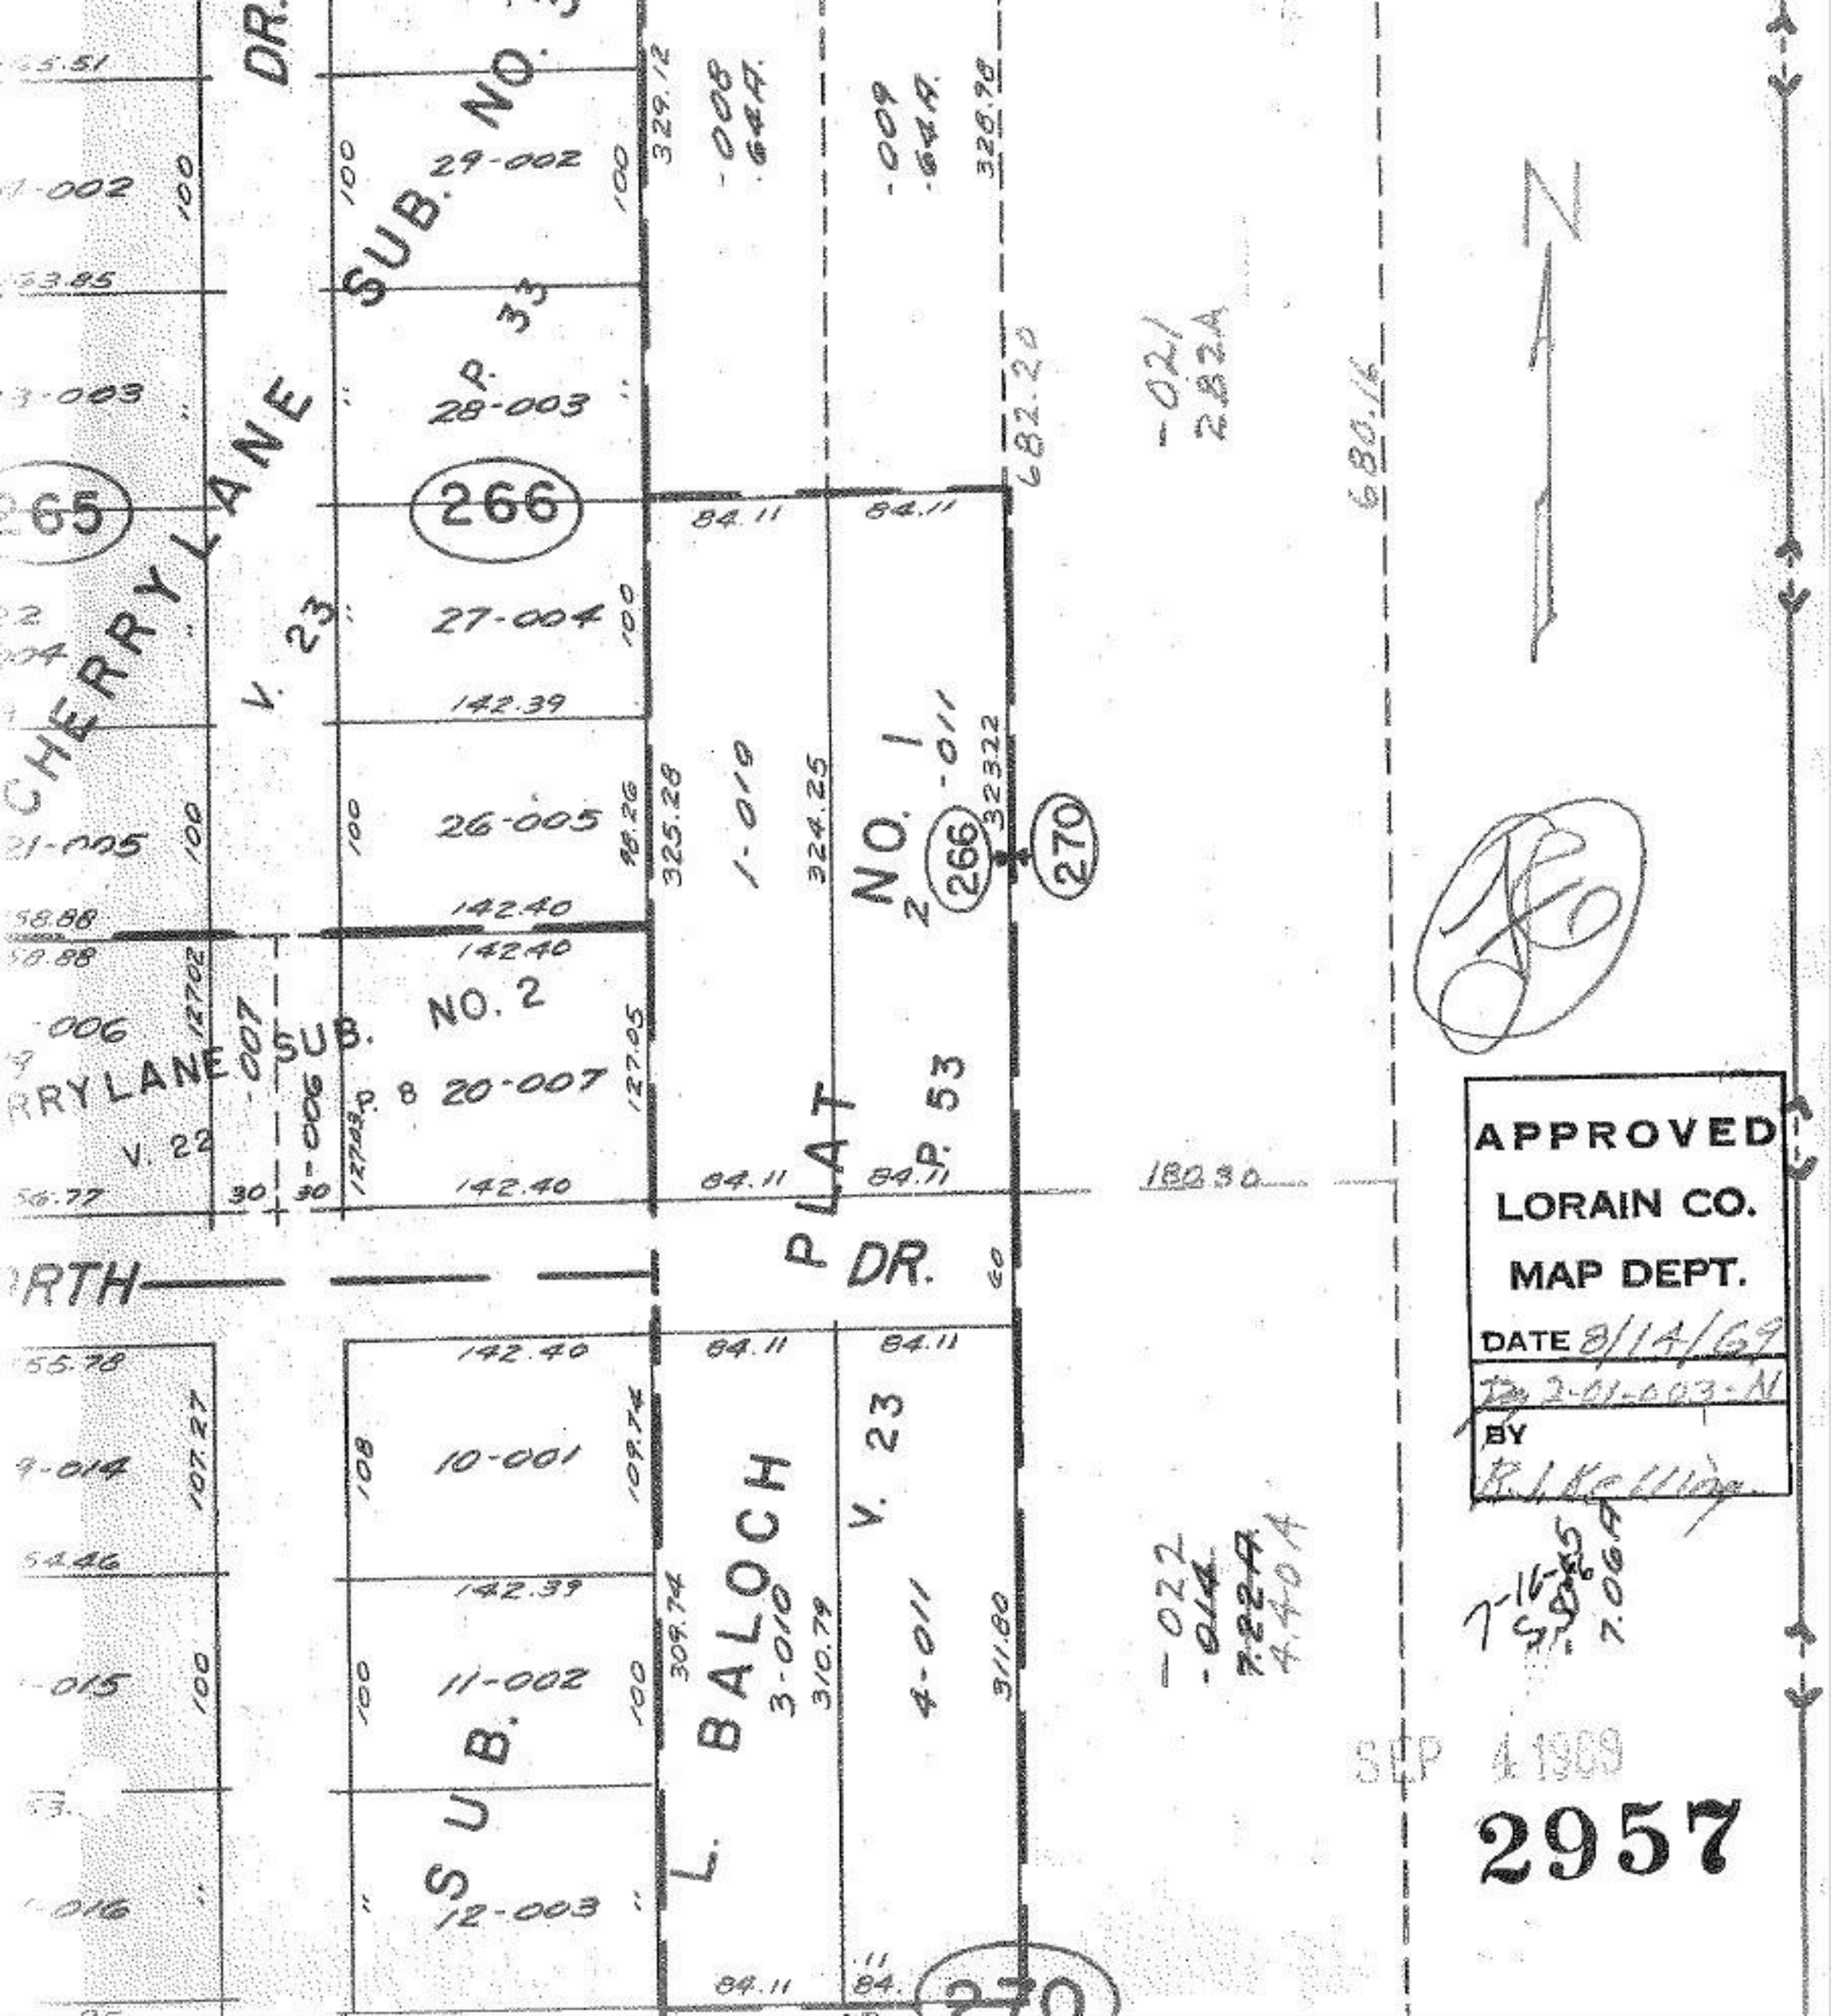

CHERRYLANE SUB. NO. 3
DR.
V. 23
P. 33
29-002
28-003
27-004
26-005
20-007
10-001
11-002
12-003
265
266
270
CHERRYLANE SUB. NO. 2
V. 22
P. 8
RTH
L. BALOCH
PLAT NO. 1
P. 53
DR.
V. 23
SUB.
329.12
328.98
-008
.64A
-009
.64A
-021
2.82A
682.20
680.16
84.11
142.39
142.40
325.28
324.25
323.22
1-010
-011
127.05
127.02
-007
-006
127.03
180.30
309.74
310.79
311.80
-022
-014
7.22A
4.40A
7-16-65
7.06A
N
APPROVED
LORAIN CO.
MAP DEPT.
DATE 8/14/69
2-01-003-N
BY
R.J. Kelling
SEP 4 1969
2957