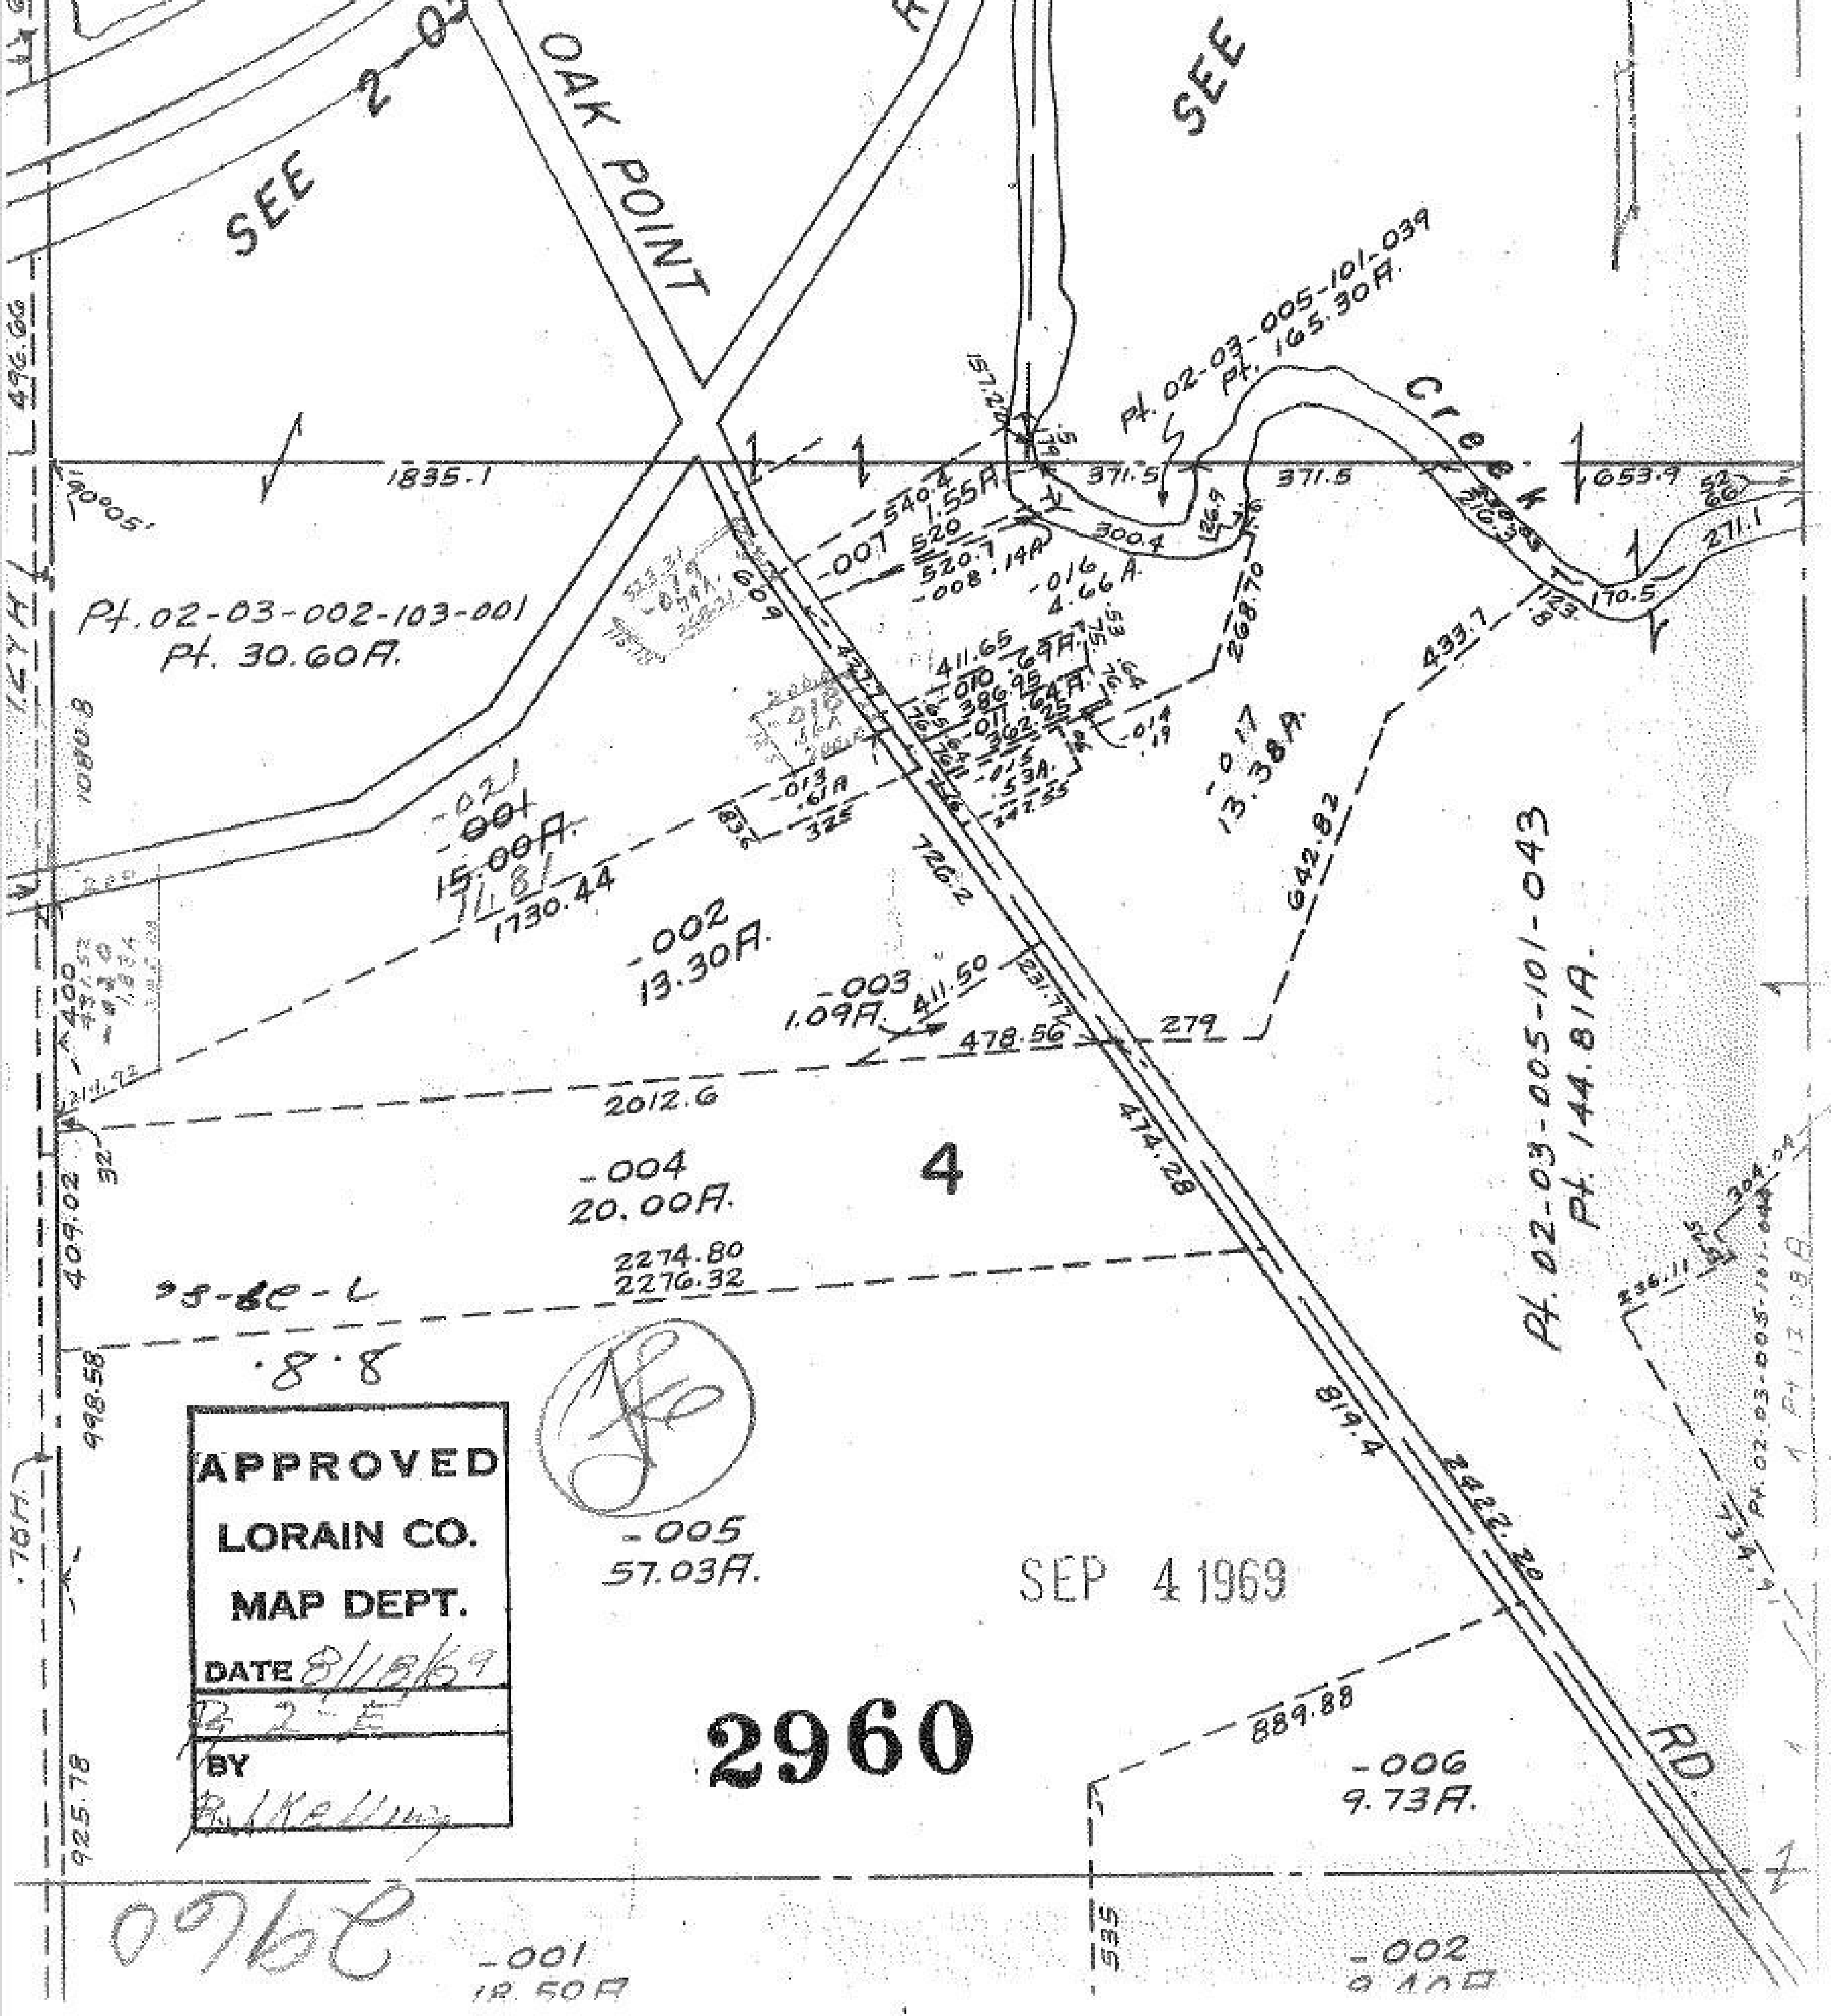
APPROVED
LORAIN CO.
MAP DEPT.
DATE 8/18/69
BY
2960
SEP 4 1969
OAK POINT
RD.
SEE
SEE
Creek
Pt. 02-03-002-103-001
Pt. 30.60A.
Pt. 02-03-005-101-039
Pt. 165.30A.
Pt. 02-03-005-101-043
Pt. 144.81A.
4
-002
13.30A.
-003
1.09A.
-004
20.00A.
-005
57.03A.
-006
9.73A.
-001
15.00A.
-017
13.38A.
-016
4.66A.
-007
1.55A.
1835.1
371.5
371.5
653.9
2012.6
2274.80
2276.32
1730.44
642.82
433.7
726.2
474.28
819.4
889.88
478.56
411.50
279
409.02
998.58
925.78
496.66
1080.8
300.4
271.1
170.5
535