2963

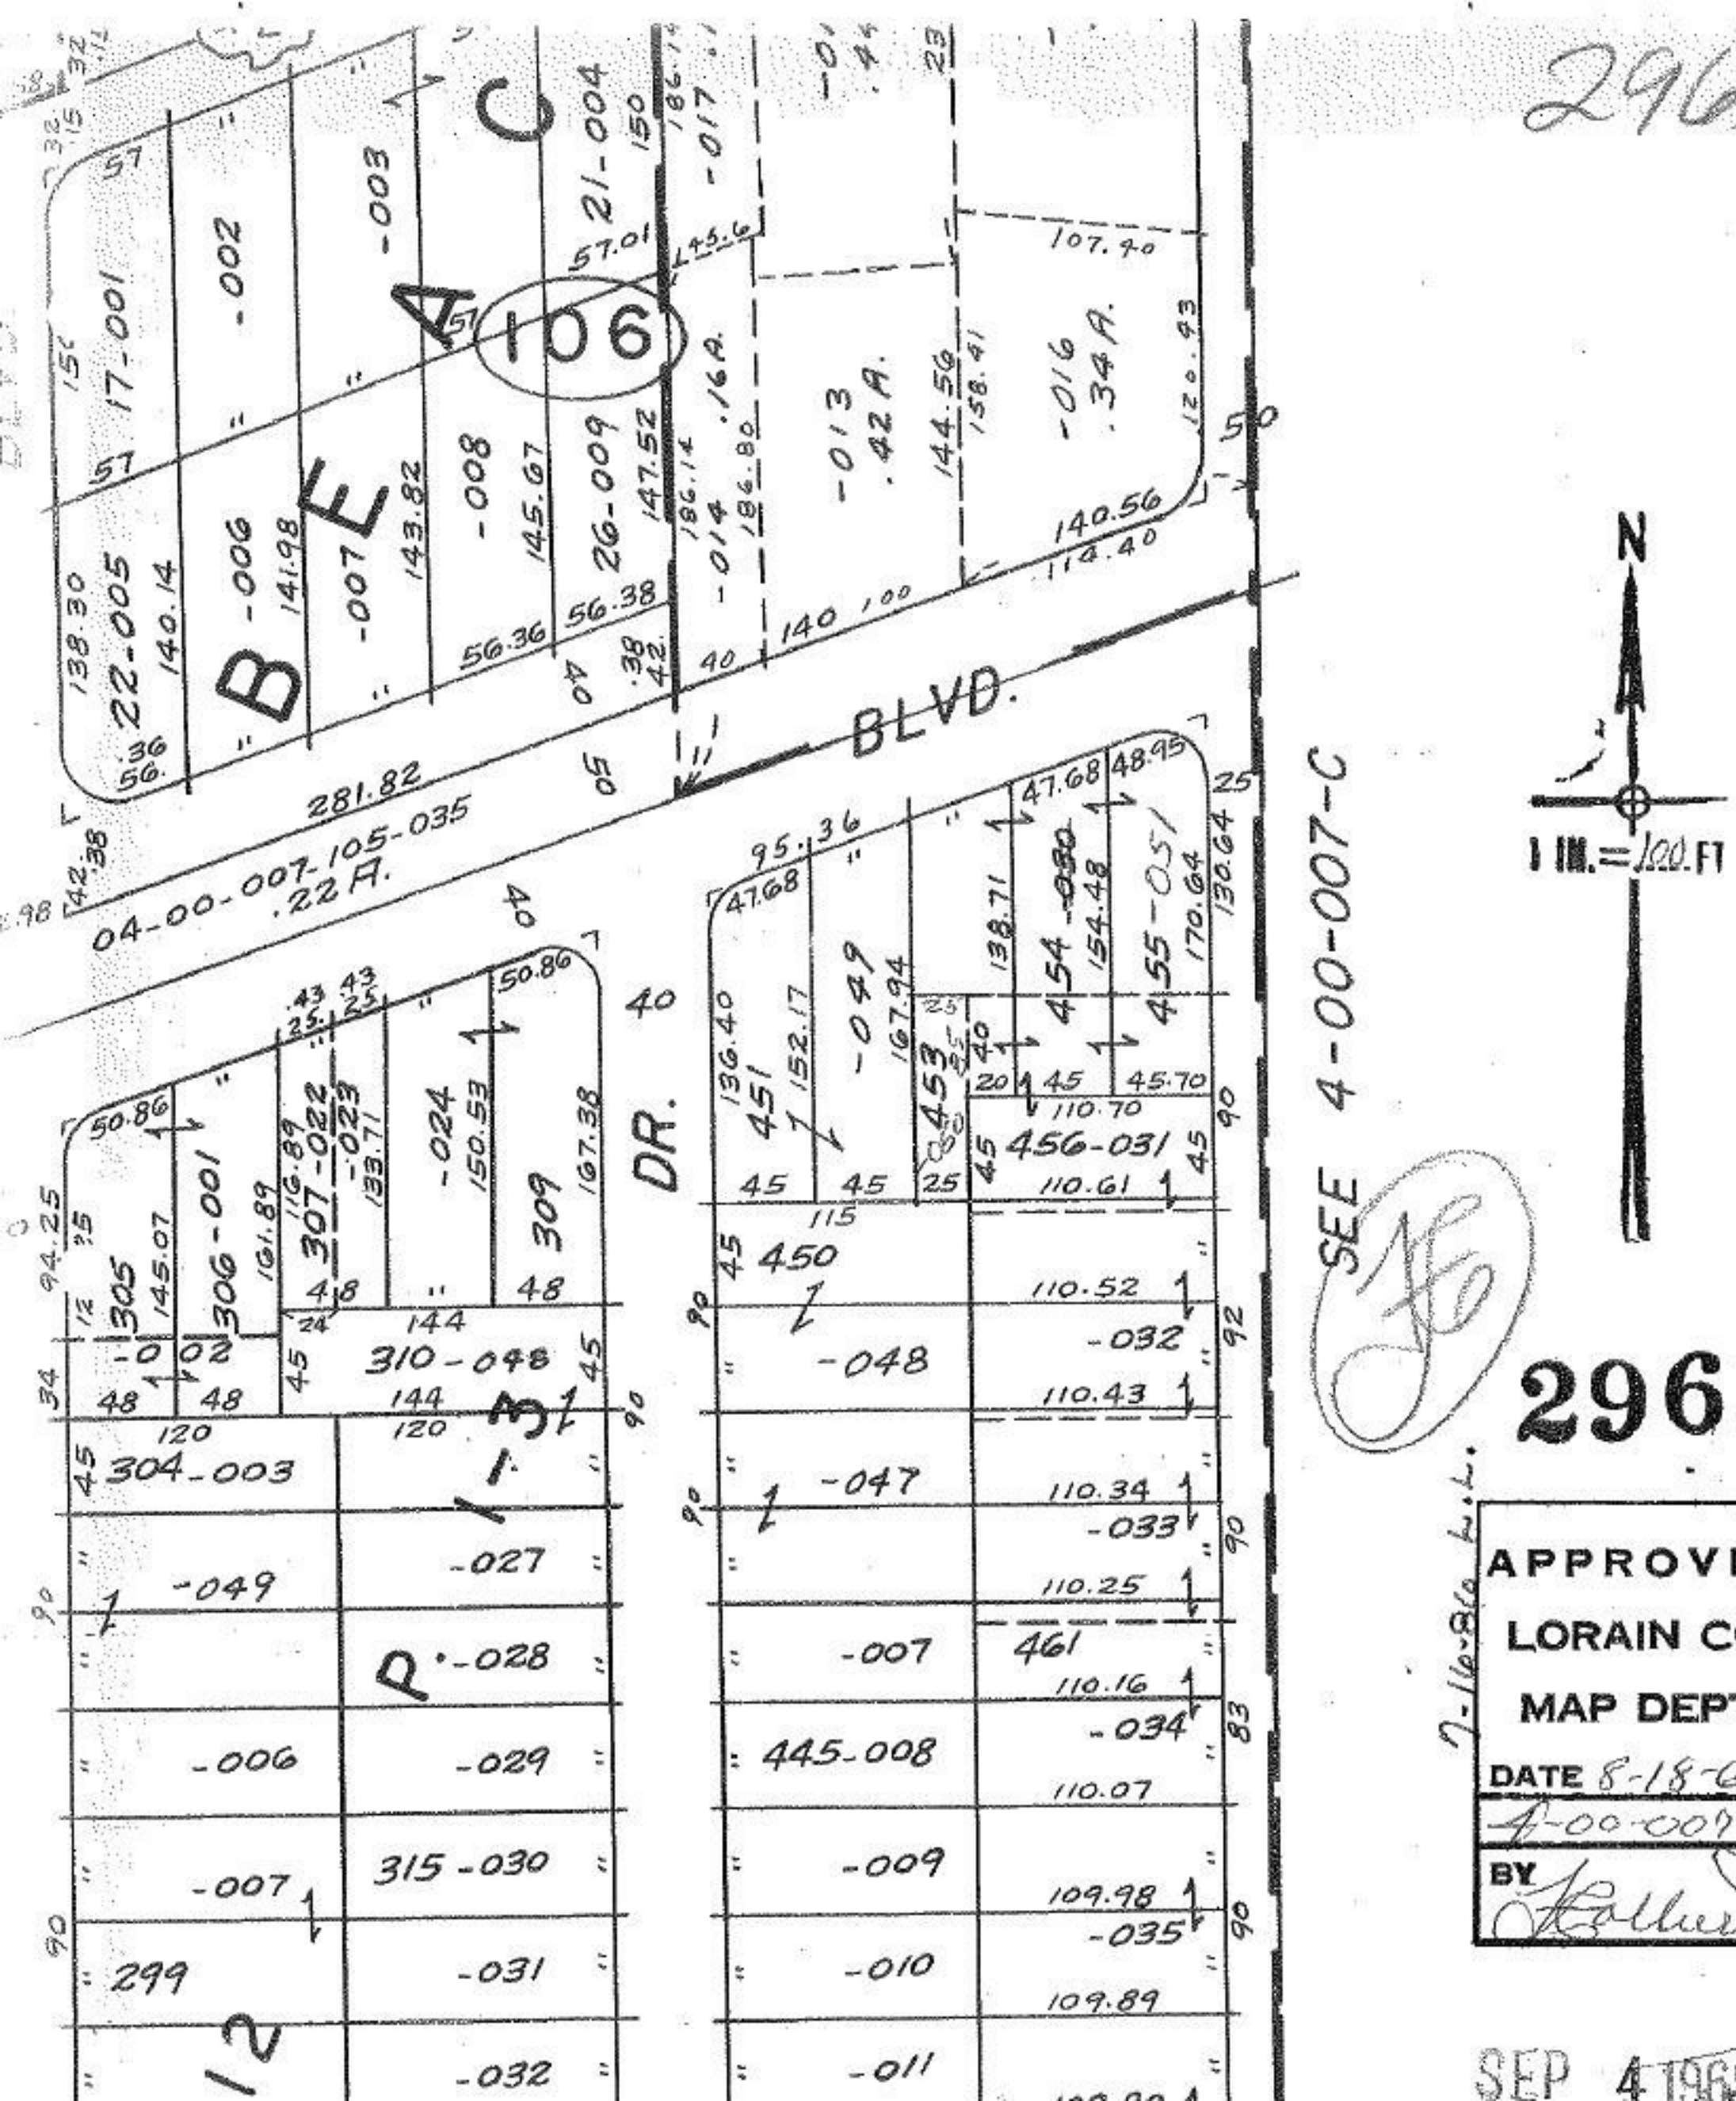

2963

APPROVED
LORAIN CO.
MAP DEPT.
DATE 8-18-69
4-00-007-B
BY

7-16-86 L.L.

SEP 4 1969