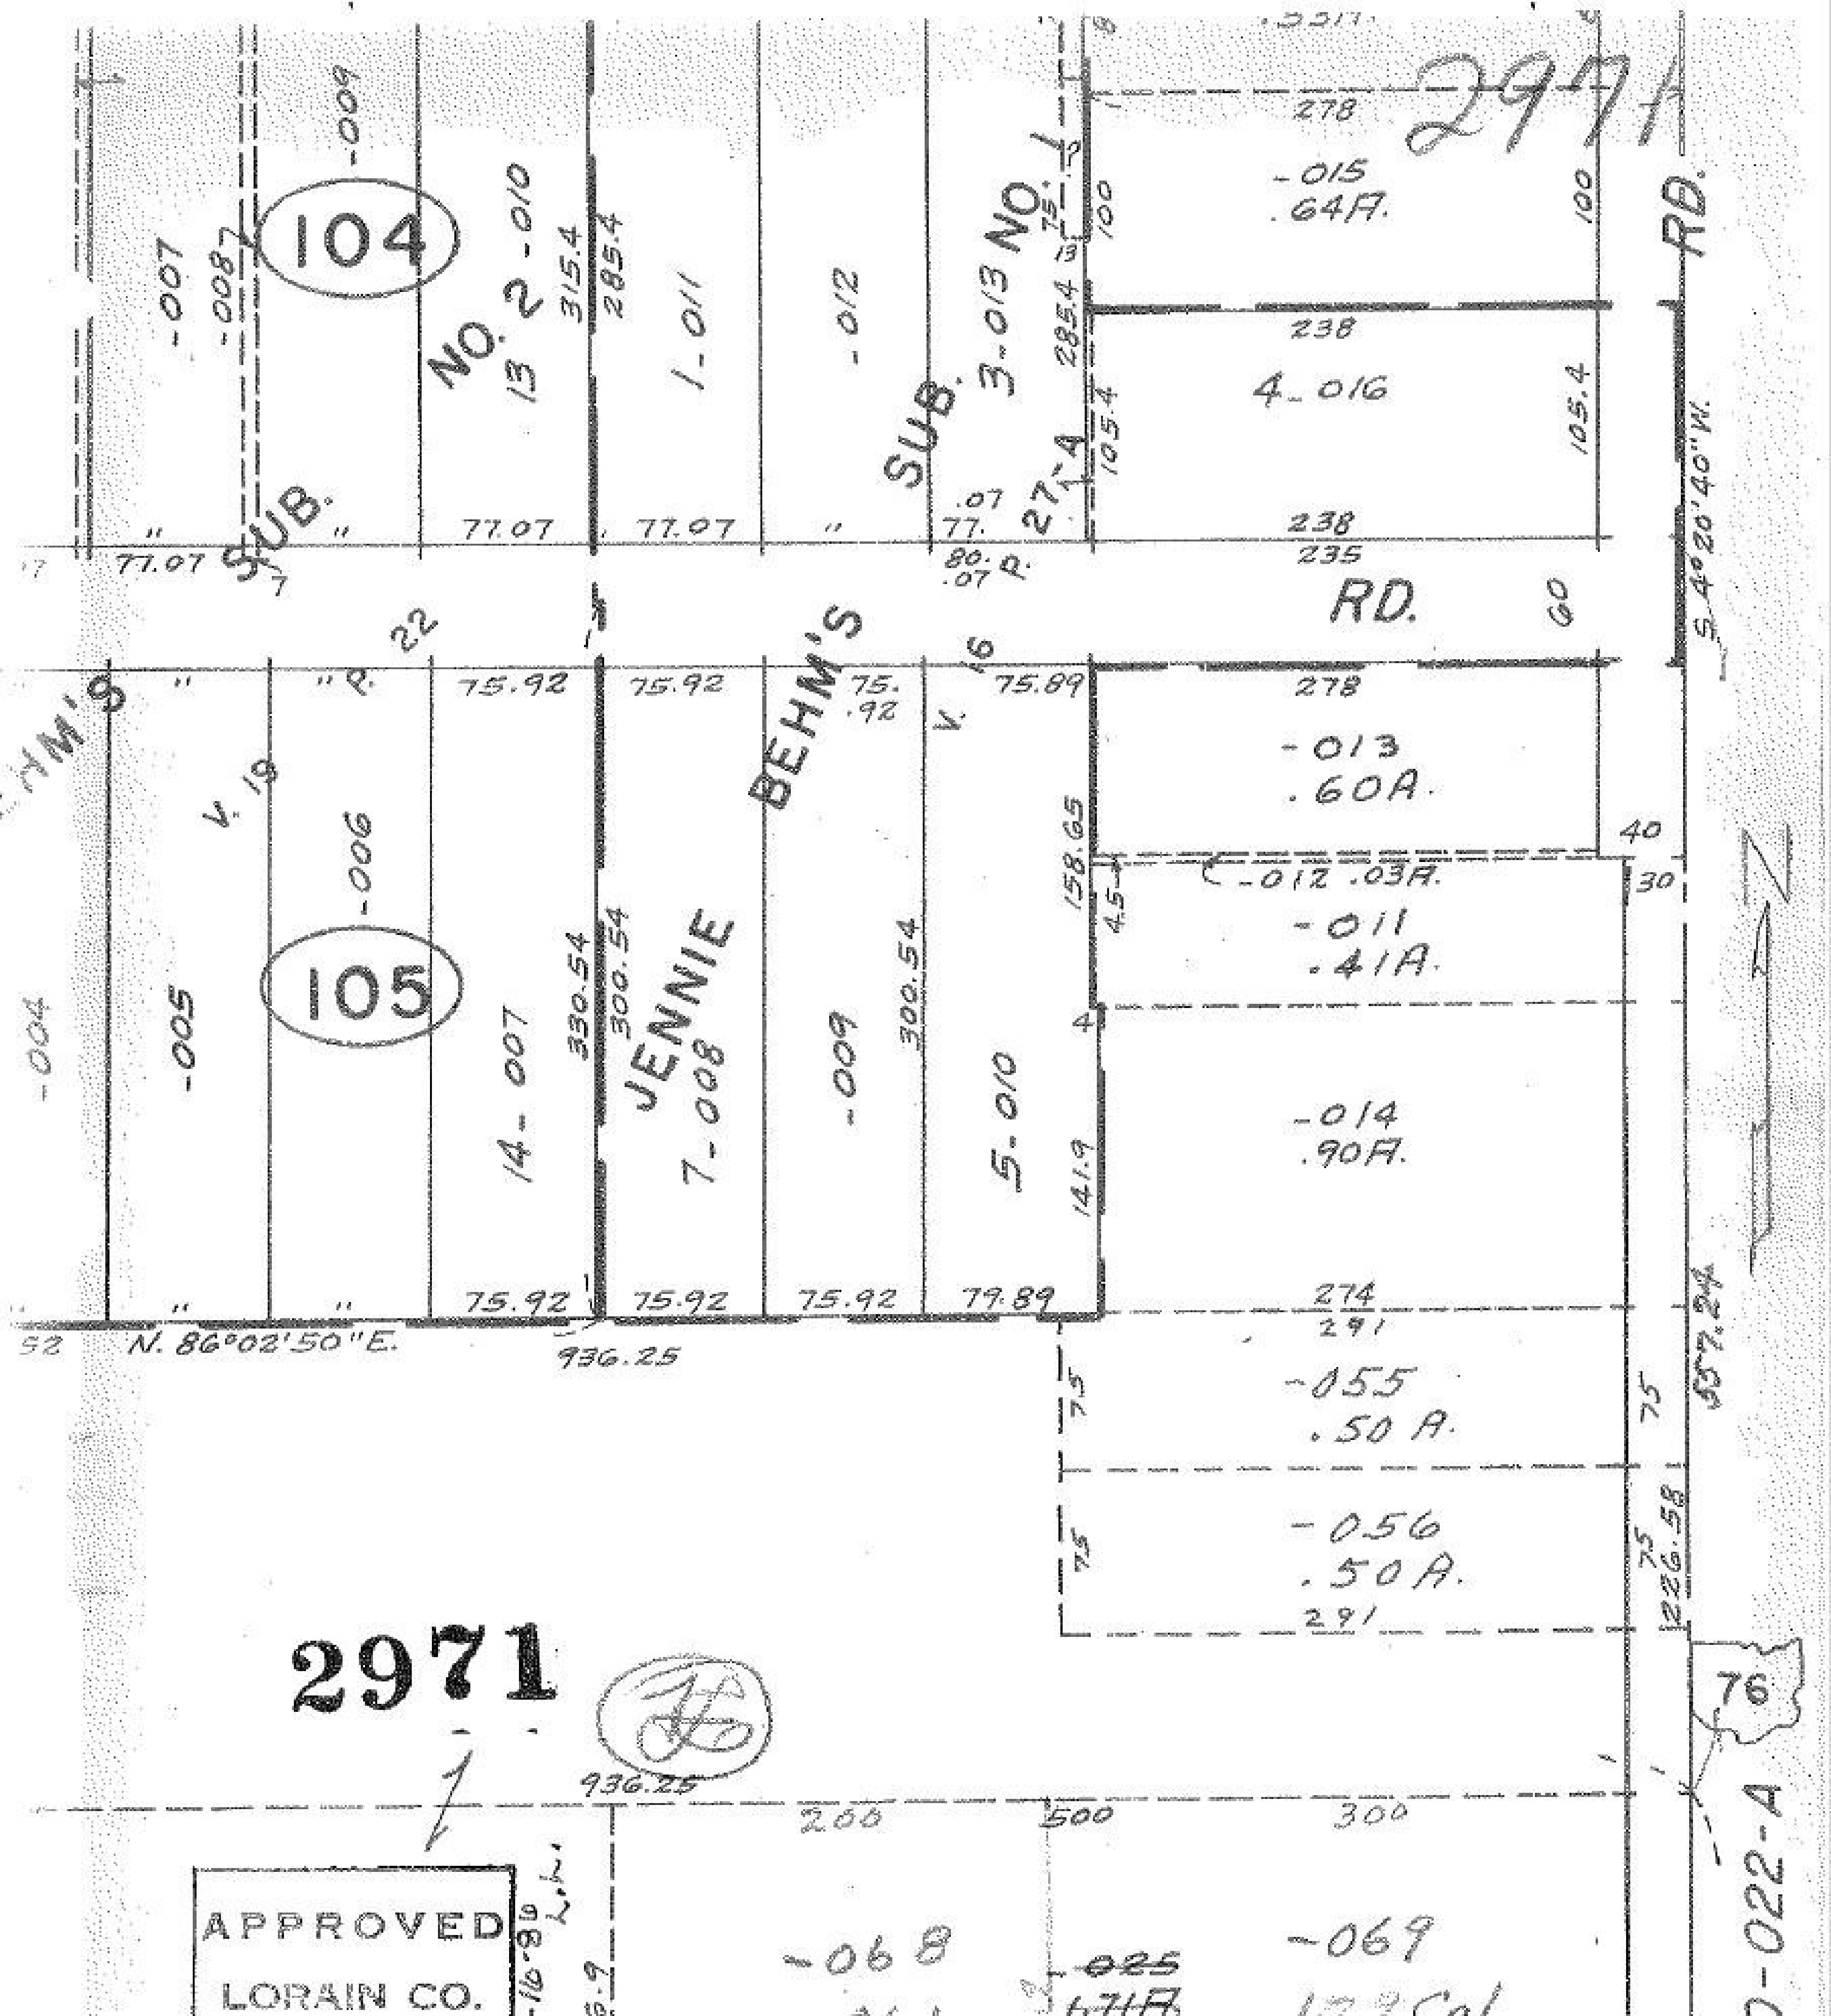

2971
104
105
SUB. NO. 2
BEHM'S SUB. NO. 1
BEHM'S
JENNIE
RD.
RD.
-007
-008
-009
-010
13
315.4
285.4
1-011
-012
3-013
27-A
-015
.64A.
278
100
238
4-016
105.4
77.07
235
60
S. 4°20'40" W.
75.92
75.89
-013
.60A.
158.65
40
30
-012 .03A.
-011
.41A.
-004
-005
-006
14-007
330.54
300.54
7-008
-009
5-010
141.9
-014
.90A.
79.89
274
291
N. 86°02'50" E.
936.25
-055
.50 A.
75
-056
.50 A.
226.58
557.24
76
200
500
300
-068
-069
APPROVED
LORAIN CO.
-022-A