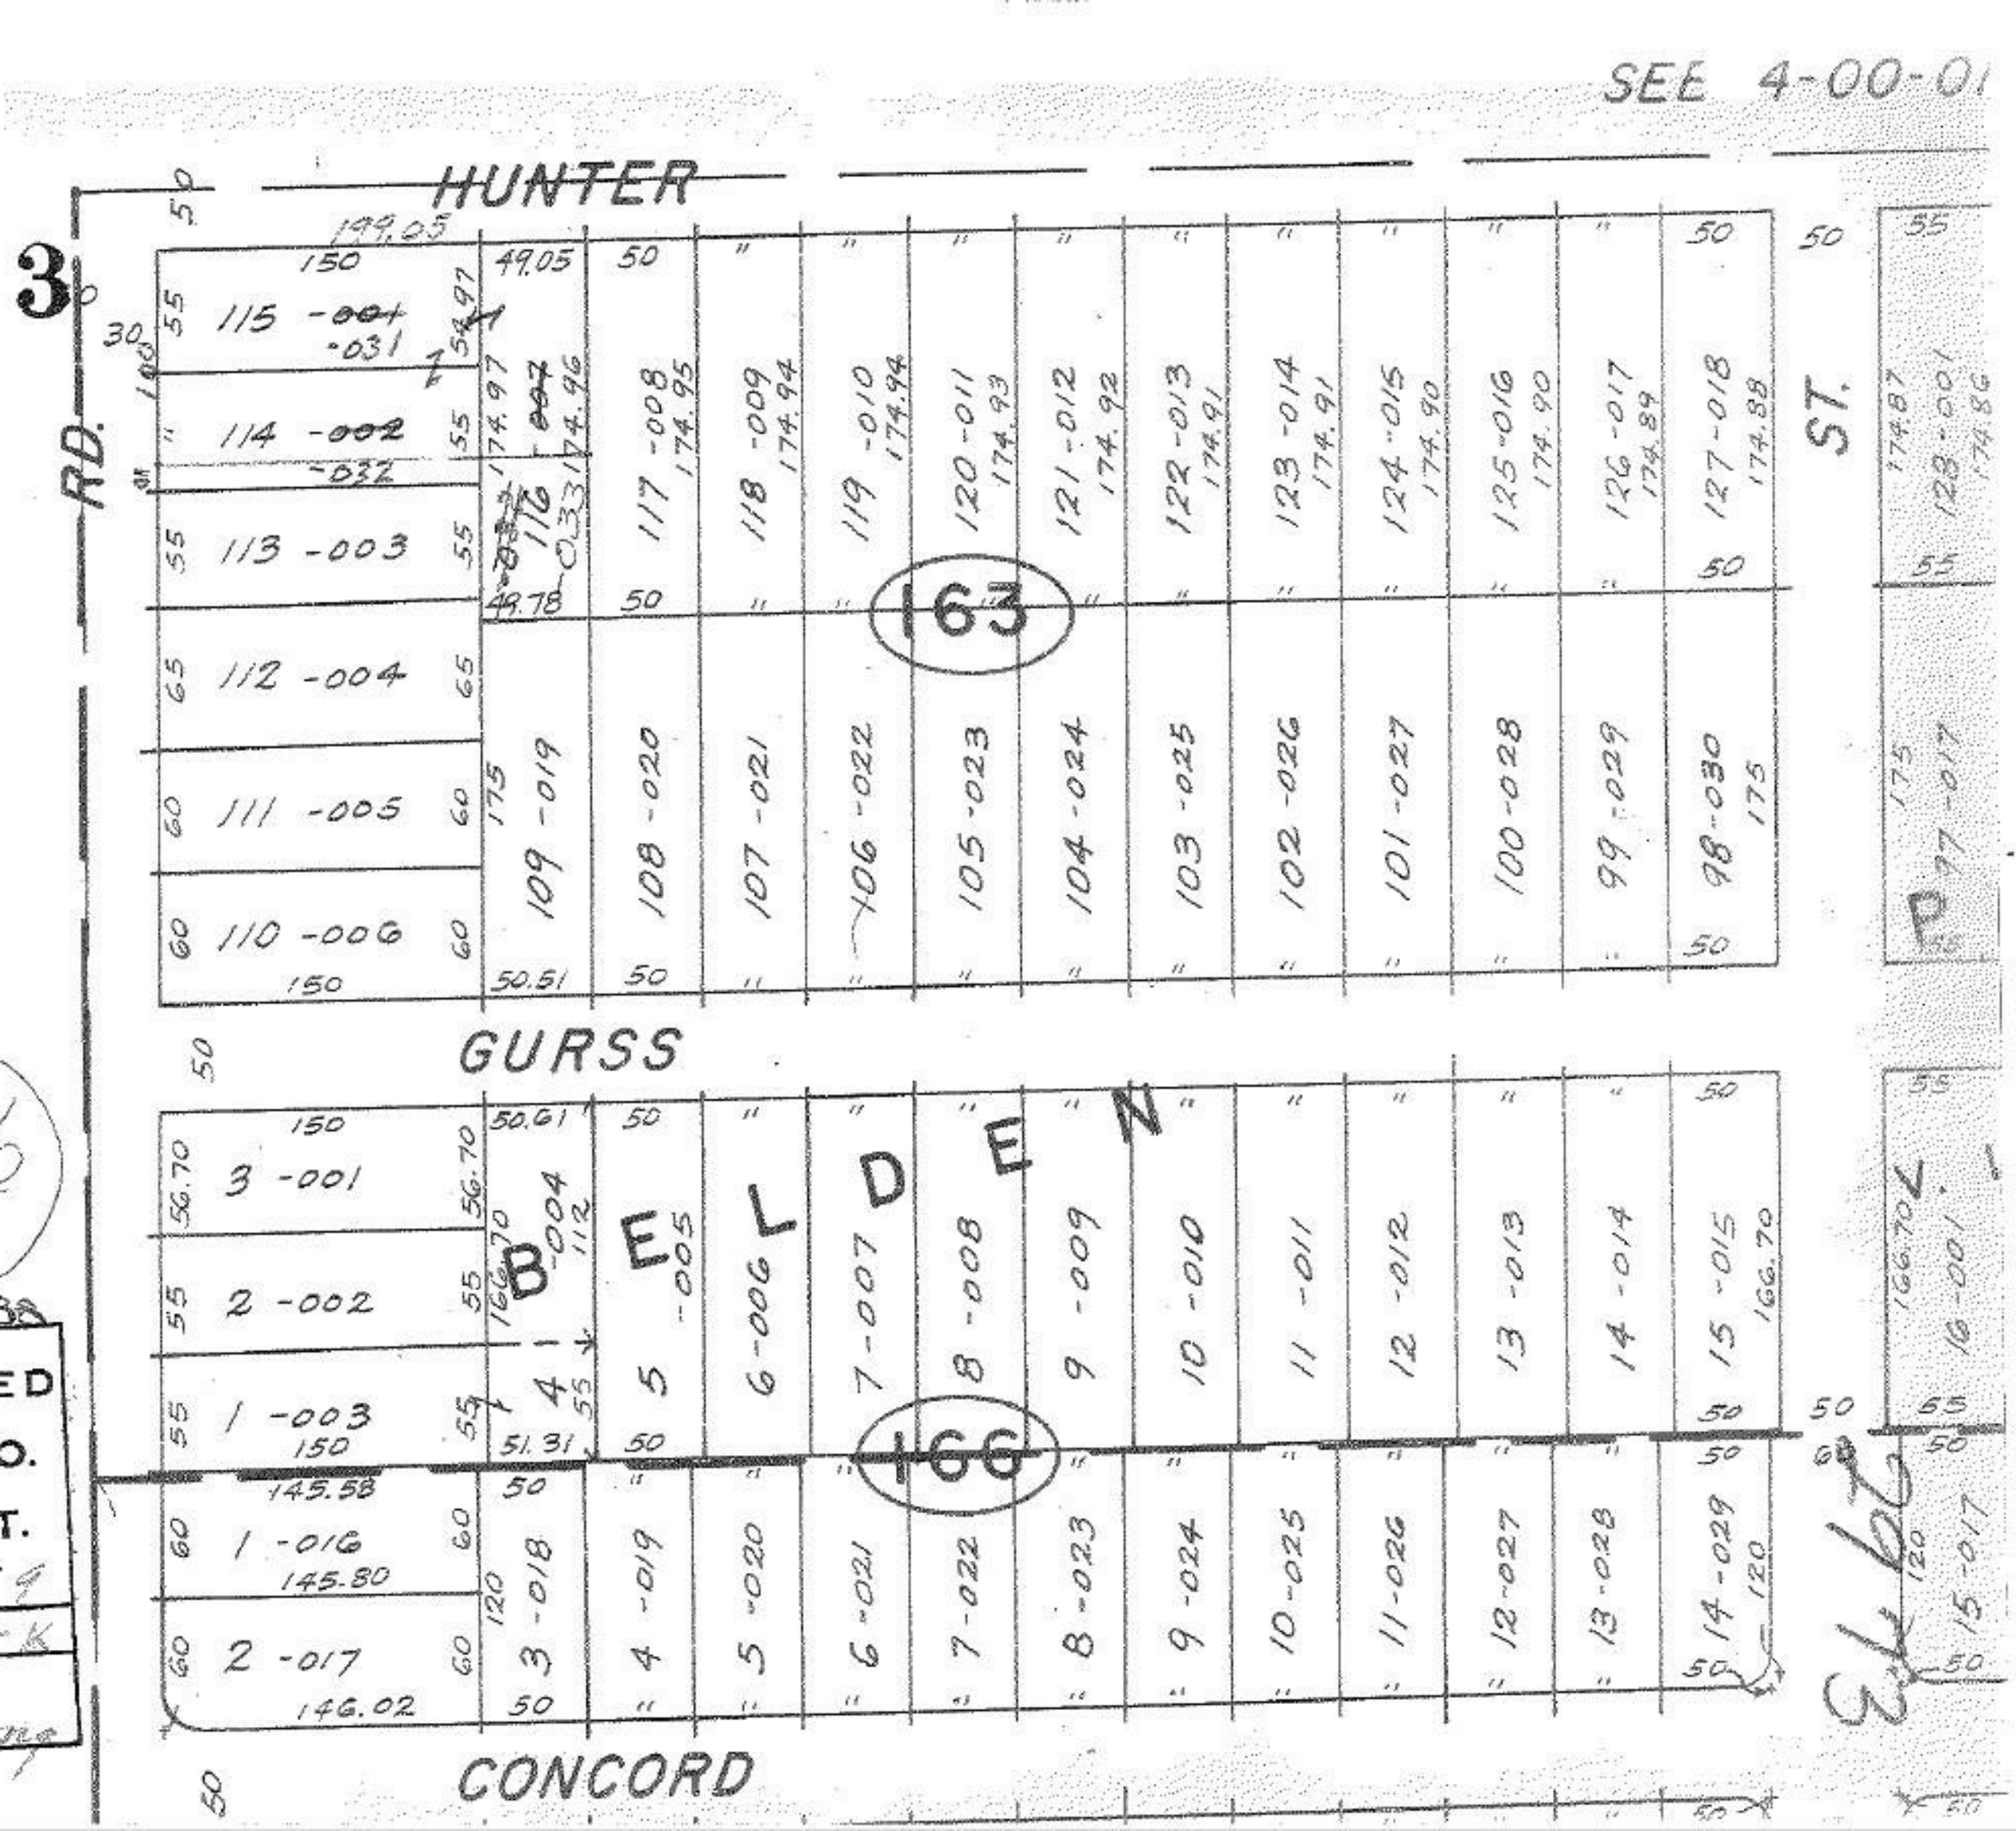
SEE 4-00-01
HUNTER
GURSS
CONCORD
RD.
ST.
BELDEN
163
166
3
115 -001 -031
114 -002 -032
113 -003
112 -004
111 -005
110 -006
109 -019
108 -020
107 -021
106 -022
105 -023
104 -024
103 -025
102 -026
101 -027
100 -028
99 -029
98 -030
127 -018
126 -017
125 -016
124 -015
123 -014
122 -013
121 -012
120 -011
119 -010
118 -009
117 -008
116 -033
3 -001
2 -002
1 -003
1 -016
2 -017
4 -004
5 -005
6 -006
7 -007
8 -008
9 -009
10 -010
11 -011
12 -012
13 -013
14 -014
15 -015
3 -018
4 -019
5 -020
6 -021
7 -022
8 -023
9 -024
10 -025
11 -026
12 -027
13 -028
14 -029
15 -017
16 -001
199.05
150
49.05
49.78
50.51
50.61
51.31
145.58
145.80
146.02
174.97
174.96
174.95
174.94
174.93
174.92
174.91
174.90
174.89
174.88
174.87
174.86
166.70
120
175
50
55
60
30
100