H 2981

47
19
63
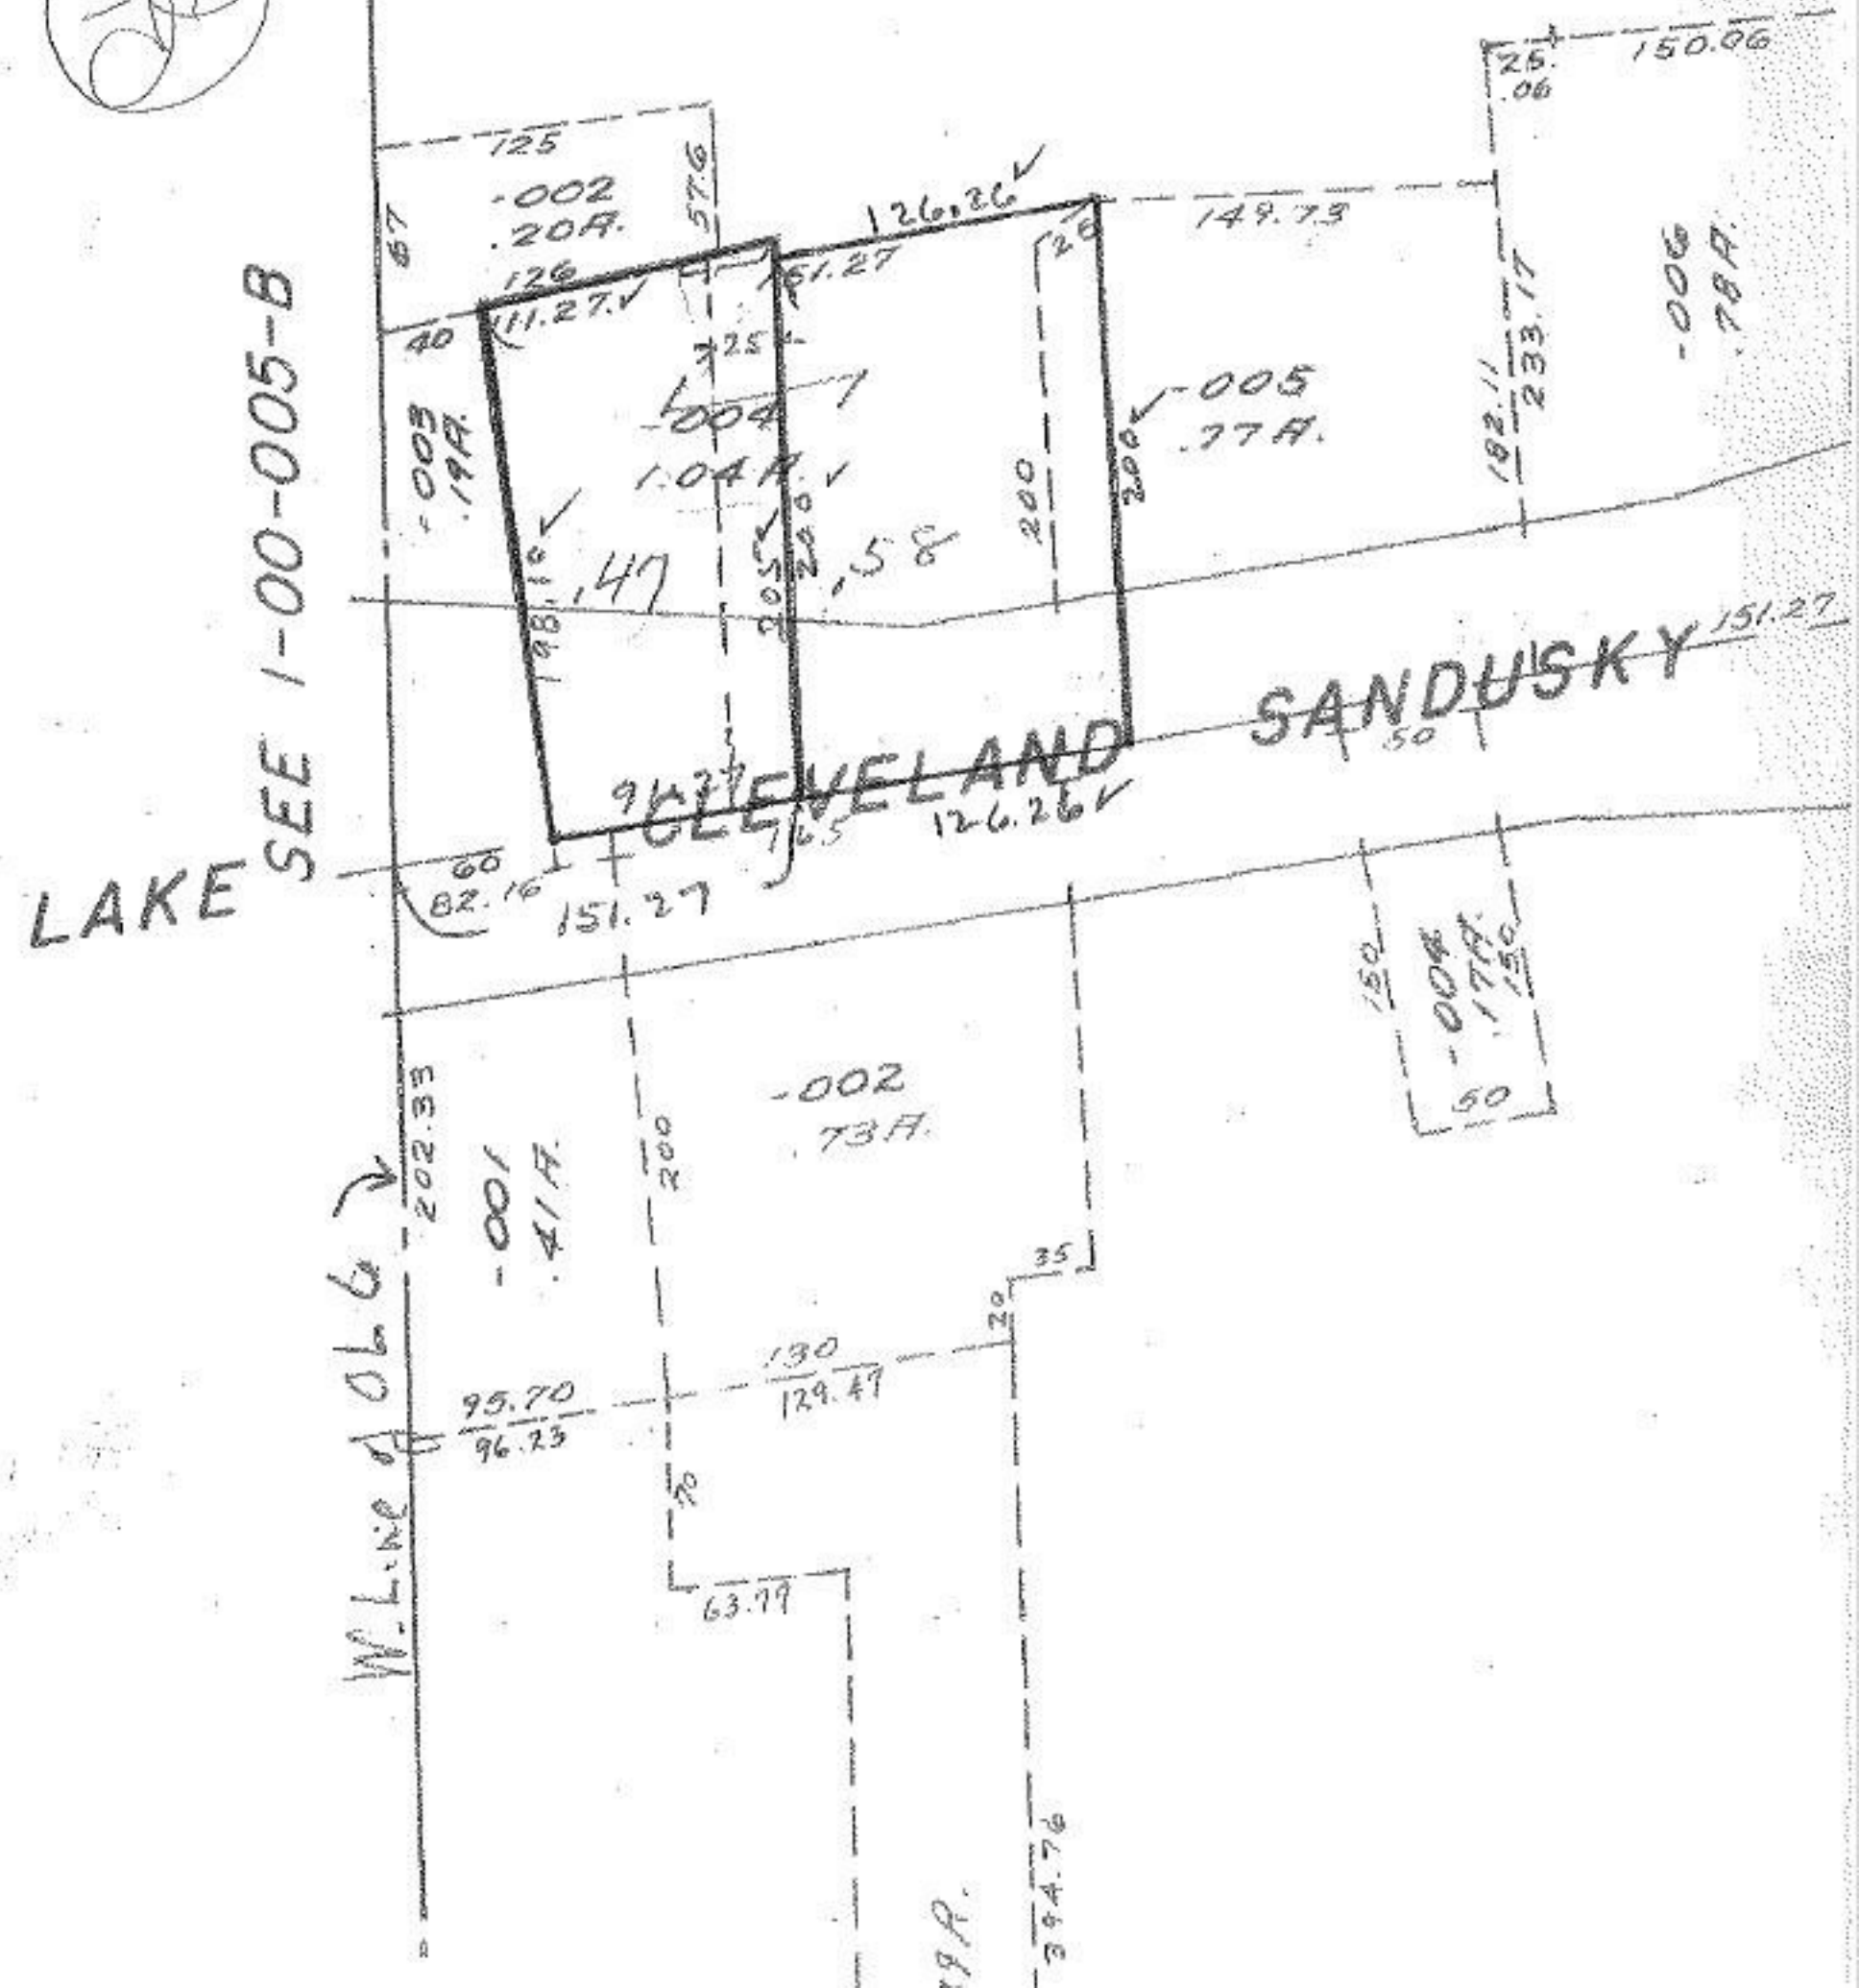
11 2981 -026
25.96