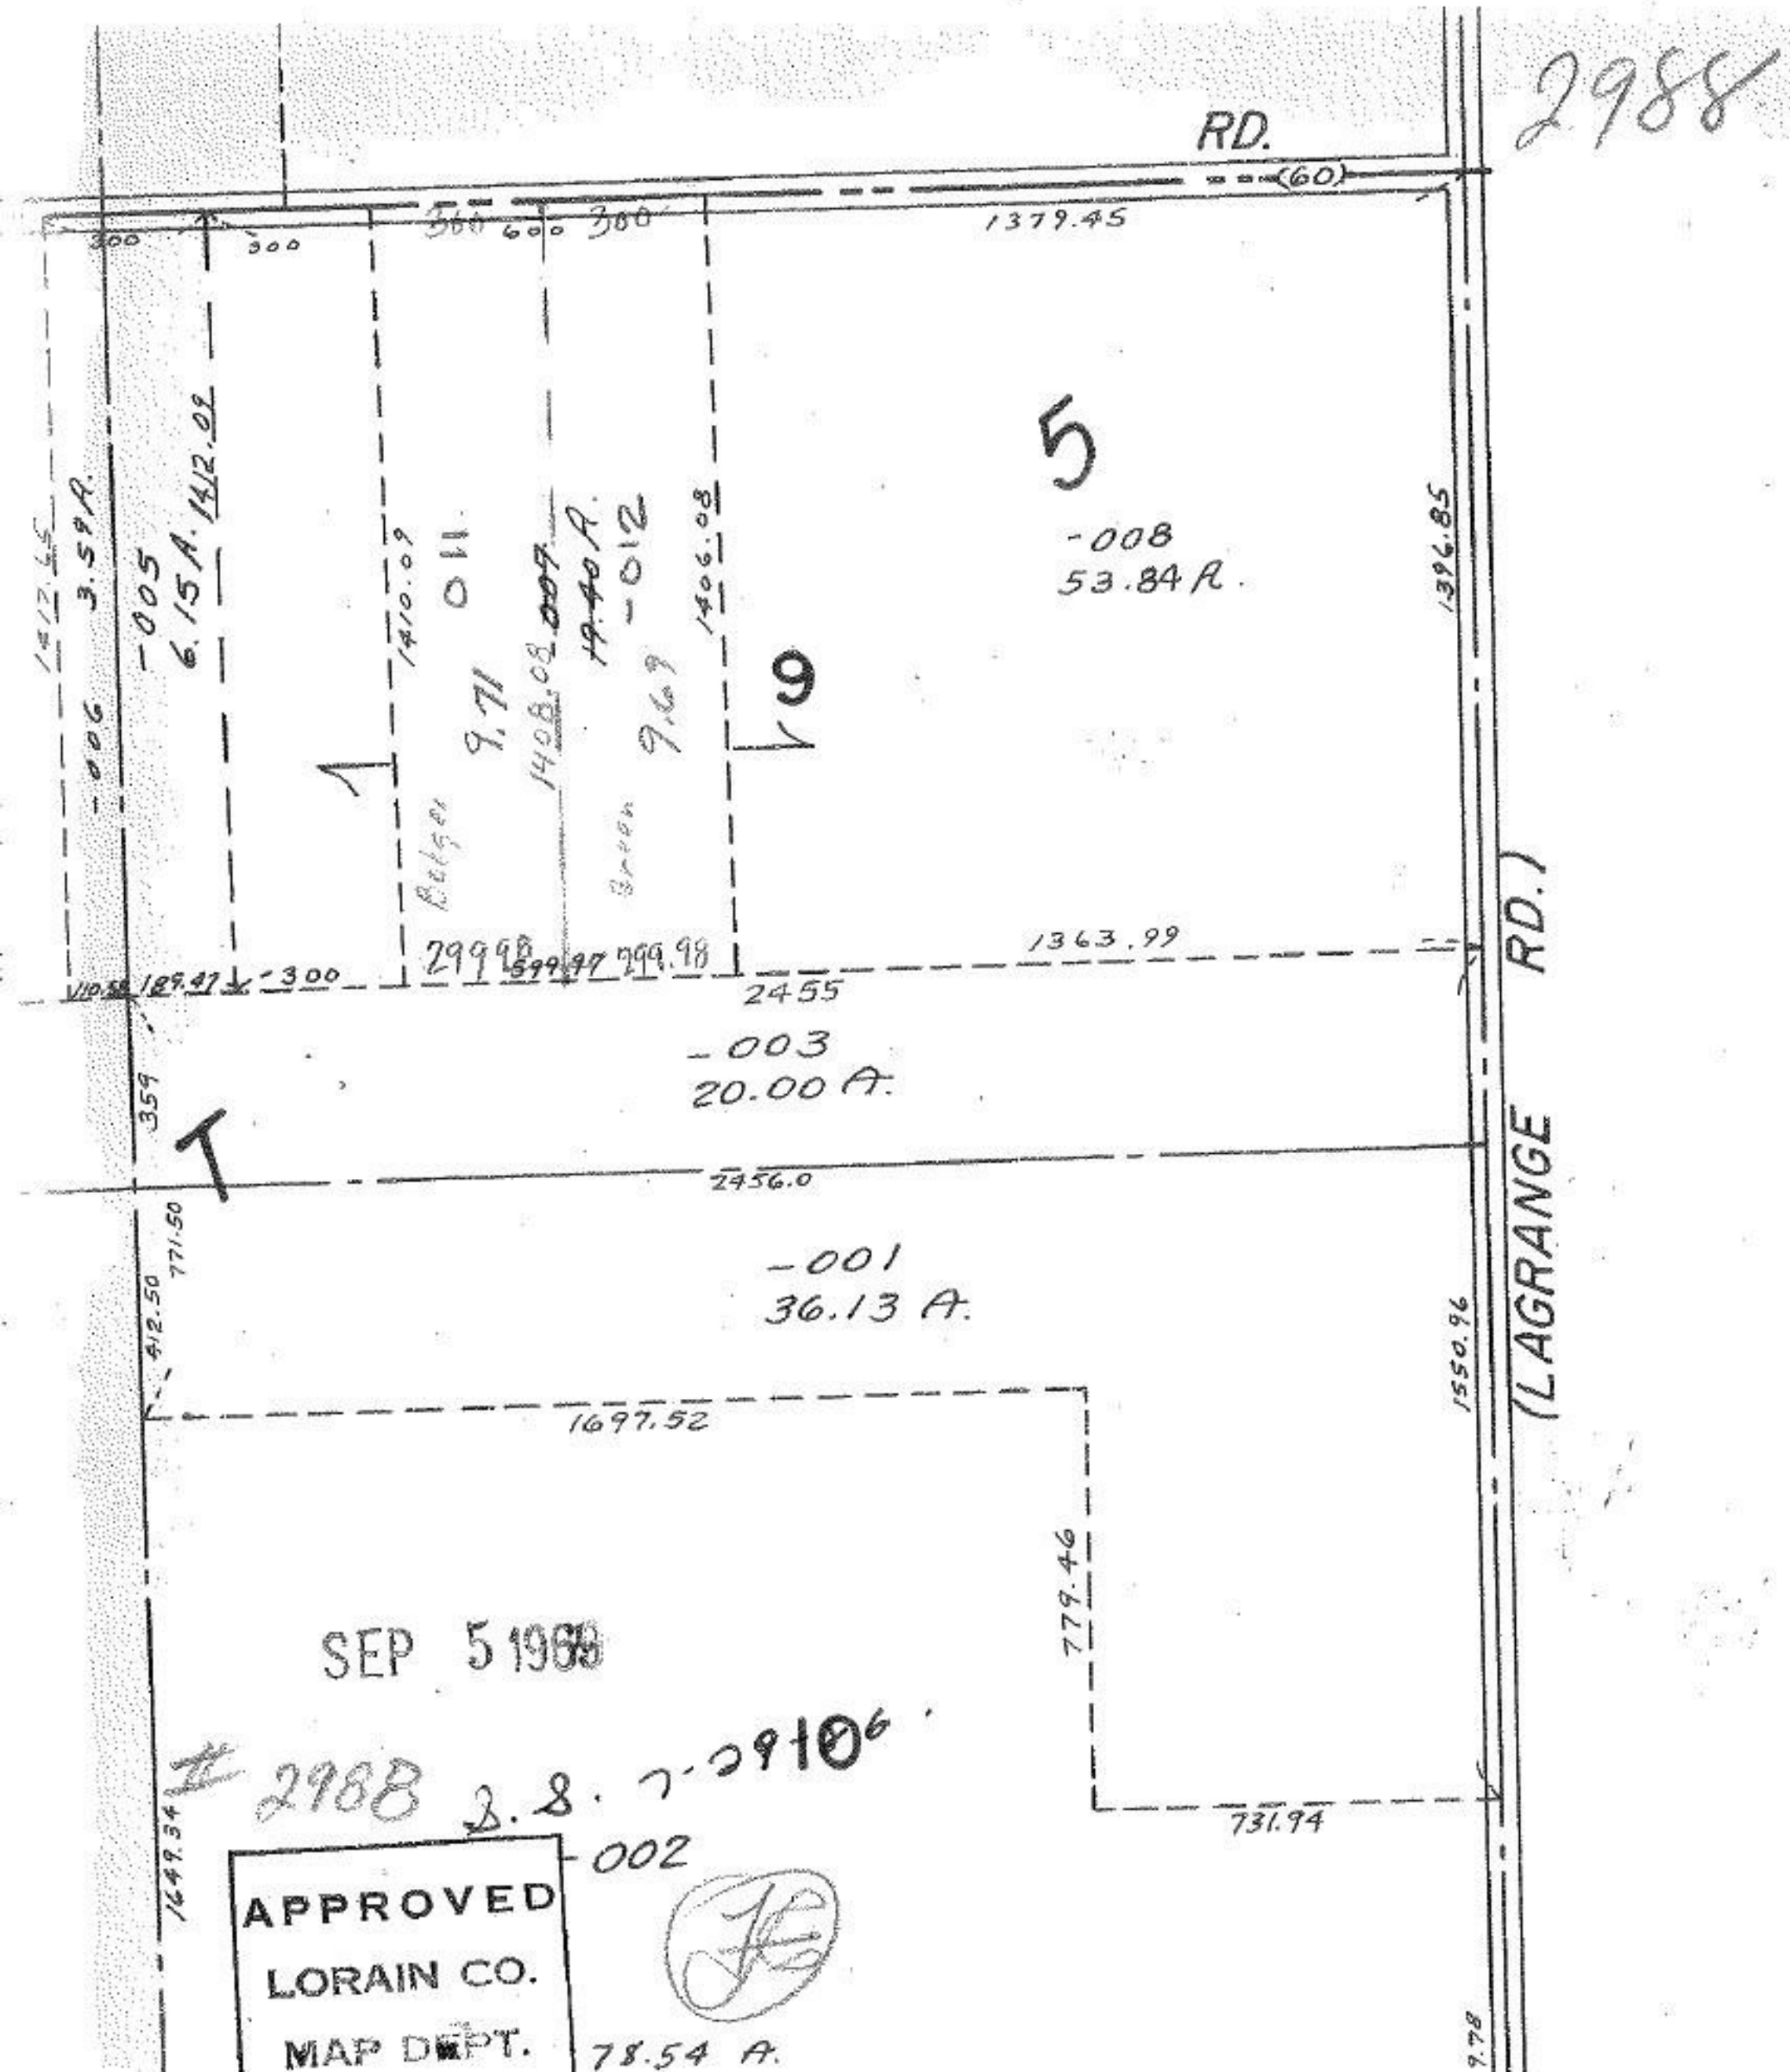

SEP 5 1968

2988 S.S. 7-29-06

APPROVED
LORAIN CO.
MAP DEPT.