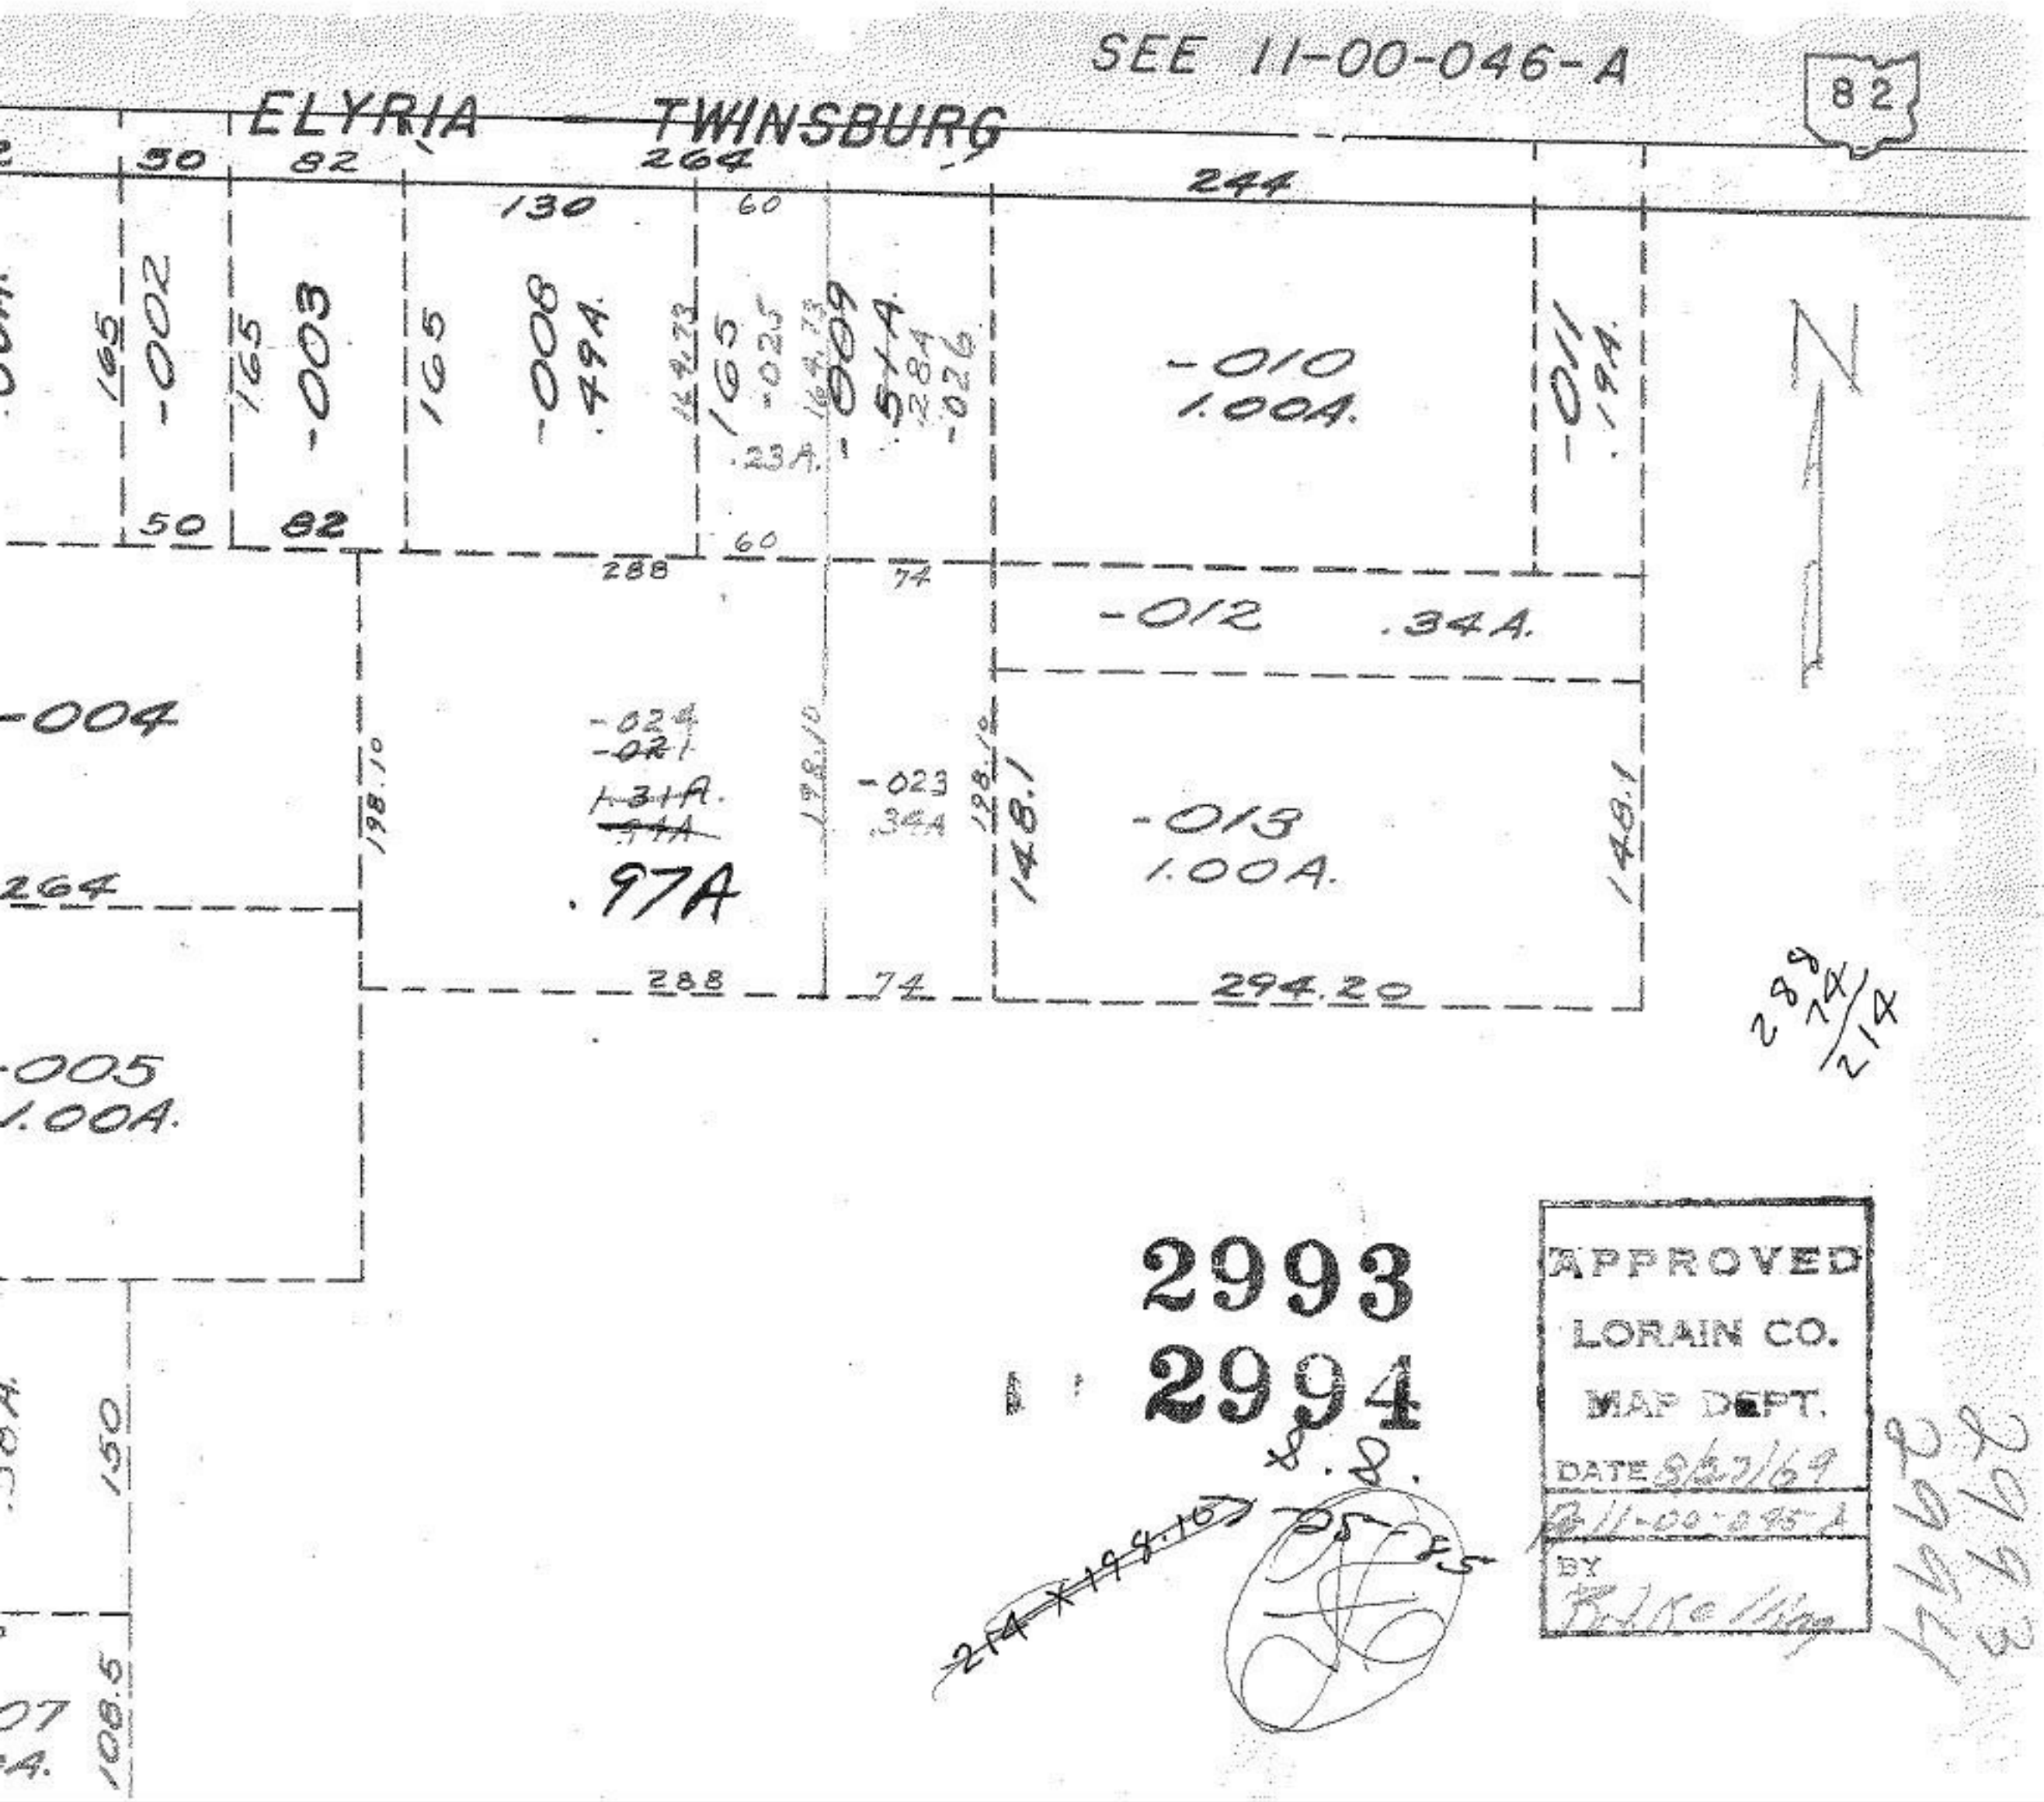
SEE 11-00-046-A
82
ELYRIA — TWINSBURG
50
82
264
130
60
244
165
-002
165
-003
165
-008
.49A.
164.73
165
-025
.23A.
164.73
-009
.51A.
.28A
-026
-010
1.00A.
-011
.19A.
50
82
60
288
74
-012
.34A.
-004
-024
-021
1.31A.
.97A
198.10
198.10
-023
.34A
198.10
148.1
-013
1.00A.
148.1
264
288
74
294.20
-005
1.00A.
150
108.5
2993
2994
APPROVED
LORAIN CO.
MAP DEPT.
DATE 8/27/69
BY