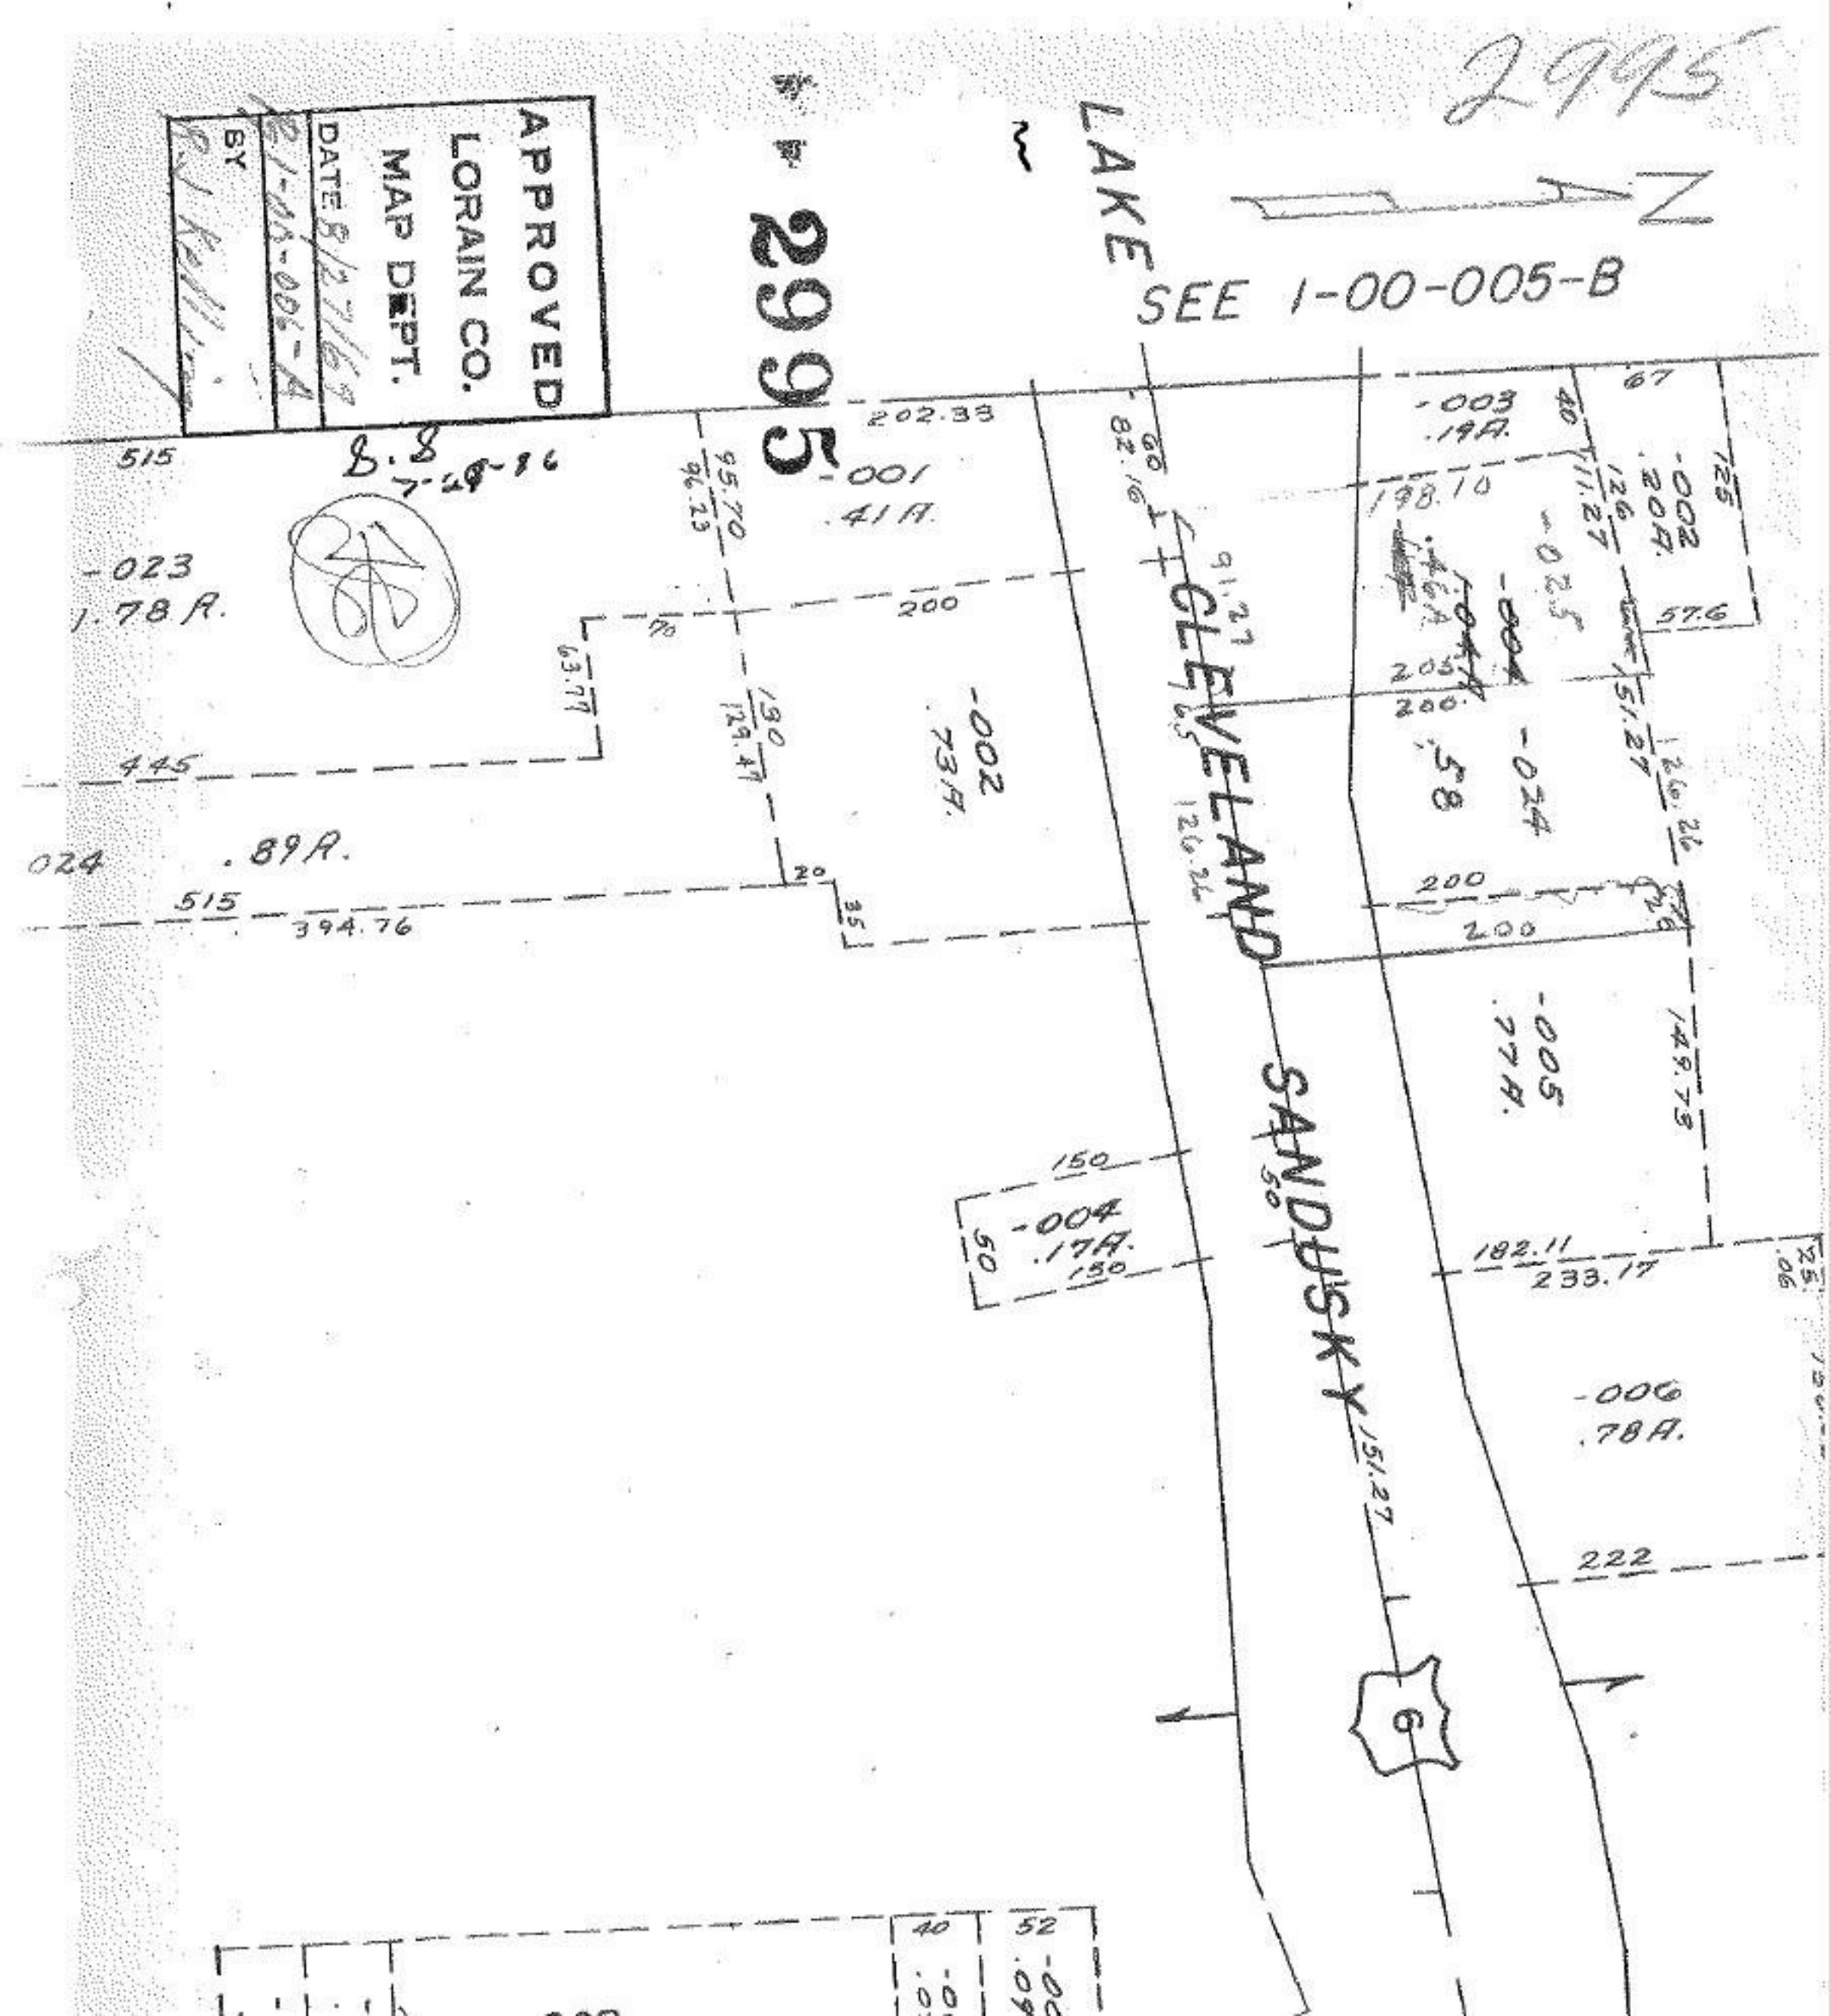
2995
APPROVED
LORAIN CO.
MAP DEPT.
DATE 8/27/69
BY
2995
LAKE
SEE 1-00-005-B
CLEVELAND
SANDUSKY
-003
.19A.
-002
.20A.
-001
.41A.
-023
1.78A.
-002
.73A.
-024
.58
-005
.77A.
-004
.17A.
-006
.78A.
202.33
198.10
200
445
515
394.76
182.11
233.17
222
151.27
149.73
57.6
6