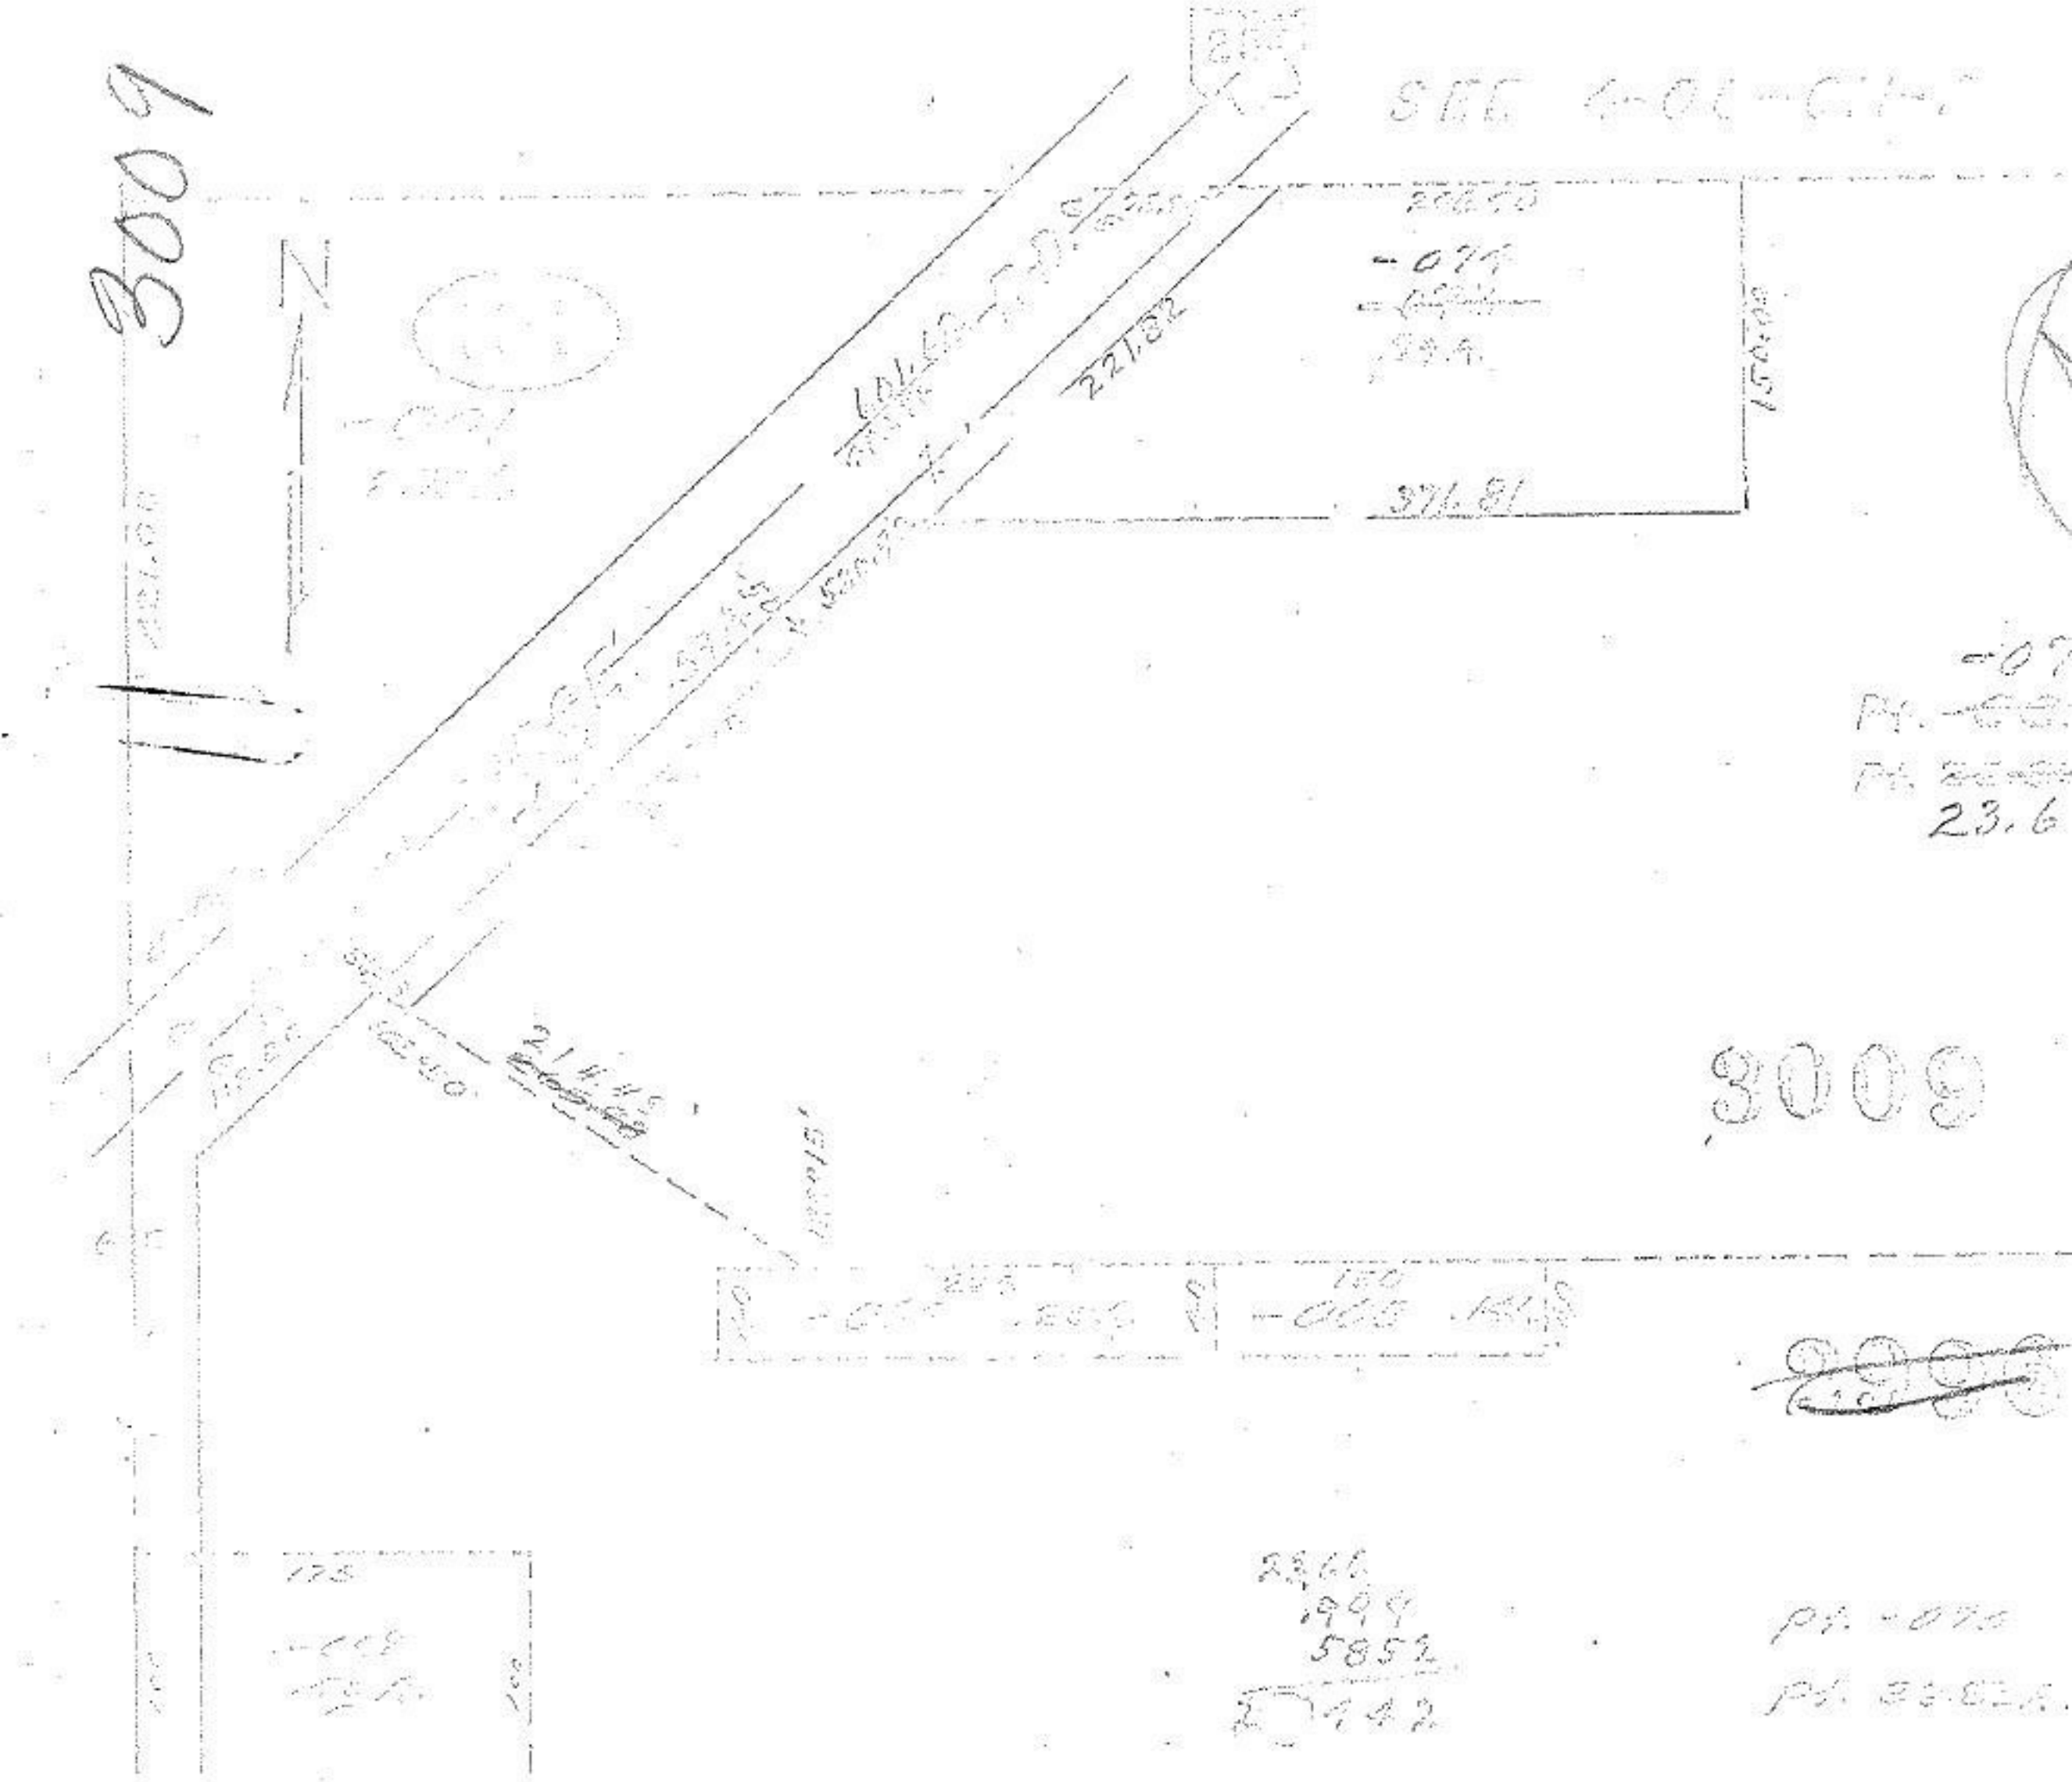
3009
N
221.82
371.81
150.00
23.6
3009
2366
.999
5852
142