


18-00-027A

3013

18-00-027B

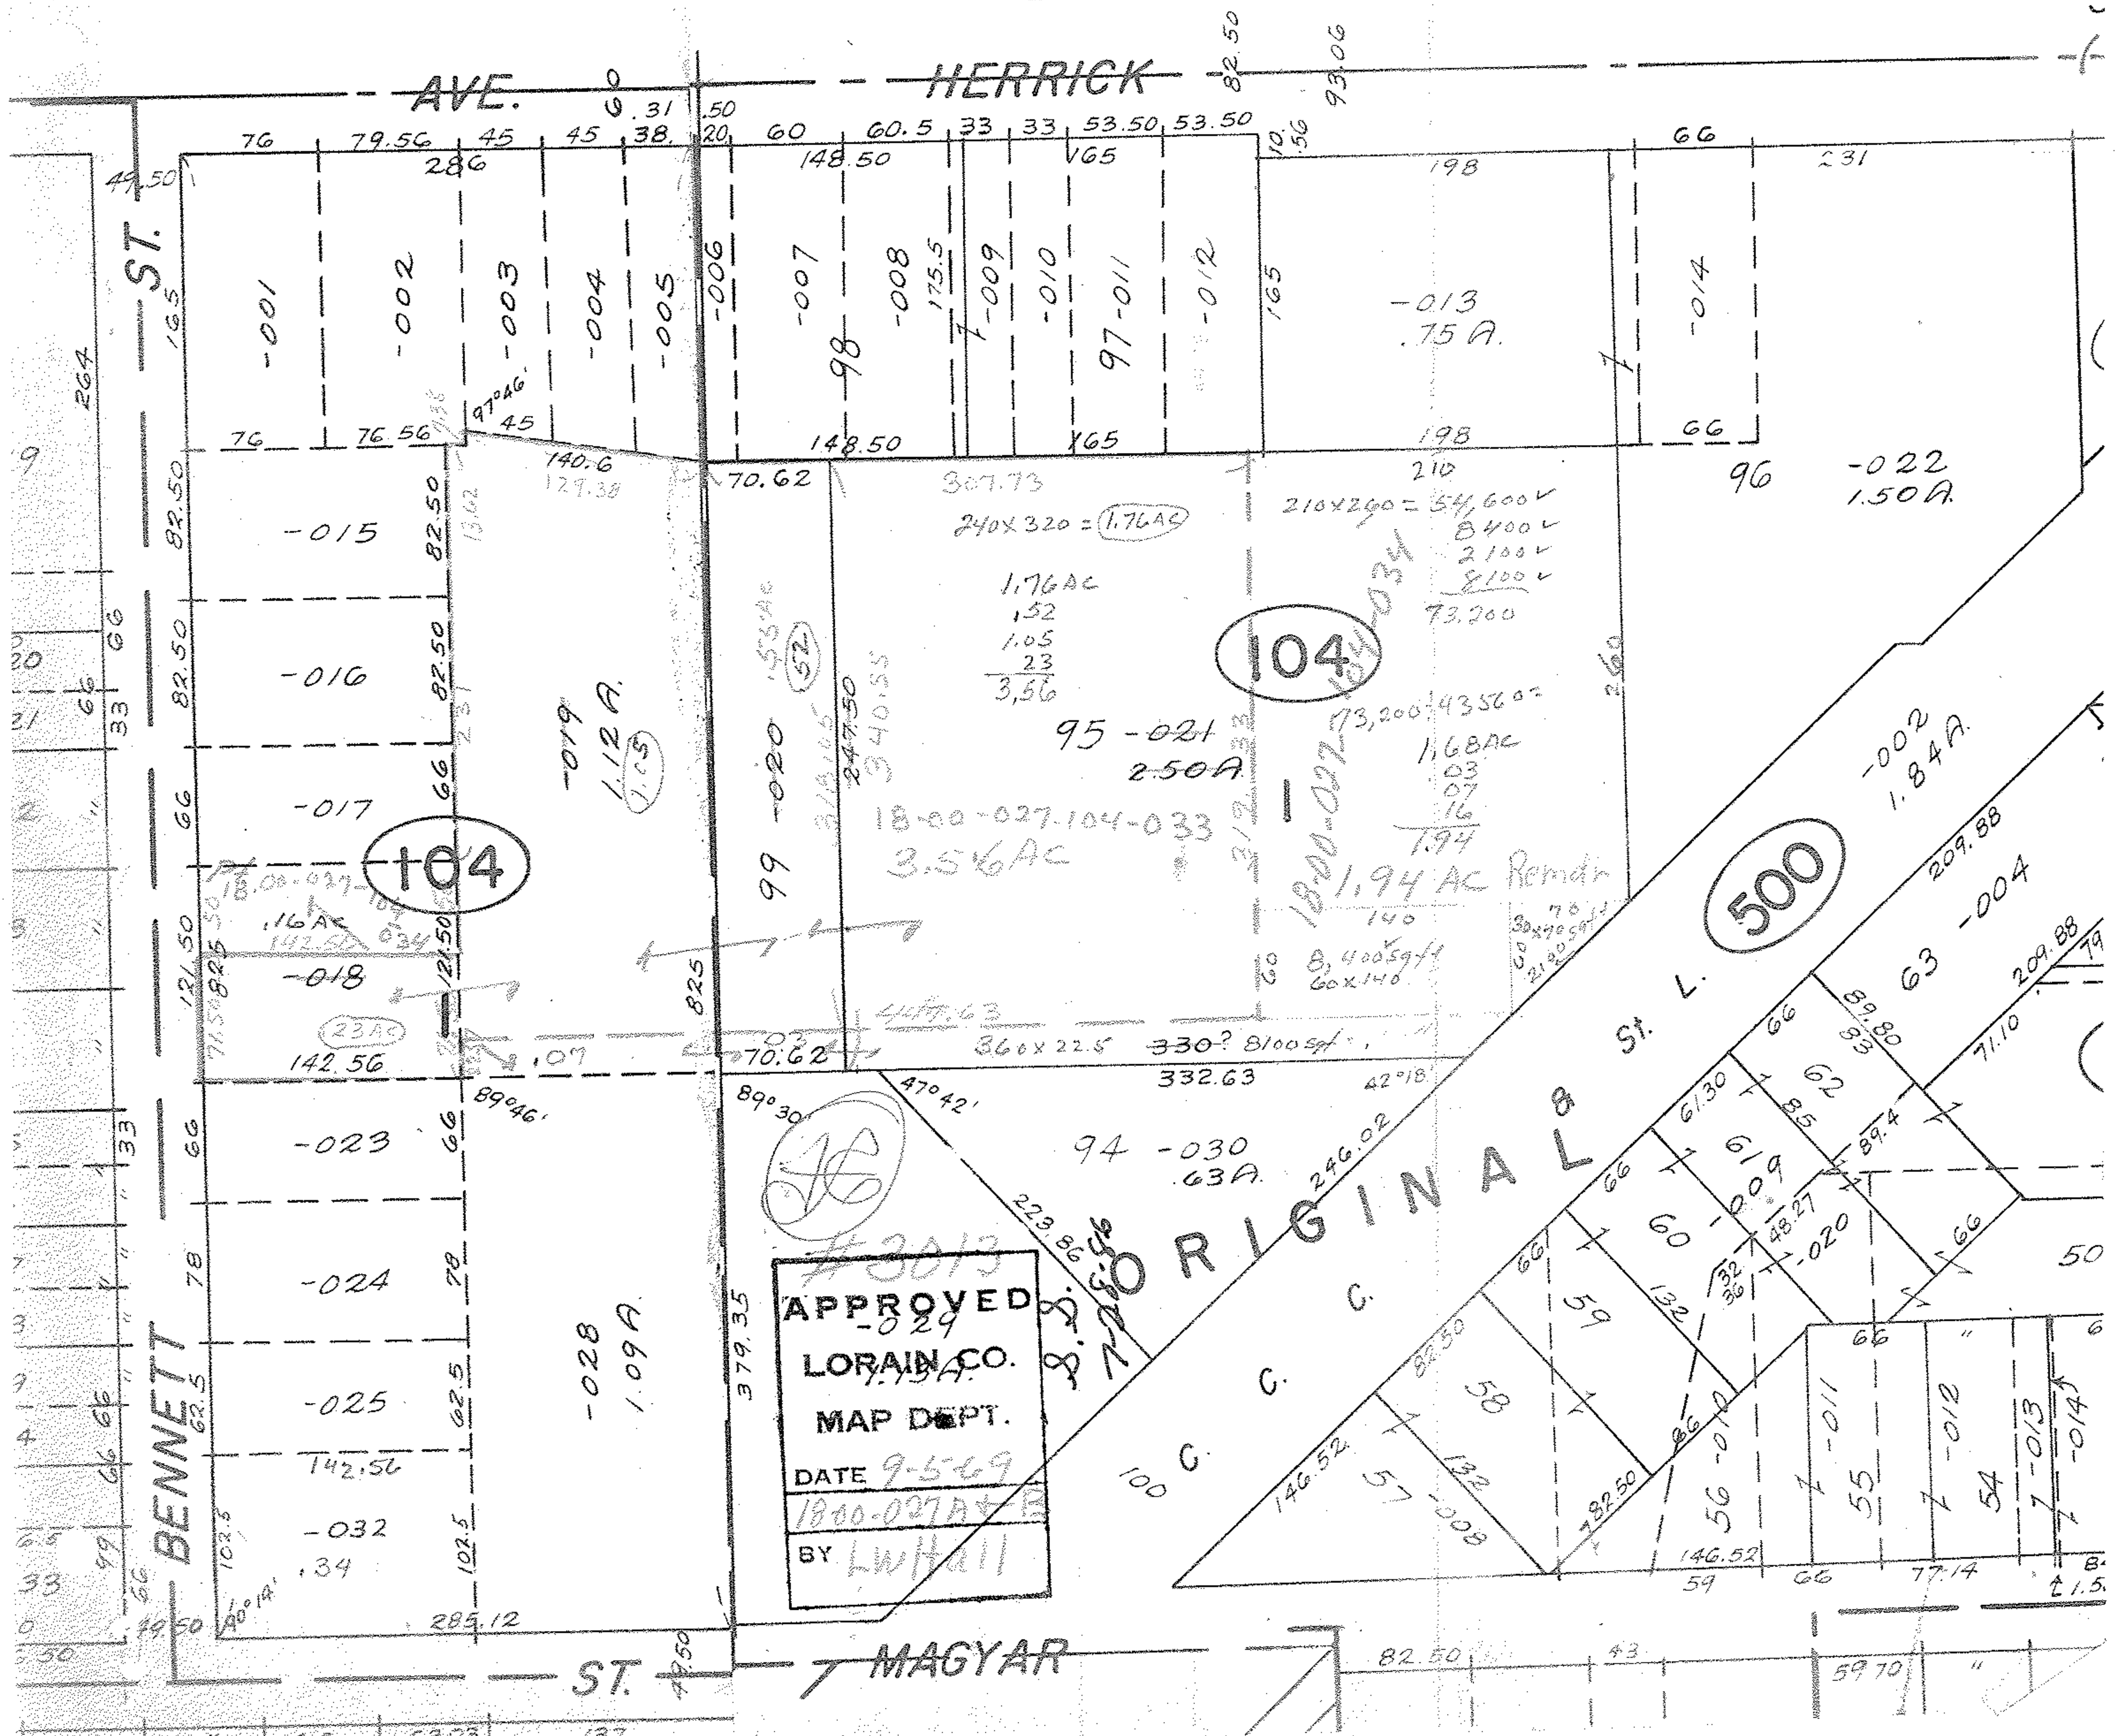

#3013
APPROVED
 -029
LORAIN CO.
 MAP DEPT.
 DATE 9-5-69
 18-00-027A
 BY LWH/11

ORIGINAL

