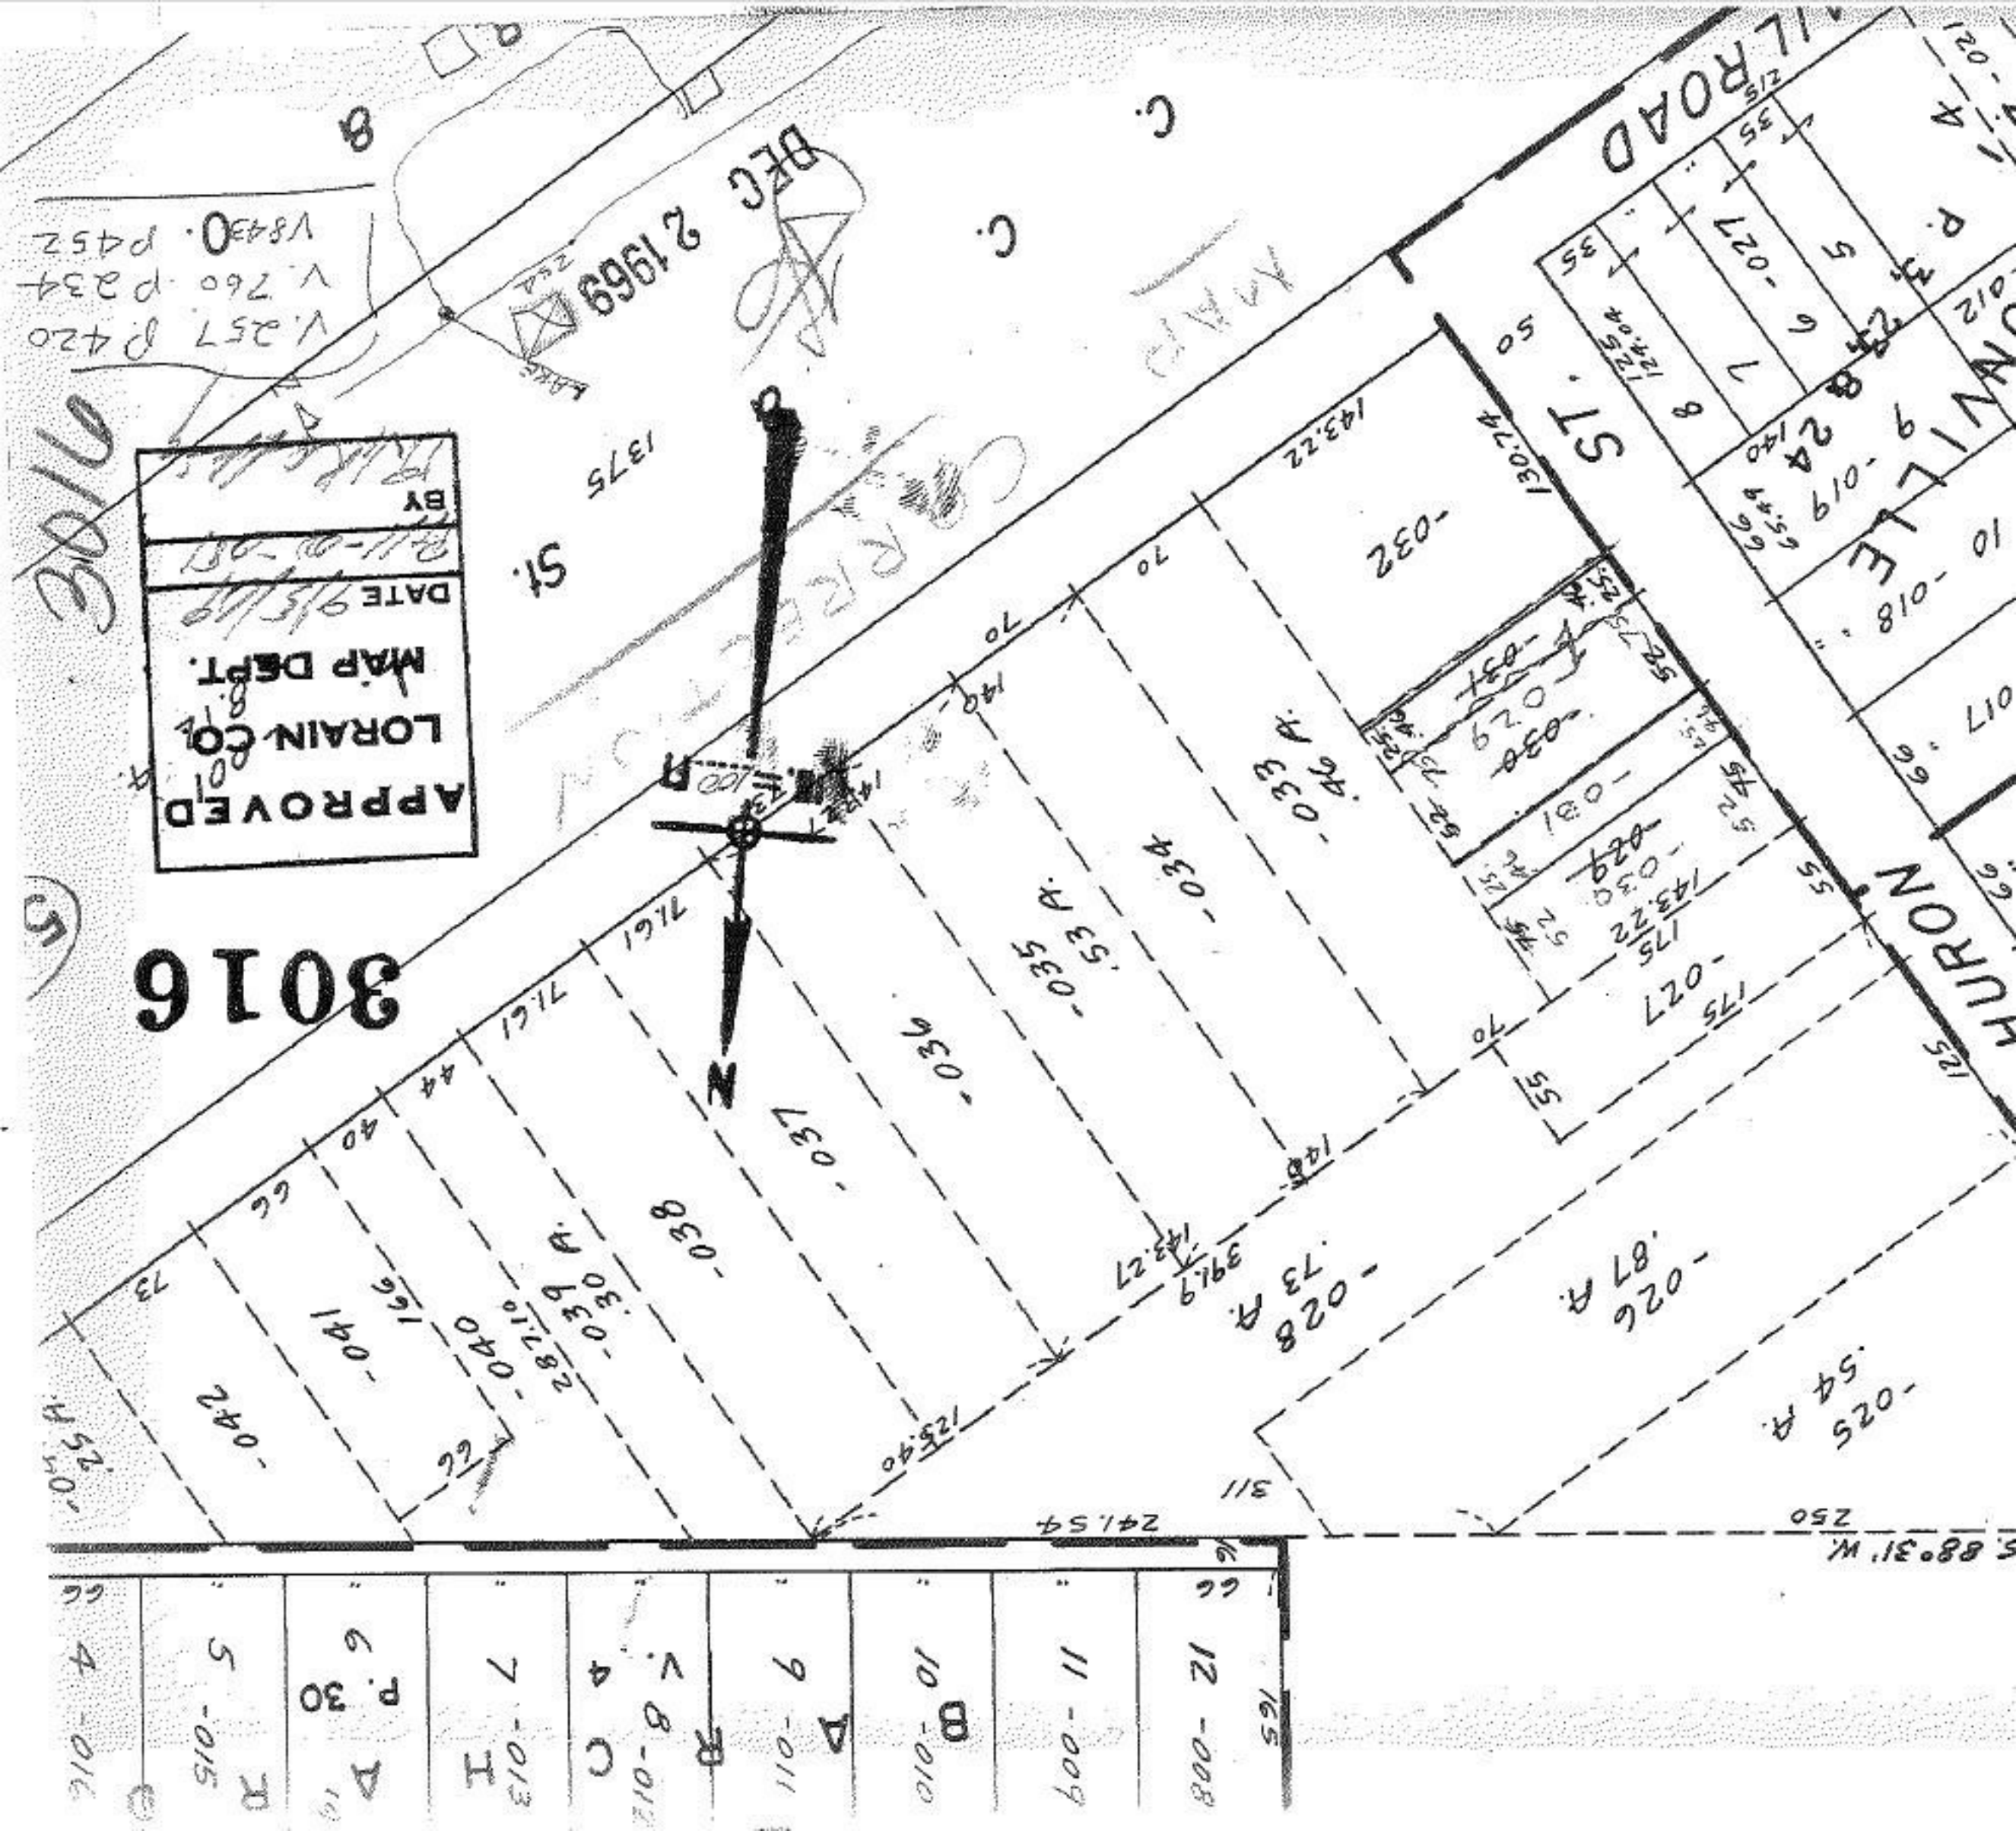
3016
APPROVED
LORAIN COL
MAP DEPT.
DATE
BY
DEC 2 1969
V. 257 P. 420
V. 760 P. 234
V. 8430 P. 452
ST.
ROAD
HURON
N
S 88°31' W.
250
241.54
311
143.22
130.74
140
70
125.40
143.27
391.9
288.1°
44
40
73
71.61
175
55
52
45
35
