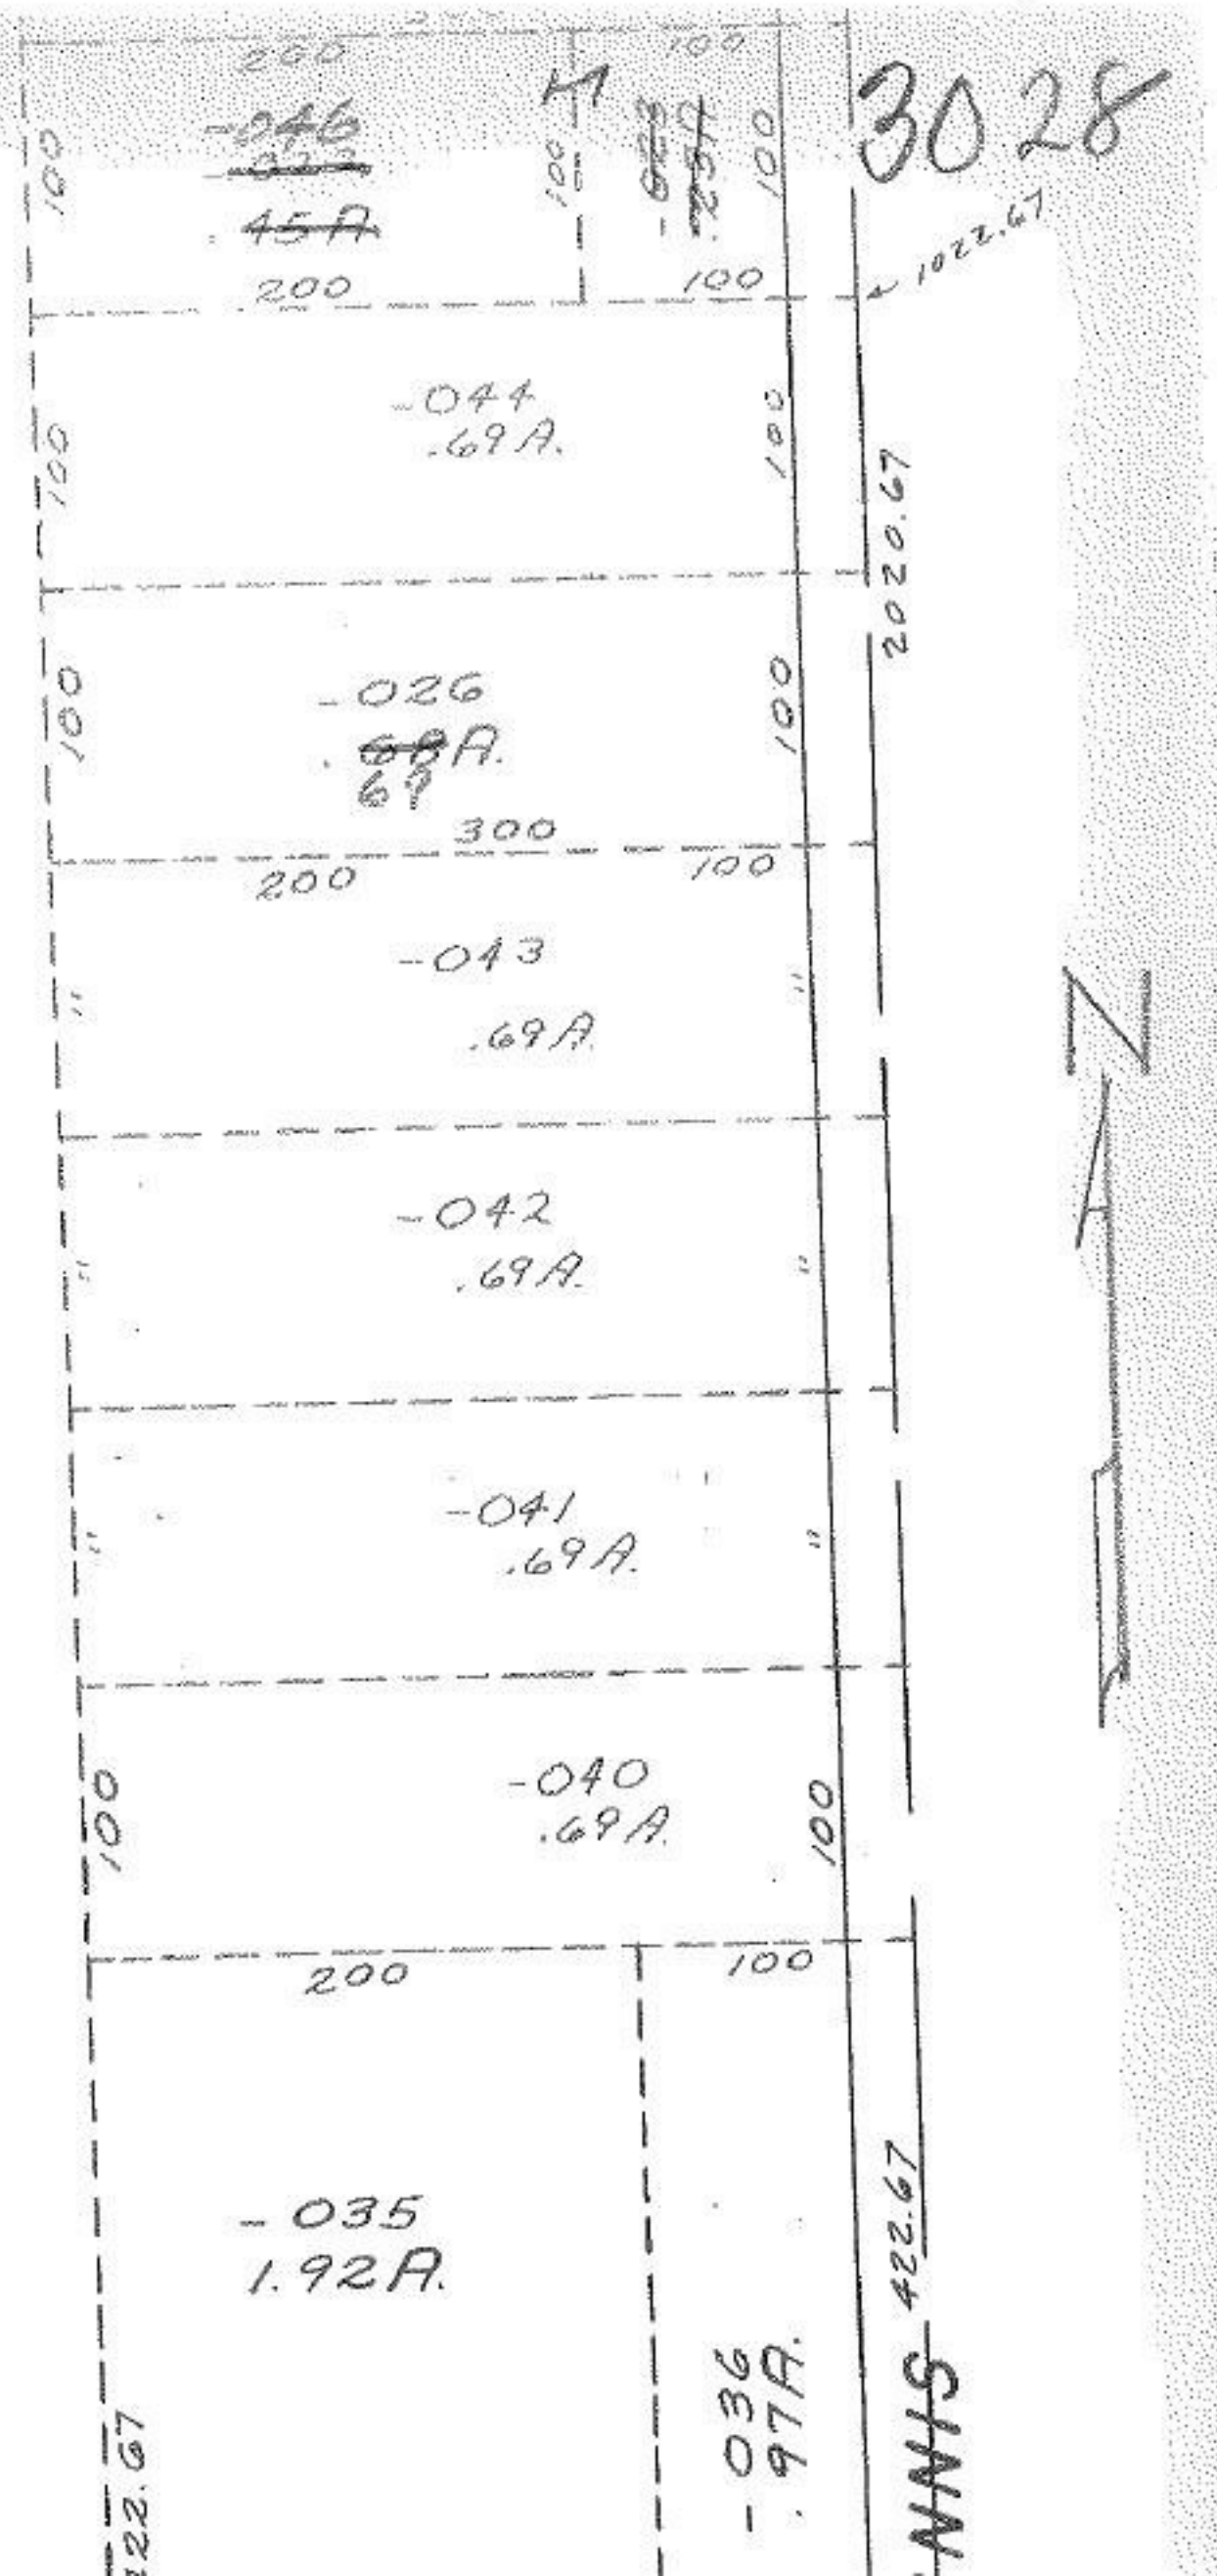

OCT 8 1969

3028

APPROVED
LORAIN CO.