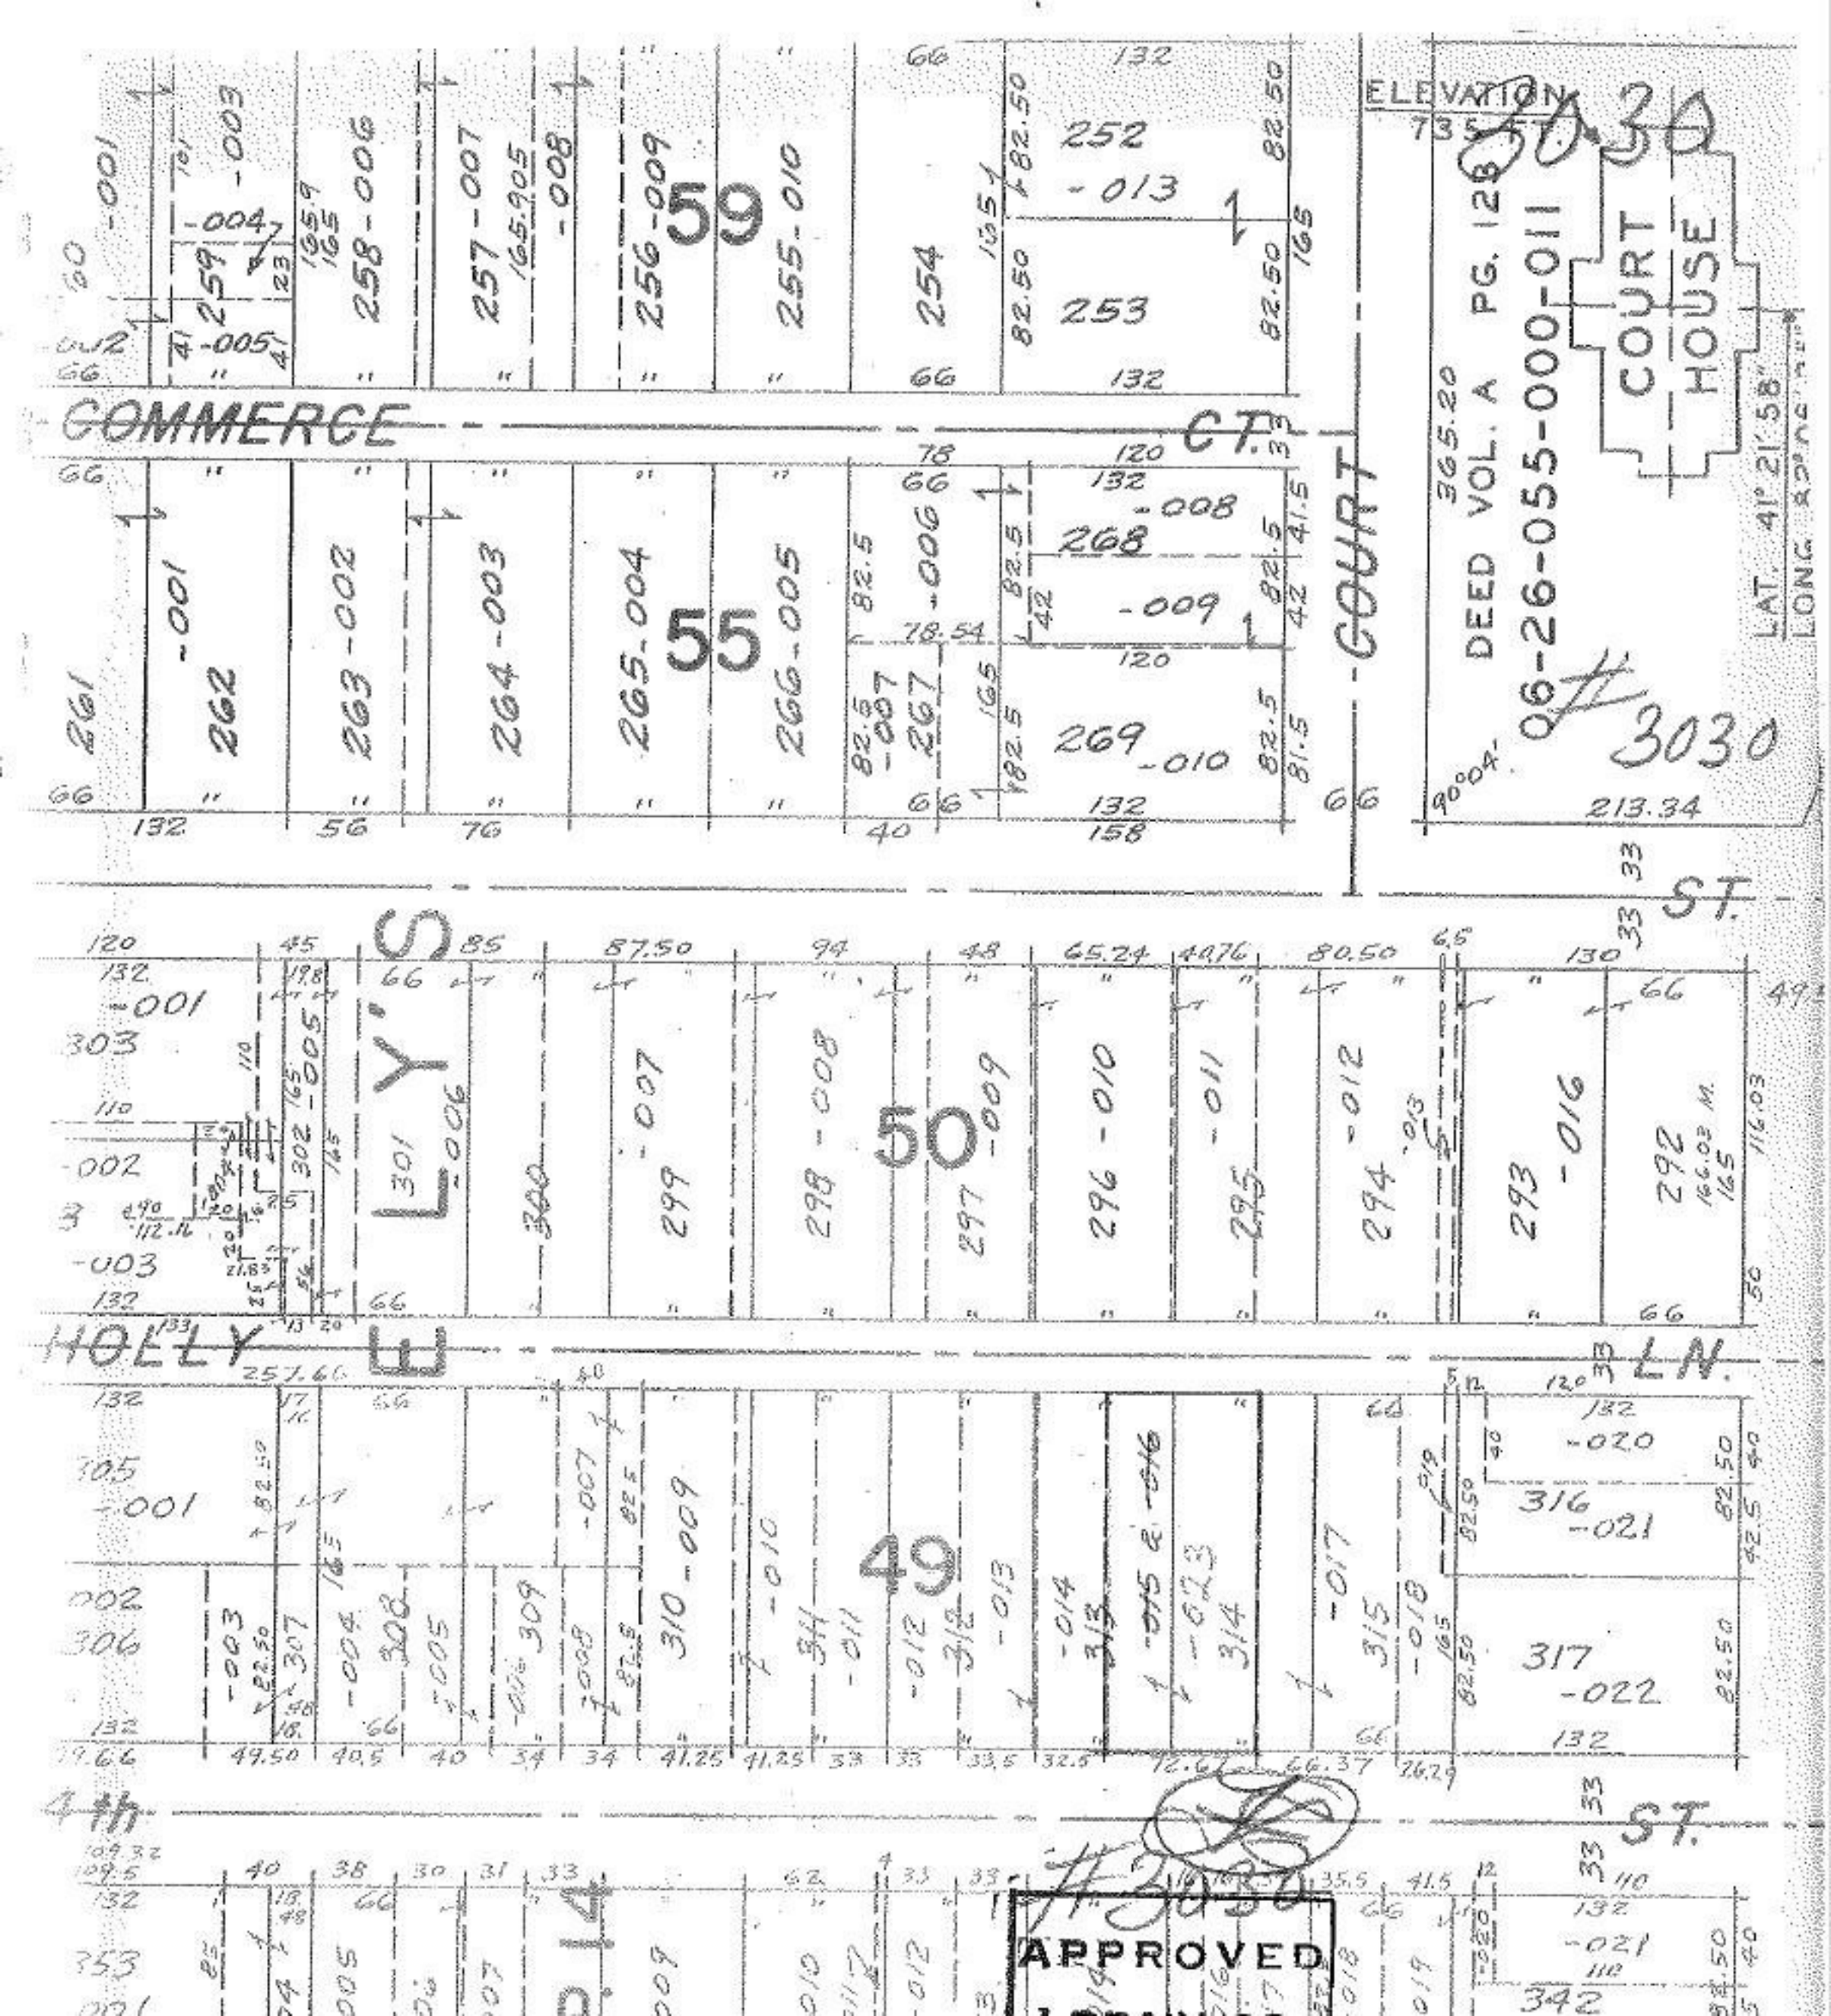

ELEVATION 735 FT.
3030
DEED VOL. A PG. 128
06-26-055-000-011
COURT HOUSE
LAT. 41° 21' 58"
LONG. 82° 06' 06"
#3030
COMMERCE CT.
COURT
ST.
59
55
50
49
LOLLY LN.
4th ST.
APPROVED